



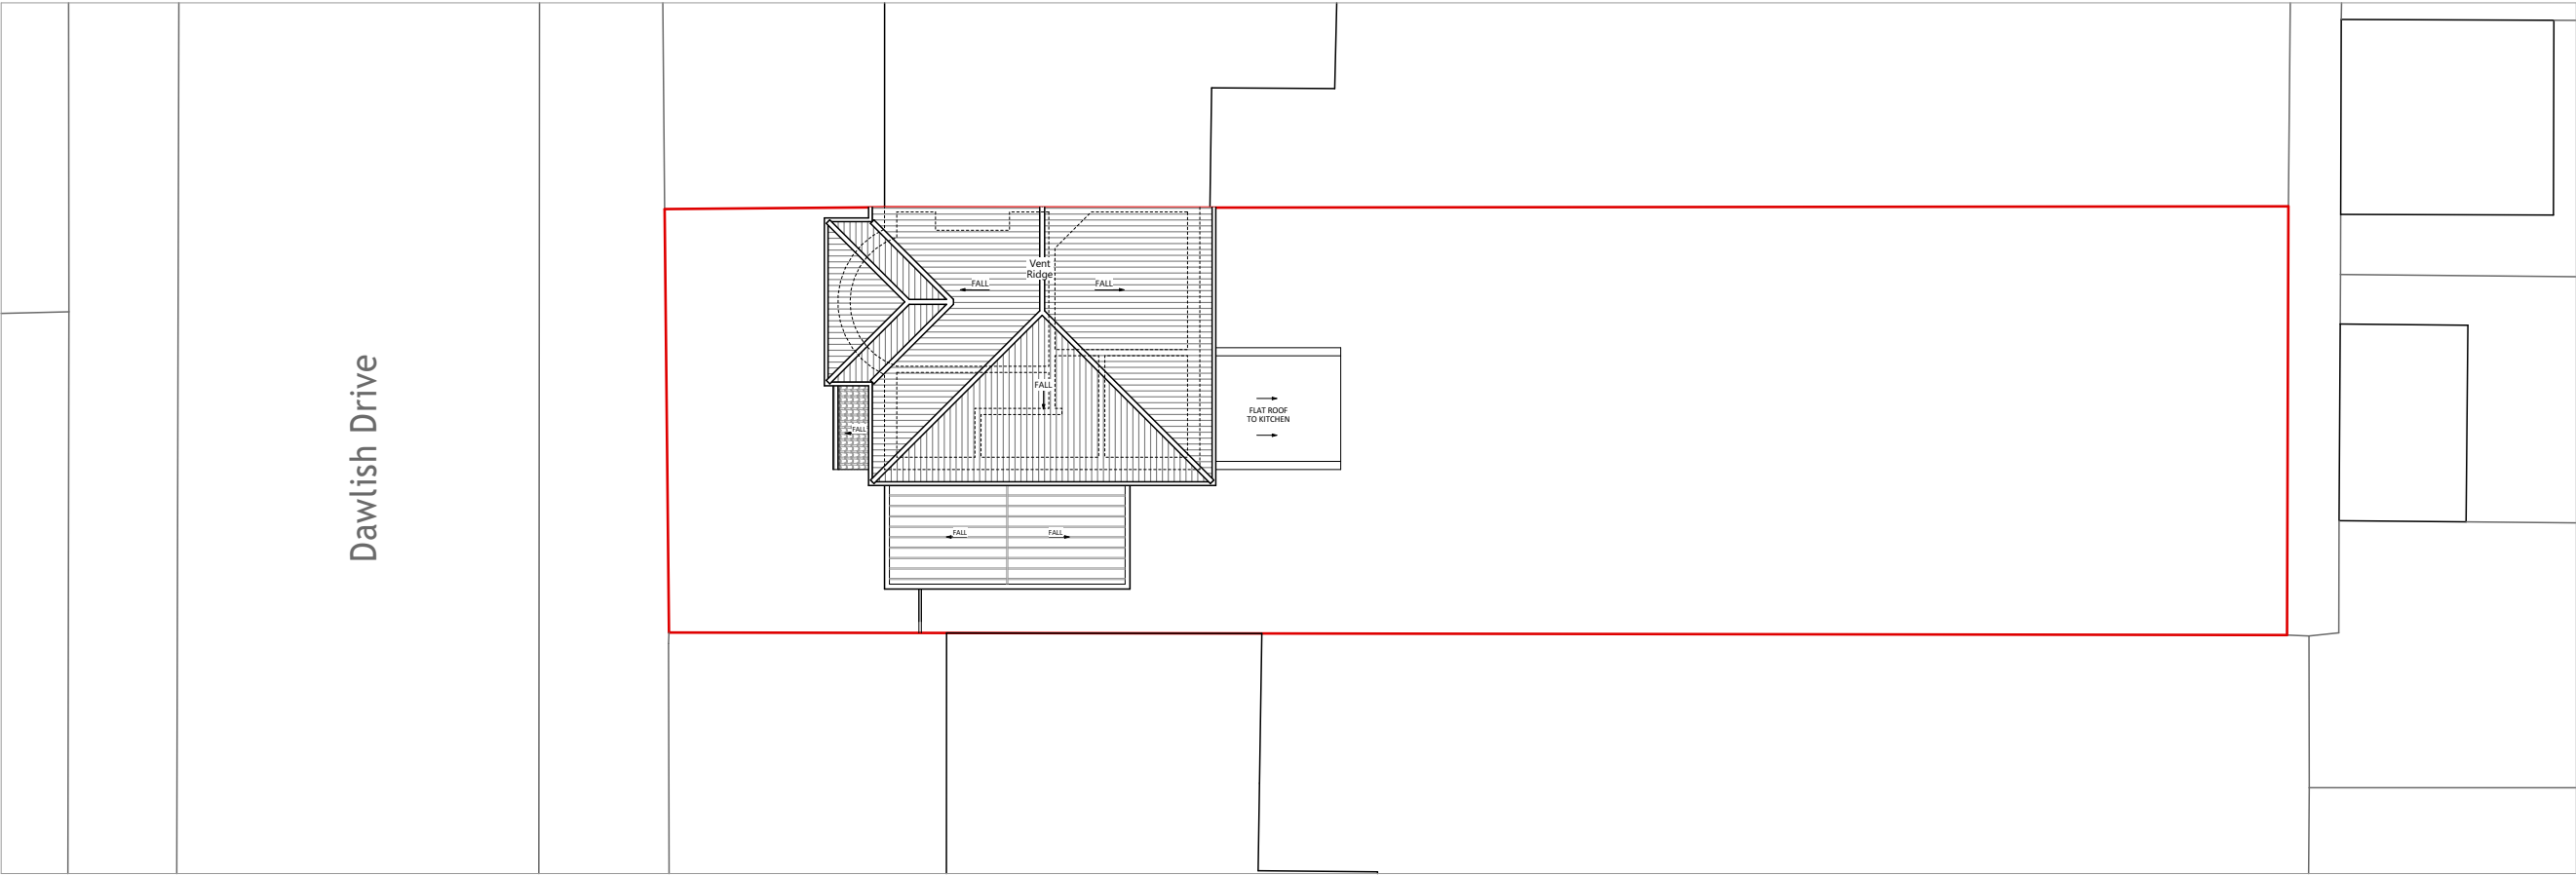


Existing Block Plan

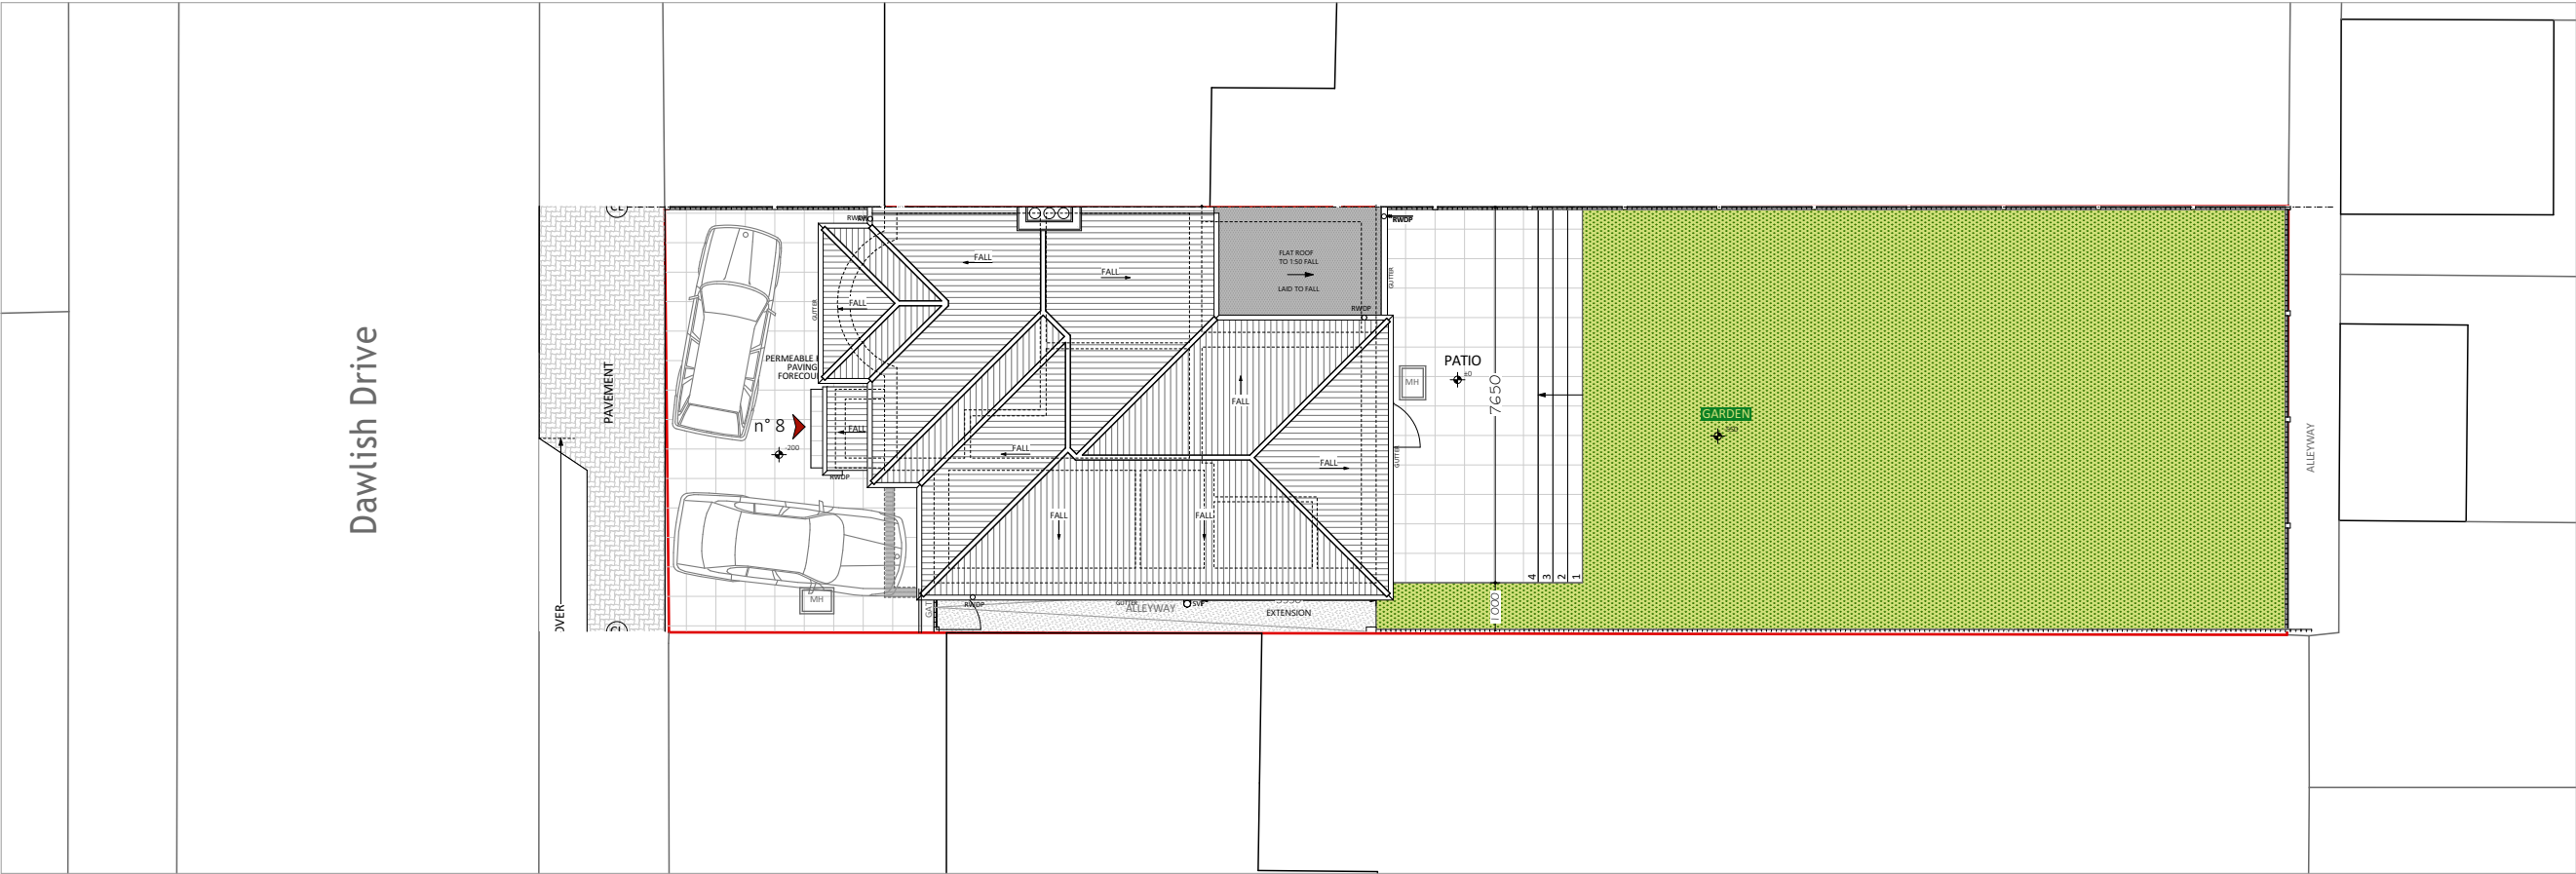

Proposed Site for Development

Key

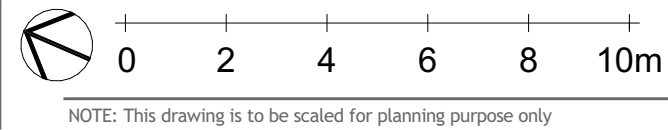

Status: RETROSPECTIVE - Planning
Scale: 1:150 @A3
Date: 28.10.2021

Drawings: Proposed Site for Development
Job No: REW/K21/01
Dwg No: E-06

Project: Part two storey, part single storey side/rear extensions
Address: 8 Dawlish Drive, Ruislip, Hillingdon HA4 9SD
Client: Mr Remon Wadie

Prepared by:

e: godfried.addo@gmail.com
t: +44 7825 537723