

Key

- 1- Rendered Cavity Blockwork
- 2- Double Glazed UPVC Windows /Door
- 3- Pitched Roof with Dark tiles
- 4- Asphalt Road laid to fall
- 5- 75/100 a UPVC Rain Water Pipe
- 6- Closeboard Timber boundary Fence
- 7- Permeable Paving
- 8- Soft Landscaping

Walls

- Existing
- New
- Demolition


Accommodation Schedule (m2) :

- Ground Floor | GIA :69.00
- Porch : 1.00
- Hallway : 1.00
- Lounge : 28.20
- Kitchen/Dining: 22.40
- Storage: 1.00
- WC: 1.75
- Study: 6.40

First Floor | GIA :58.20

- Landing : 5.50
- Bedroom 1: 15.00
- Bedroom 2: 7.30
- Bedroom 3: 10.70
- Bathroom : 2.75
- Bathrm : 2.60
- Bedroom 4: 7.50

Total GIA :127.20

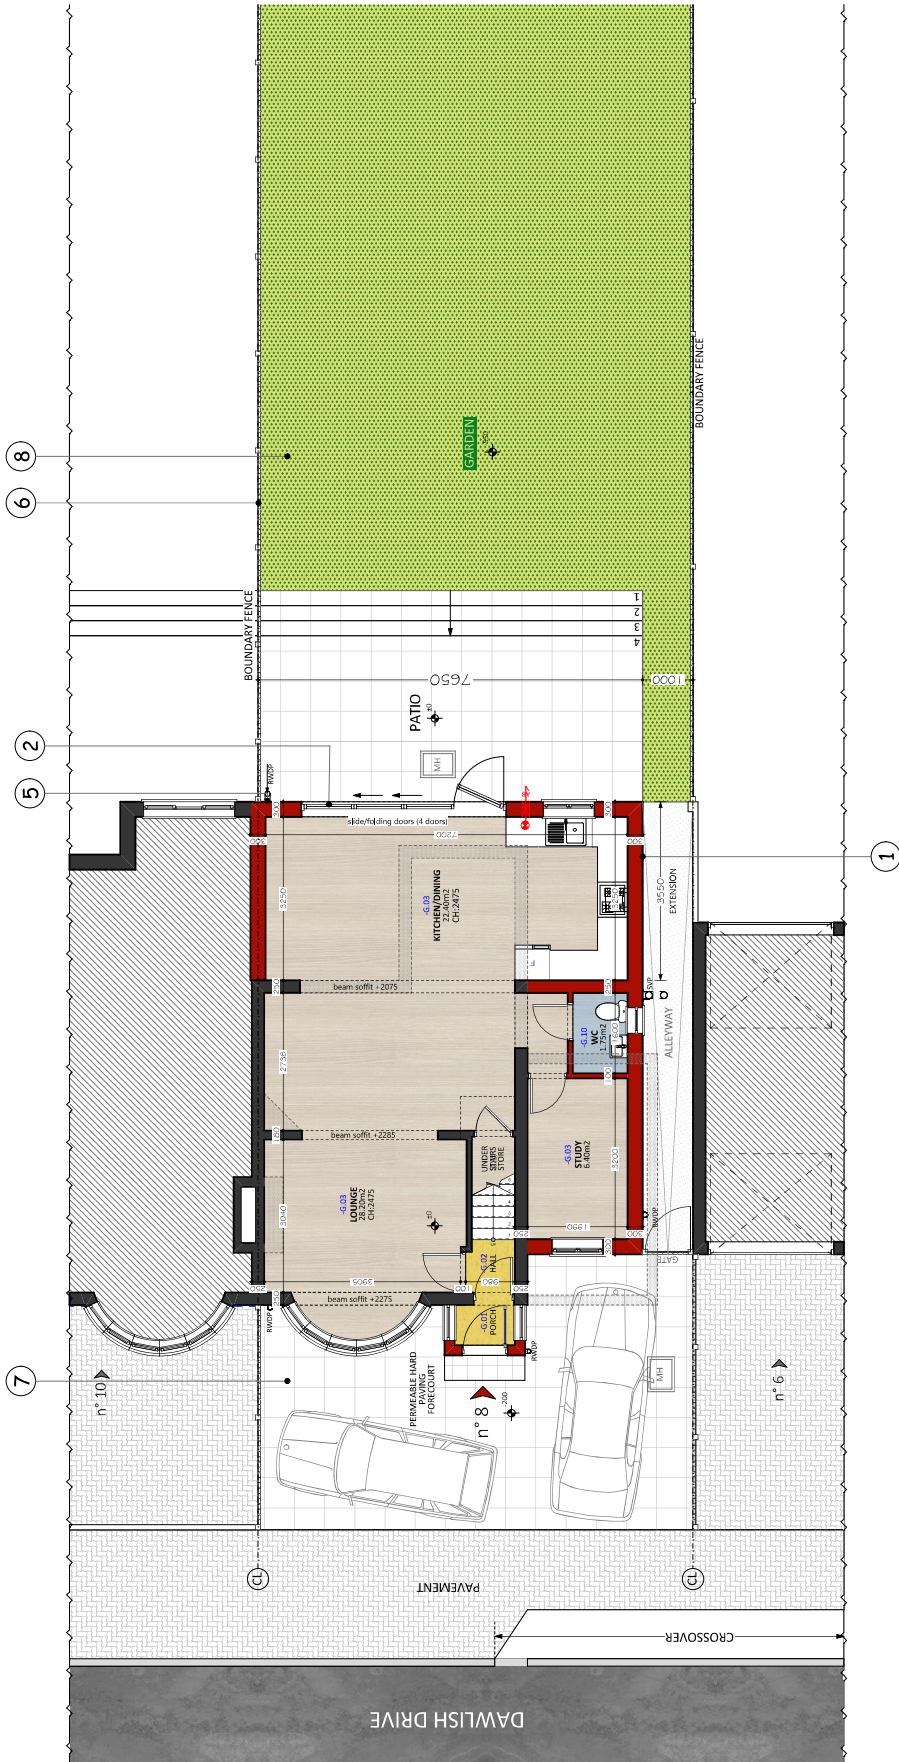

As-Built Ground Floor Plan



Status: RETROSPECTIVE - Planning

Scale: 1:100 @A3

NOTE: This drawing is to be scaled for planning purpose only

Date: 28.10.2021

Drawings: As-Built Ground Floor Plan

Job No: REW/K21/01

Project: Part two storey, part single storey

Address: side/rear extensions
8 Dawlish Drive, Ruislip, Hillingdon HA4 9SD

Client: Mr Remon Wadle

Prepared by:



EPK
PROPERTY SERVICES LTD
e: gpfriede.add@gmail.com
t: +44 7825 537713