

Key

- 1- Rendered Cavity Blockwork
- 2- Double Glazed UPVC Windows/Door
- 3- Pitched Roof with Dark tiles
- 4- Asphalt Roof laid to fall
- 5- 75/100 a UPVC Rain Water Pipe
- 6- Closeboard Timber boundary Fence
- 7- Permeable Paving
- 8- Soft Landscaping

Walls

- Existing
- New
- Demolition


Accommodation Schedule (m2) :

- Ground Floor | GIA :69.00
- Porch : 1.00
- Hallway : 1.00
- Lounge : 28.20
- Kitchen/Dining: 22.40
- Storage: 1.00
- WC: 1.75
- Study: 6.40

First Floor | GIA :58.20

- Landing : 5.50
- Bedroom 1: 15.00
- Bedroom 2: 7.30
- Bedroom 3: 10.70
- Bathroom : 2.75
- Bathrm : 2.60
- Bedroom 4: 7.50

Total GIA : 127.20

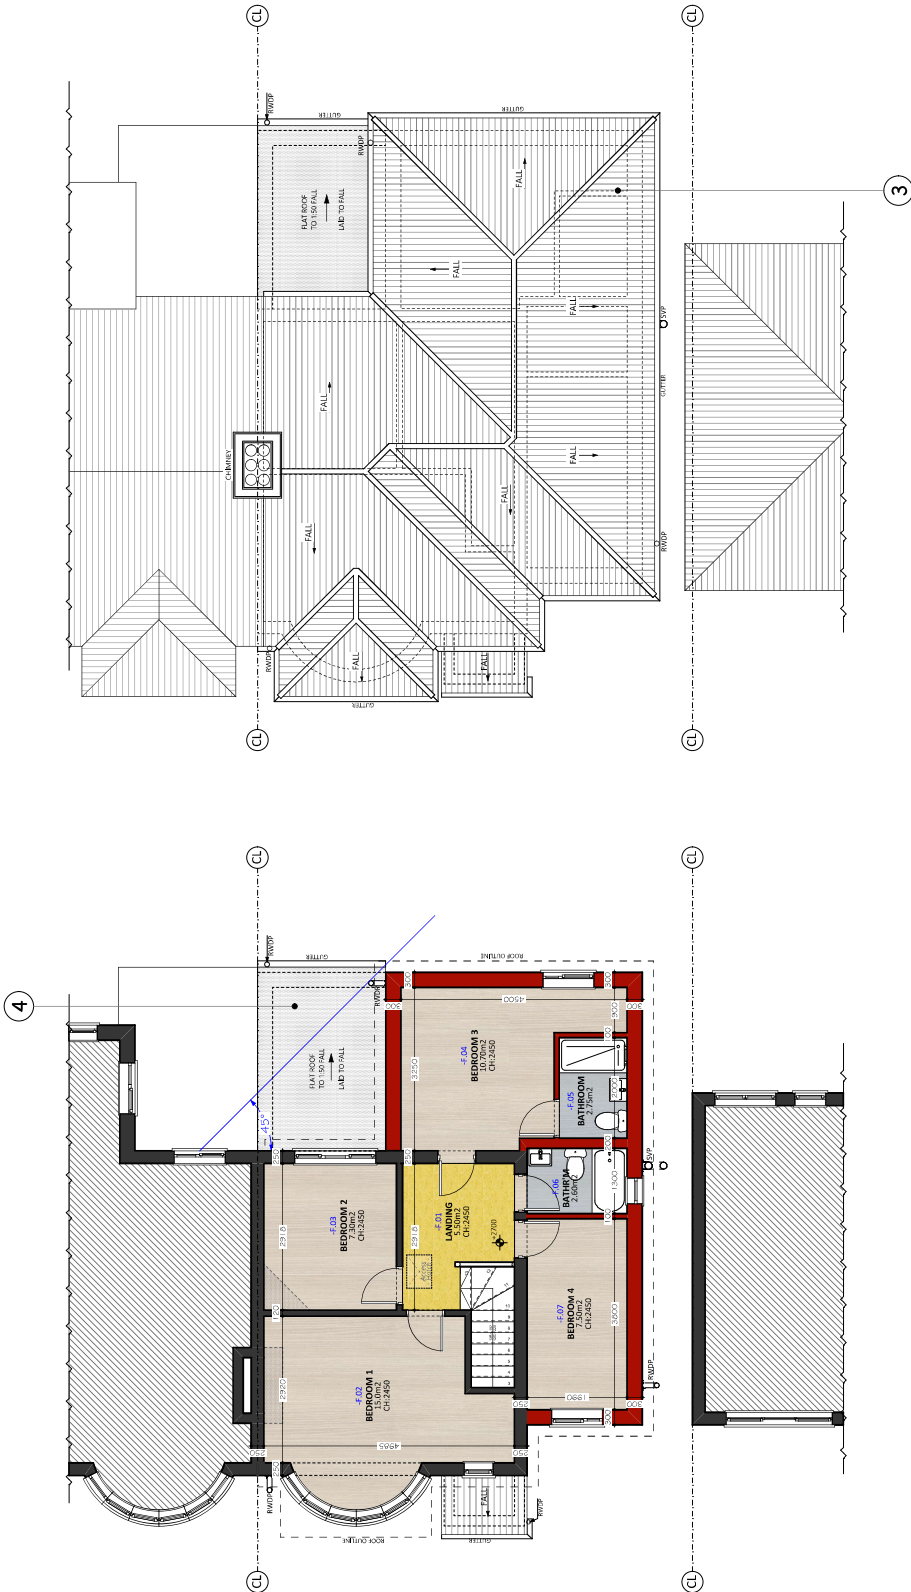

As-Built First Floor Plan

As-Built Roof Layout



Status: RETROSPECTIVE - Planning
Scale: 1:100 @A3

NOTE: This drawing is to be scaled for planning purpose only

Date: 28.10.2021

Drawings: As-Built First Floor Plan and Roof Layout
Job No: REW/K21/01

Dwg No: E-08

Project: Part two storey, part single storey side/rear extensions
Address: 8 Dawlish Drive, Ruislip, Hillingdon HA4 9SD

Client: Mr Remon Wadle



Prepared by:

e: gpfriede.add@gmail.com
t: +44 7835 537713