



Key

- 1- Rendered Cavity Blockwork
- 2- Double Glazed UPVC Windows/Door
- 3- Pitched Roof with Dark tiles
- 4- Asphalt Roof laid to fall
- 5- 75/100 a UPVC Rain Water Pipe
- 6- Closeboard Timber boundary Fence
- 7- Permeable Paving
- 8- Soft Landscaping

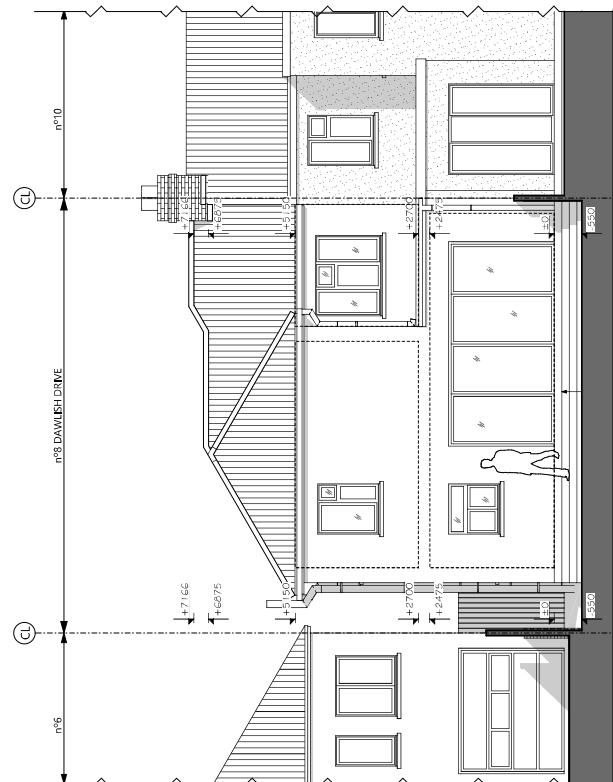

As-Built Rear South Elevation

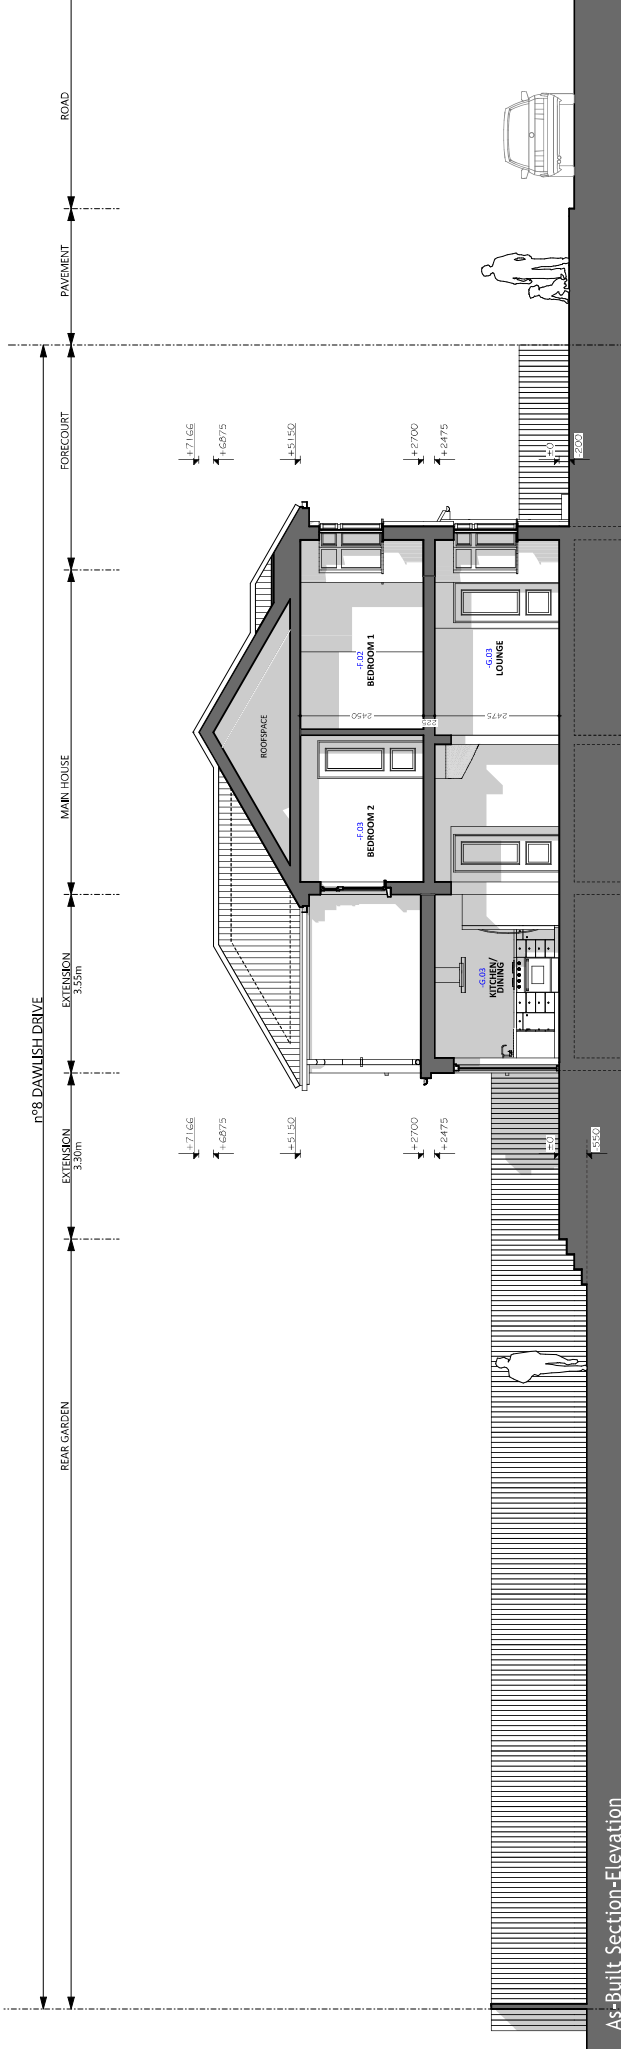

As-Built Section-Elevation

012345

012345m

RETROSPECTIVE - Planning
Scale: 1:100 @A3

Status:
Scale:
Date: 28.10.2021

Drawings: Proposed Section AA
Job No: REW/K21/01

Project: Part two storey, part single storey side/rear extensions
Address: 8 Dawlish Drive, Ruislip, Hillingdon HA4 9SD

Dwg No: E-010
Client: Mr Remon Wadle

Prepared by:

EPK PROPERTY SERVICES LTD
e: sofrieda.add@gmail.com
t: +44 7825 577723

NOTE: This drawing is to be scaled for planning purpose only