


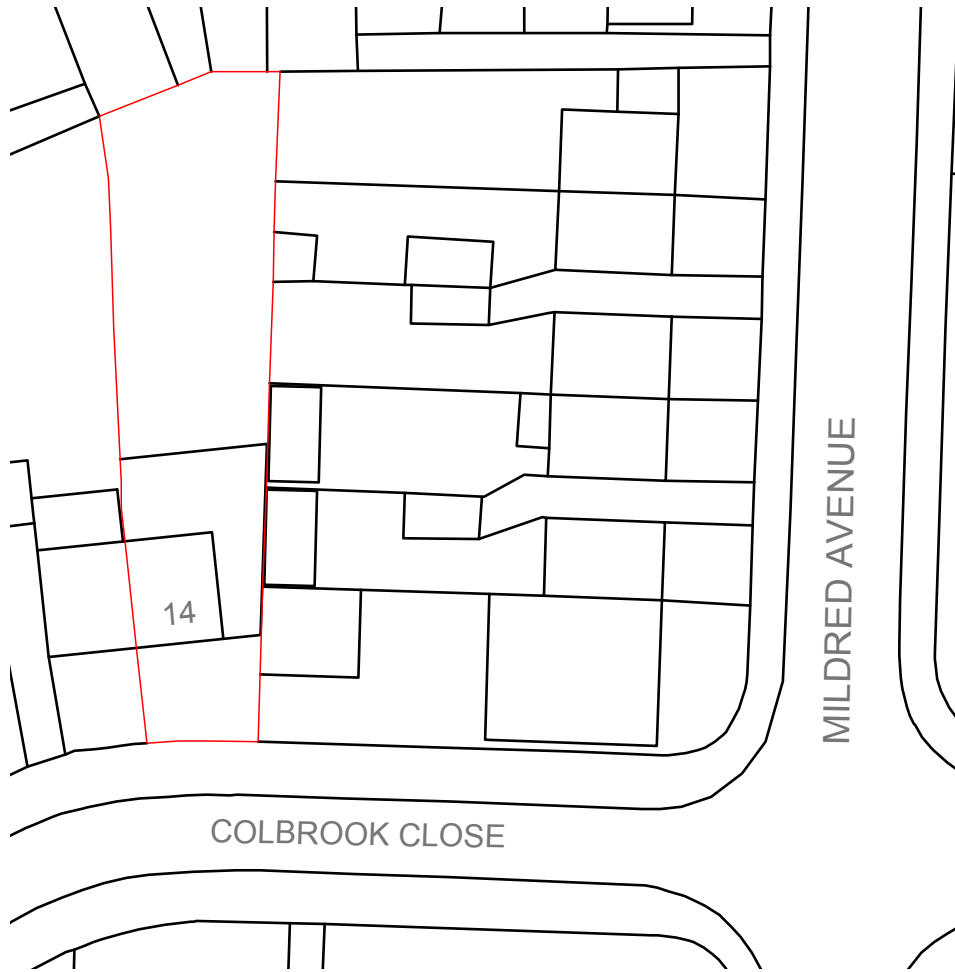


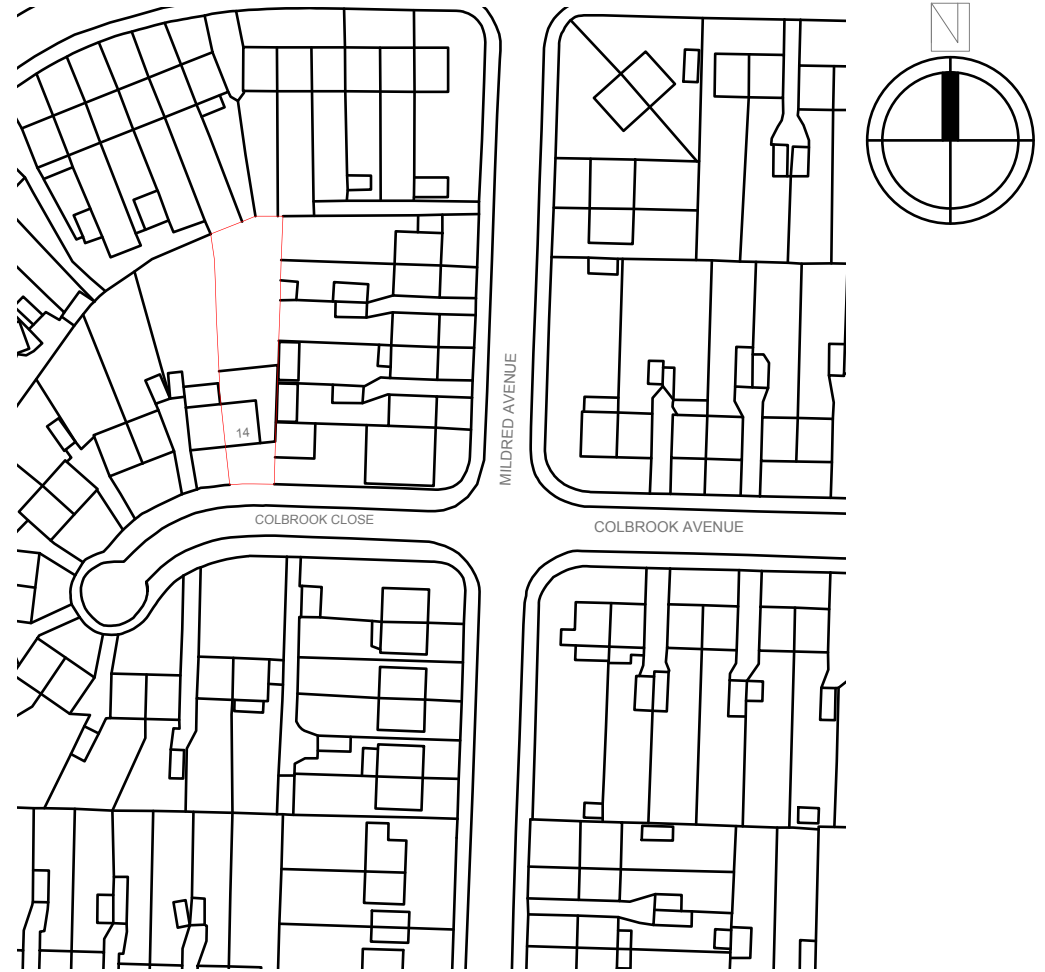



BLOCK PLAN 1:500

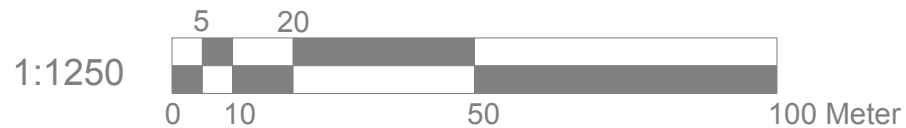


LOCATION PLAN 1:1250


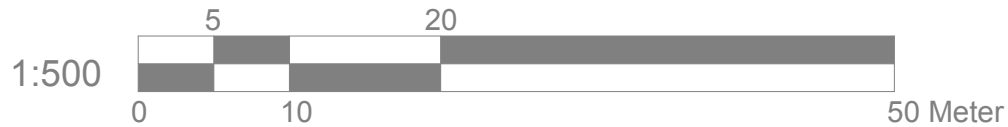


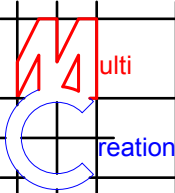
	Project:	Title:	Scale: 1:500/1250 @ A4
	14 Colbrook Close	Block plan	Date: Jan 2017
	Hayes	Location plan	Drawing No.: 3173-01/SP
	UB3 1TH		Revision
239 Western Road, Southall, Middx, UB2 5HS Tel: 020 8571 1369 info@multicreation.co.uk			

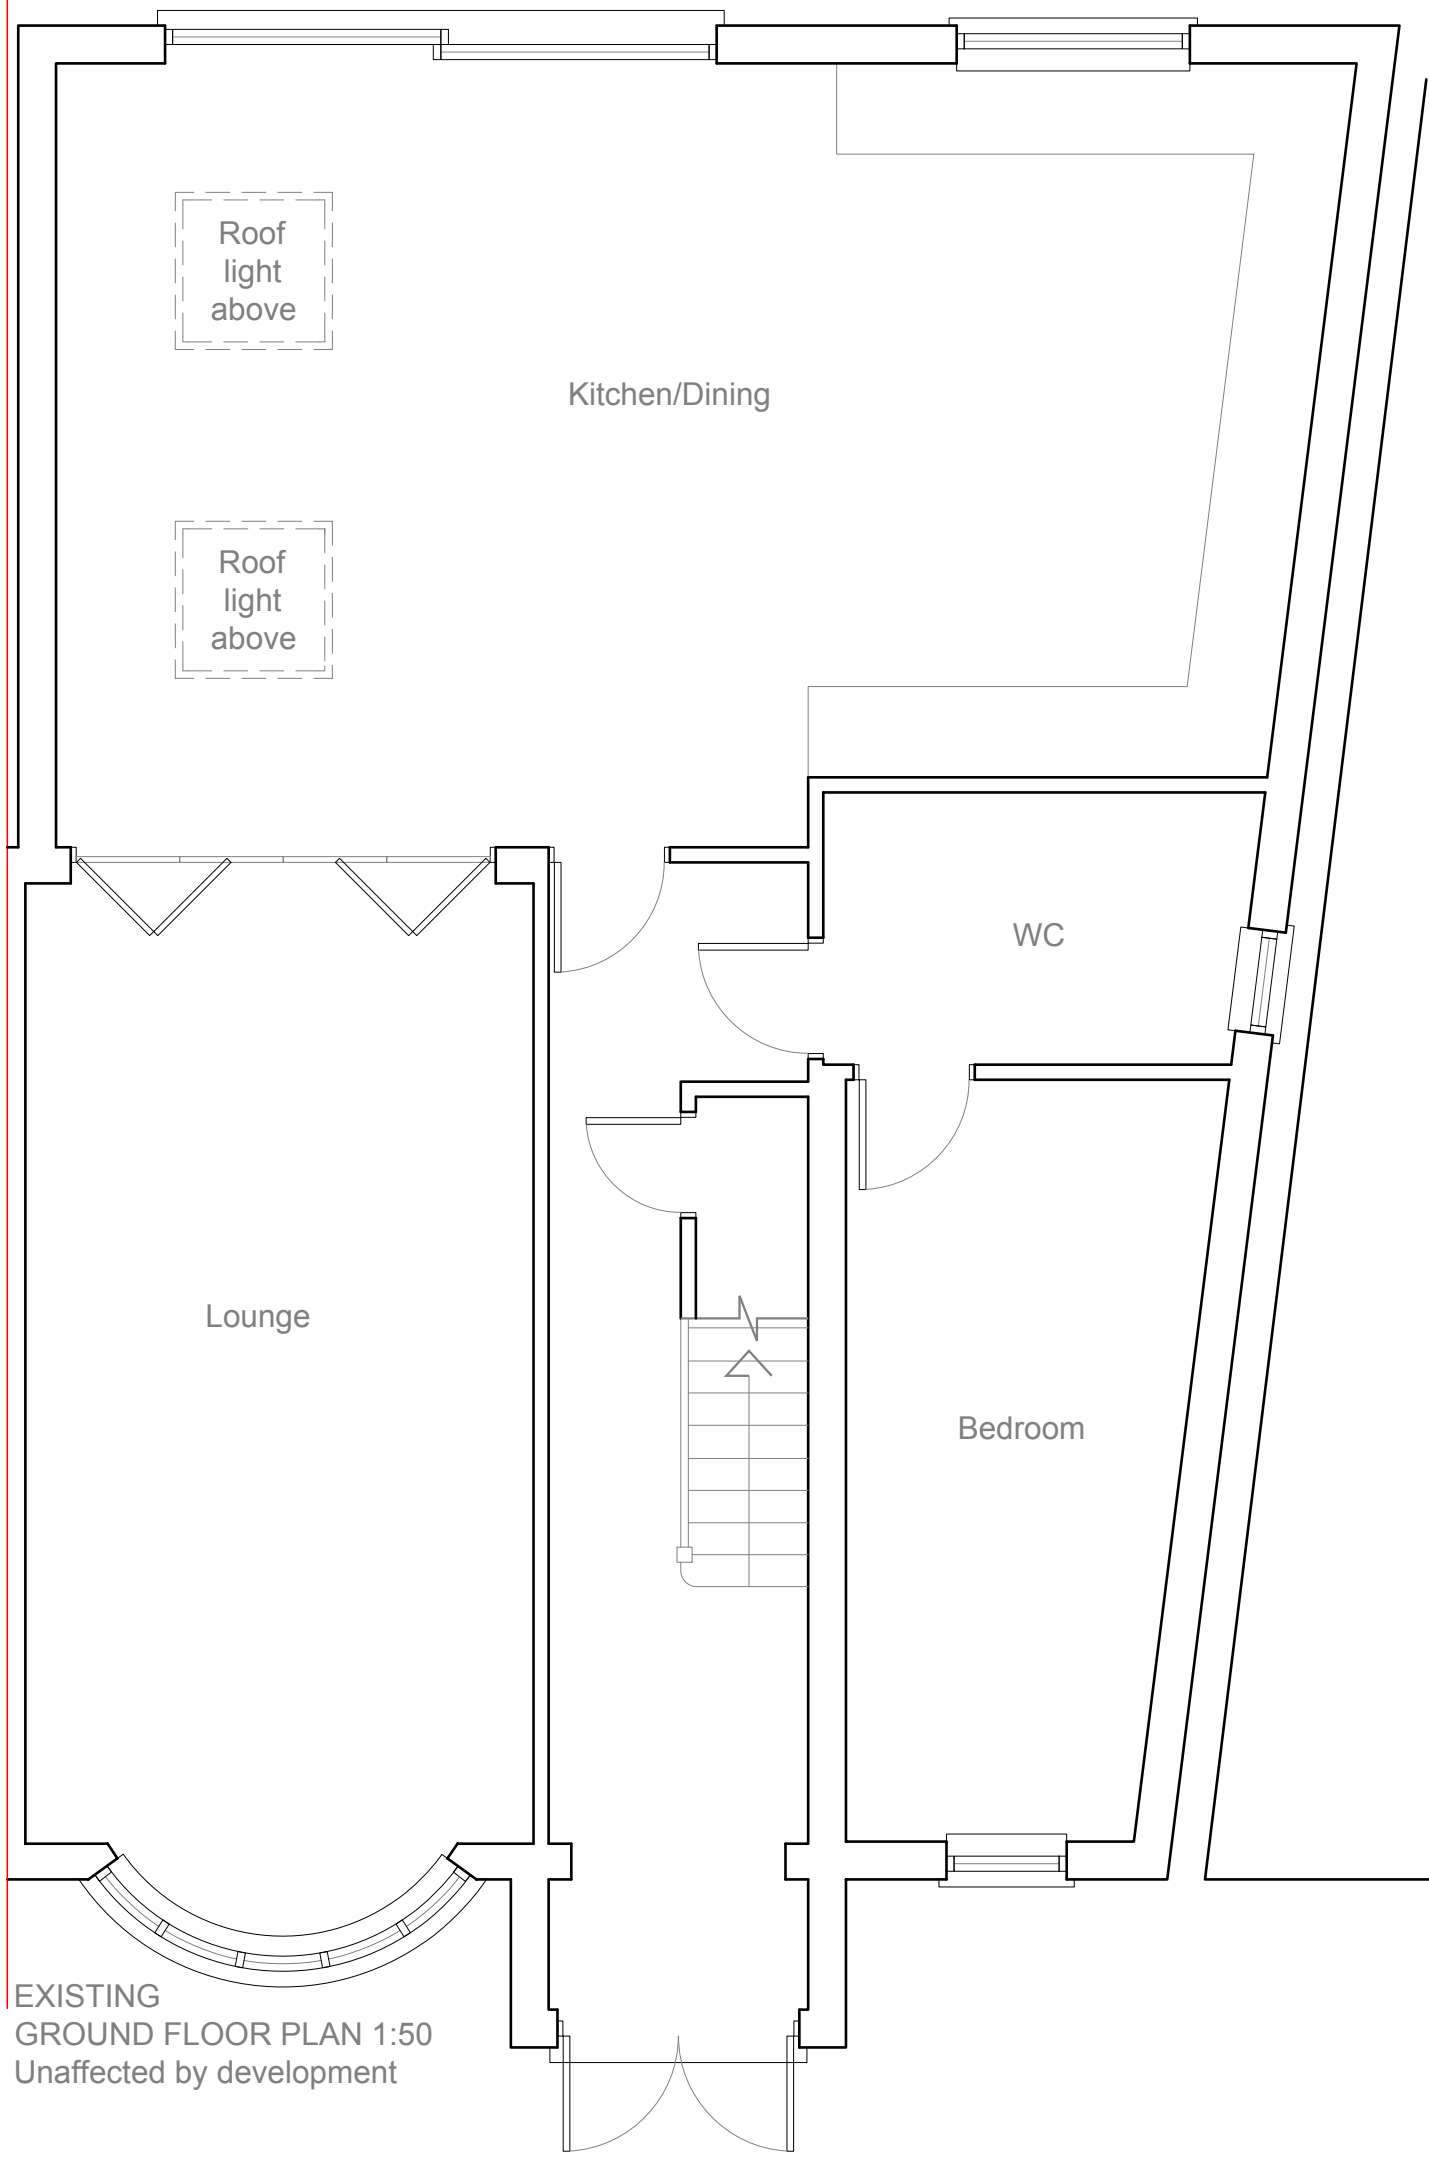


EXISTING
GROUND FLOOR PLAN 1:50
Unaffected by development

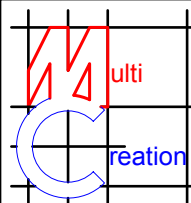
	Project:	Title:	Scale: 1:50 @ A3
	14 Colbrook Close	Existing	Date: Jan 2017
	Hayes	Ground floor plan	Drawing No.: 3173-02/SP
	UB3 1TH		Revision
239 Western Road, Southall, Middx, UB2 5HS Tel: 020 8571 1369 info@multicreation.co.uk			

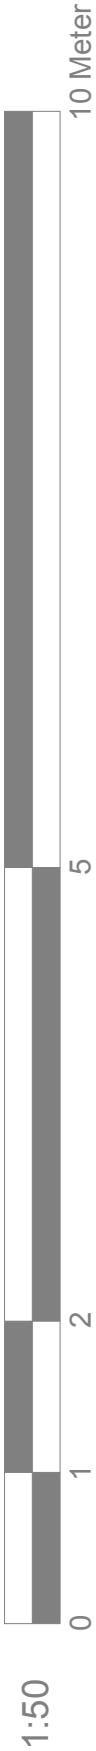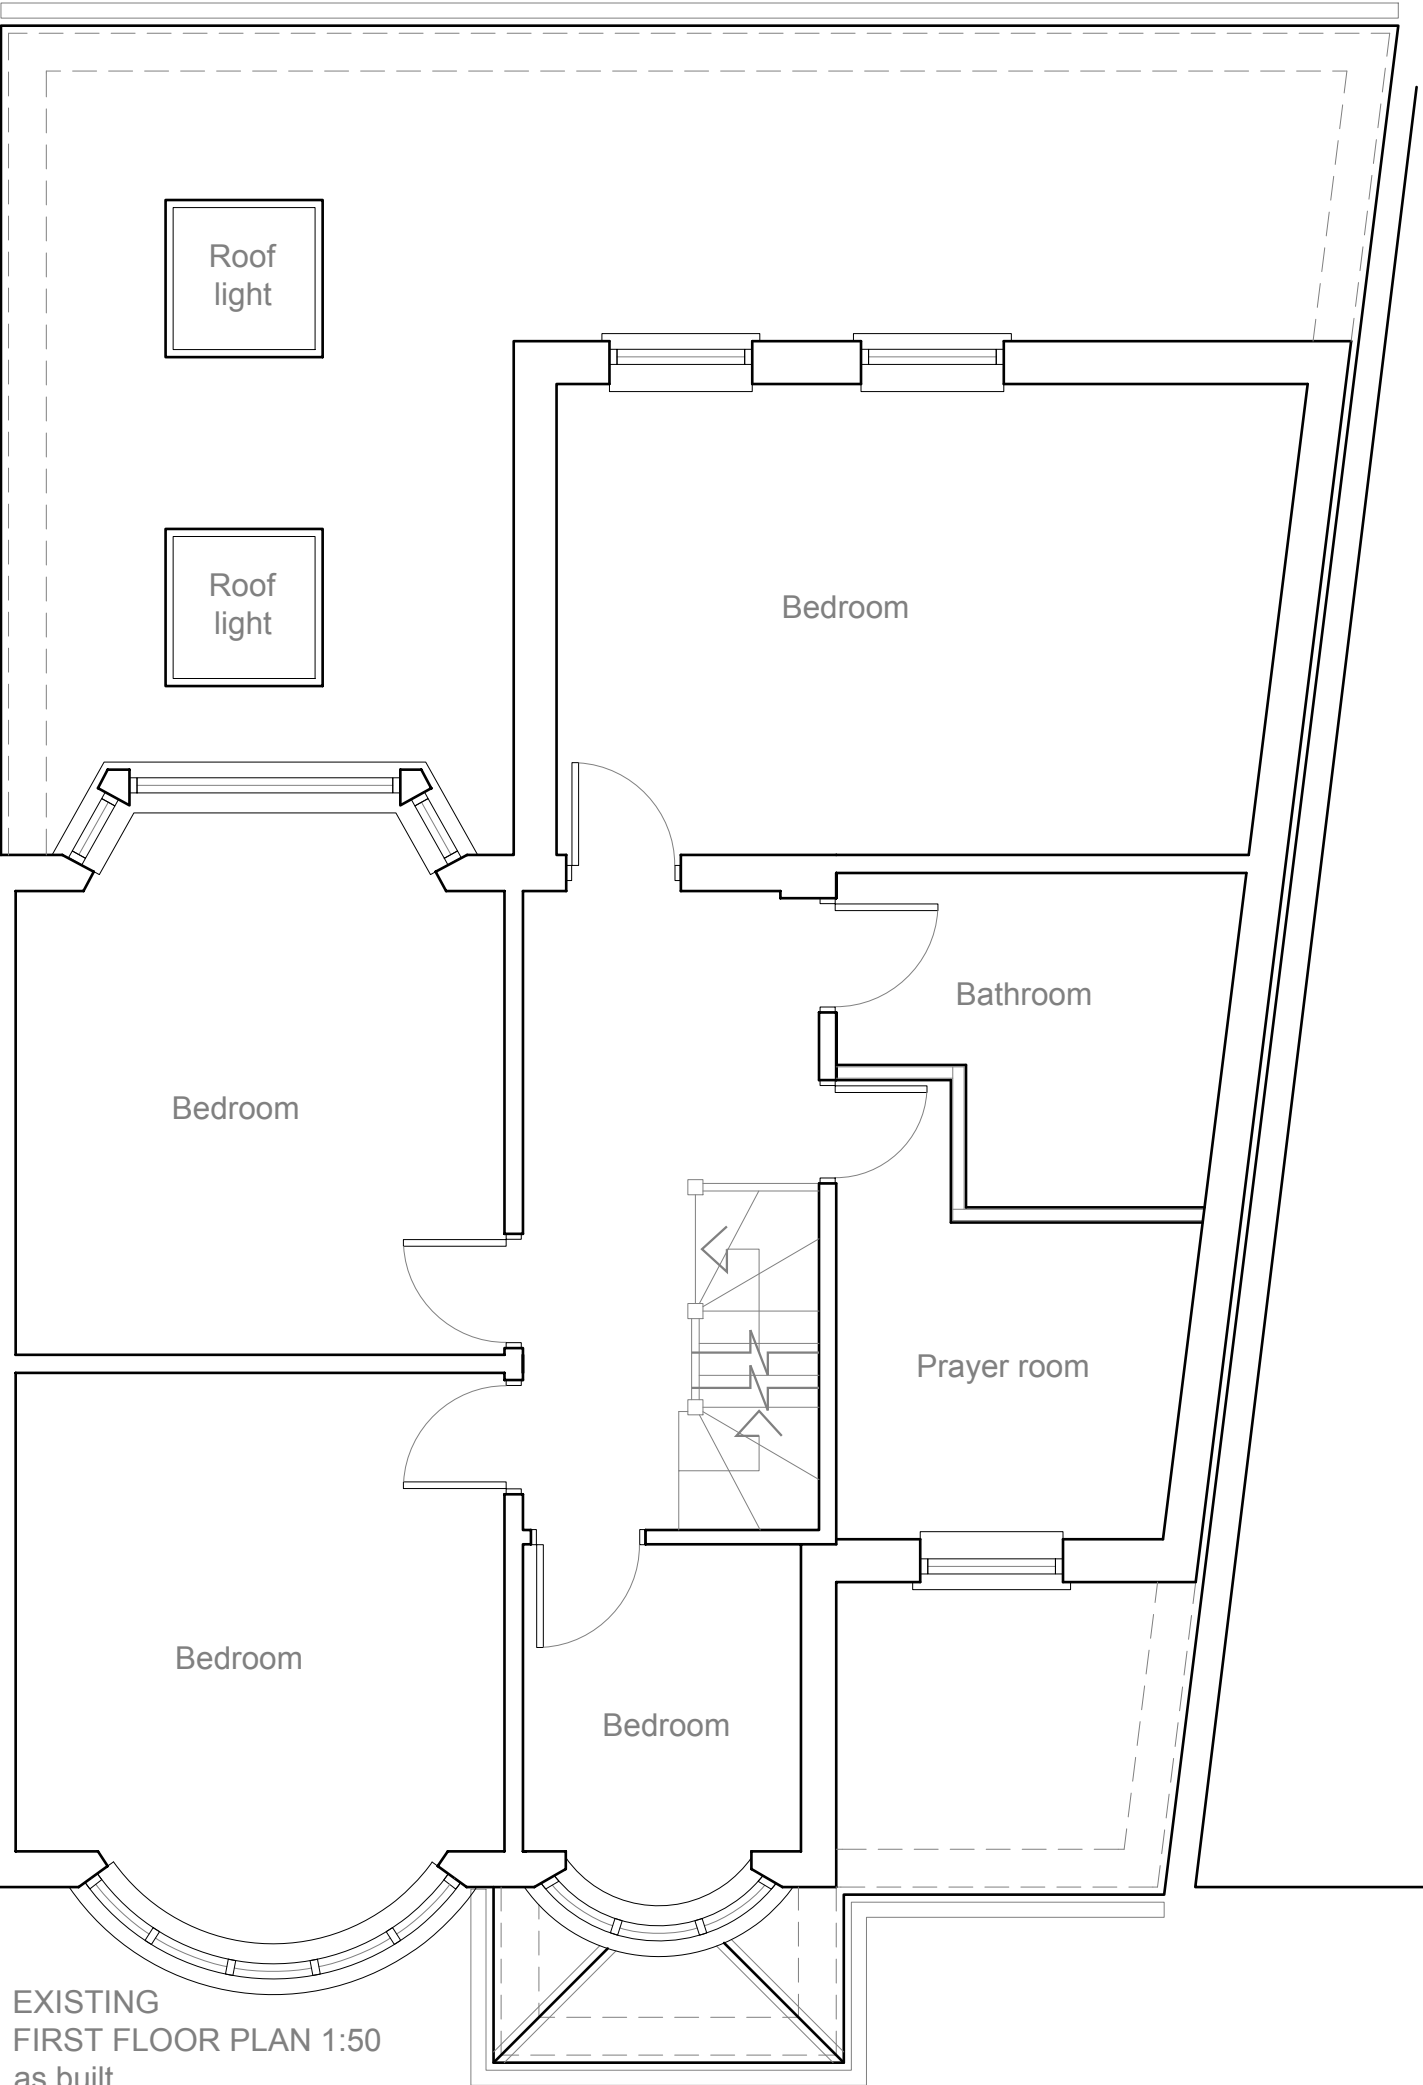

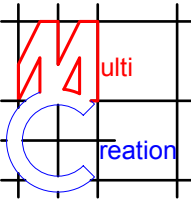	Project:	Title:	Scale: 1:50 @ A3
	14 Colbrook Close	Existing	Date: Jan 2017
	Hayes	First floor plan	Drawing No.: 3173-03/SP
	UB3 1TH	AS BUILT	Revision
239 Western Road, Southall, Middx, UB2 5HS Tel: 020 8571 1369 info@multicreation.co.uk			

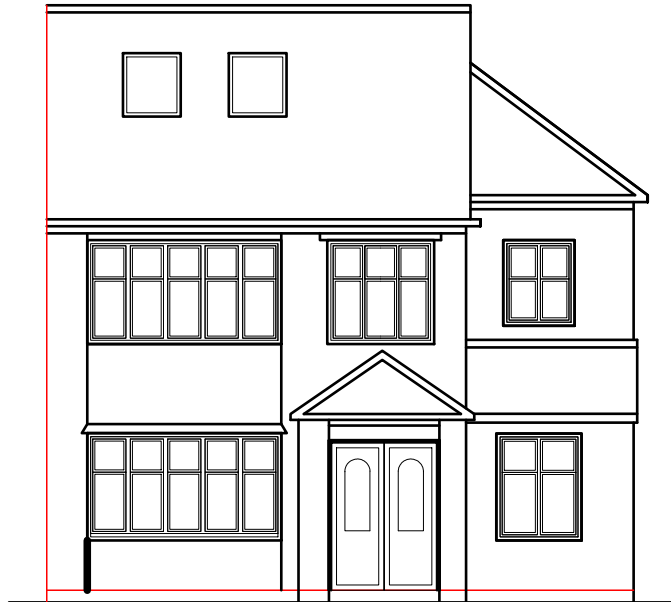


EXISTING
FRONT ELEVATION 1:100

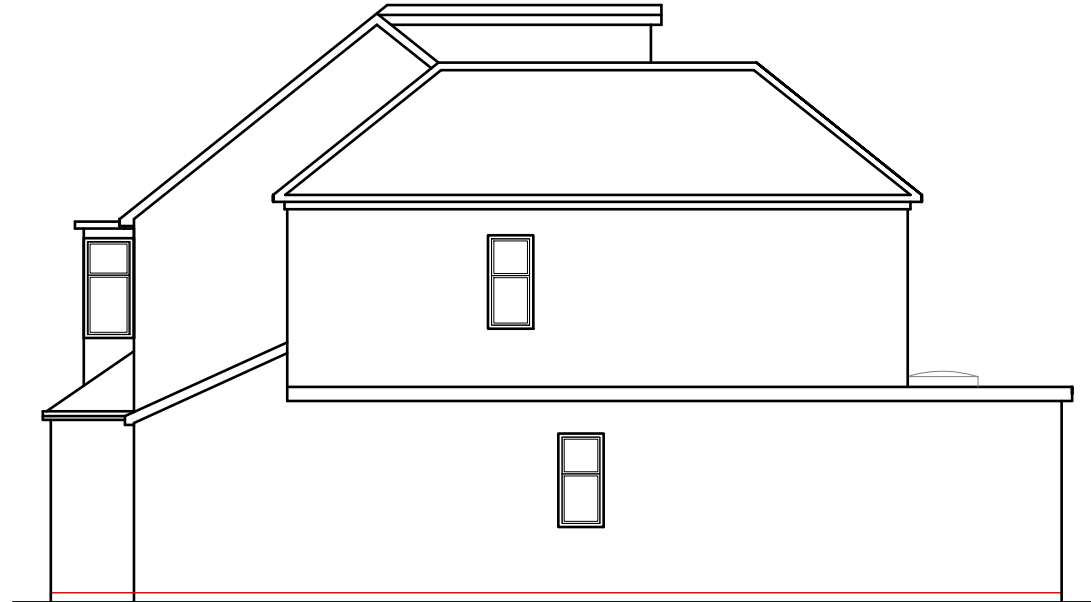

EXISTING
SIDE ELEVATION 1:100




EXISTING
REAR ELEVATION 1:100

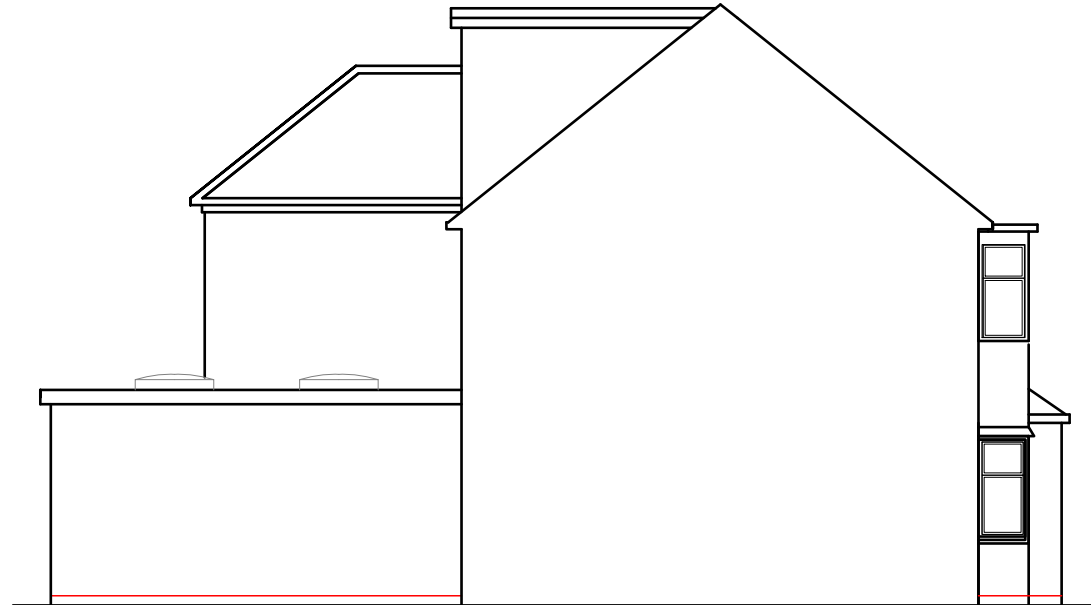




EXISTING
SIDE ELEVATION 1:100




	Project:	Title:	Scale: 1:100 @ A3
	14 Colbrook Close	Existing	Date: Jan 2017
	Hayes	Elevations	Drawing No.: 3173-04/SP
	UB3 1TH		Revision
239 Western Road, Southall, Middx, UB2 5HS Tel: 020 8571 1369 info@multicreation.co.uk			

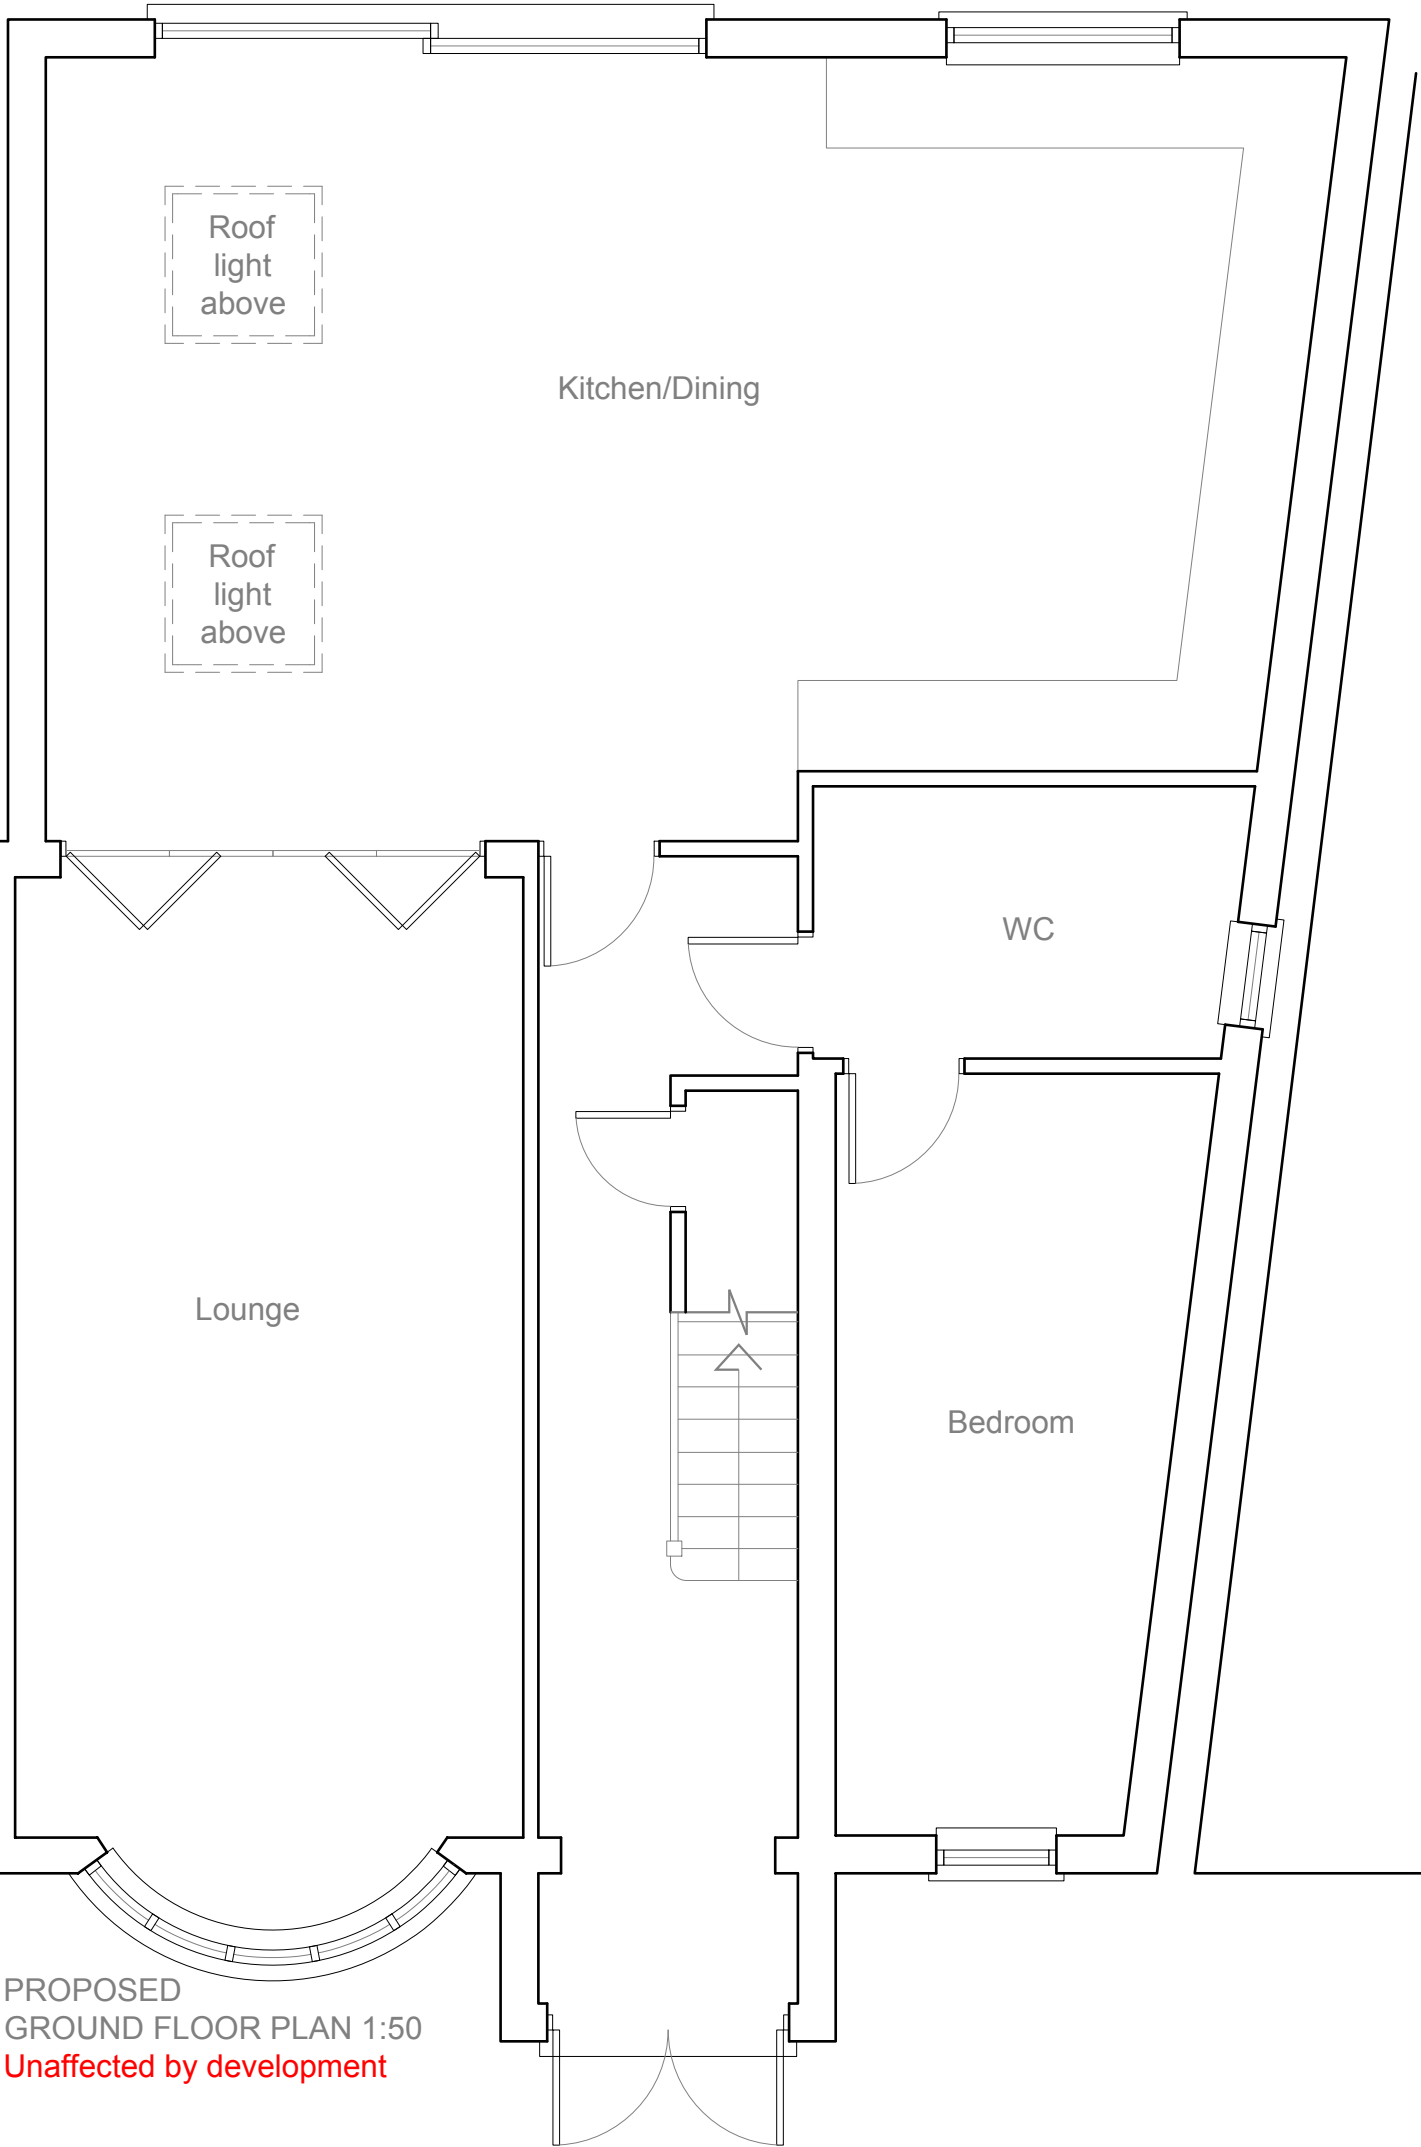

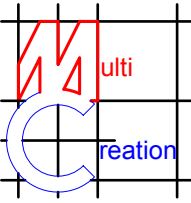
	Project:	Title:	Scale: 1:50 @ A3
	14 Colbrook Close	Proposed	Date: Jan 2017
	Hayes	Ground floor plan	Drawing No.: 3173-05/SP
	UB3 1TH		Revision
239 Western Road, Southall, Middx, UB2 5HS Tel: 020 8571 1369 info@multicreation.co.uk			

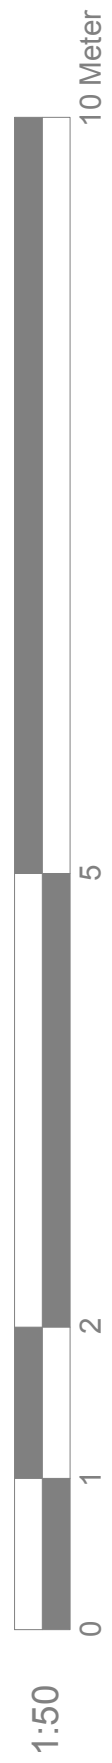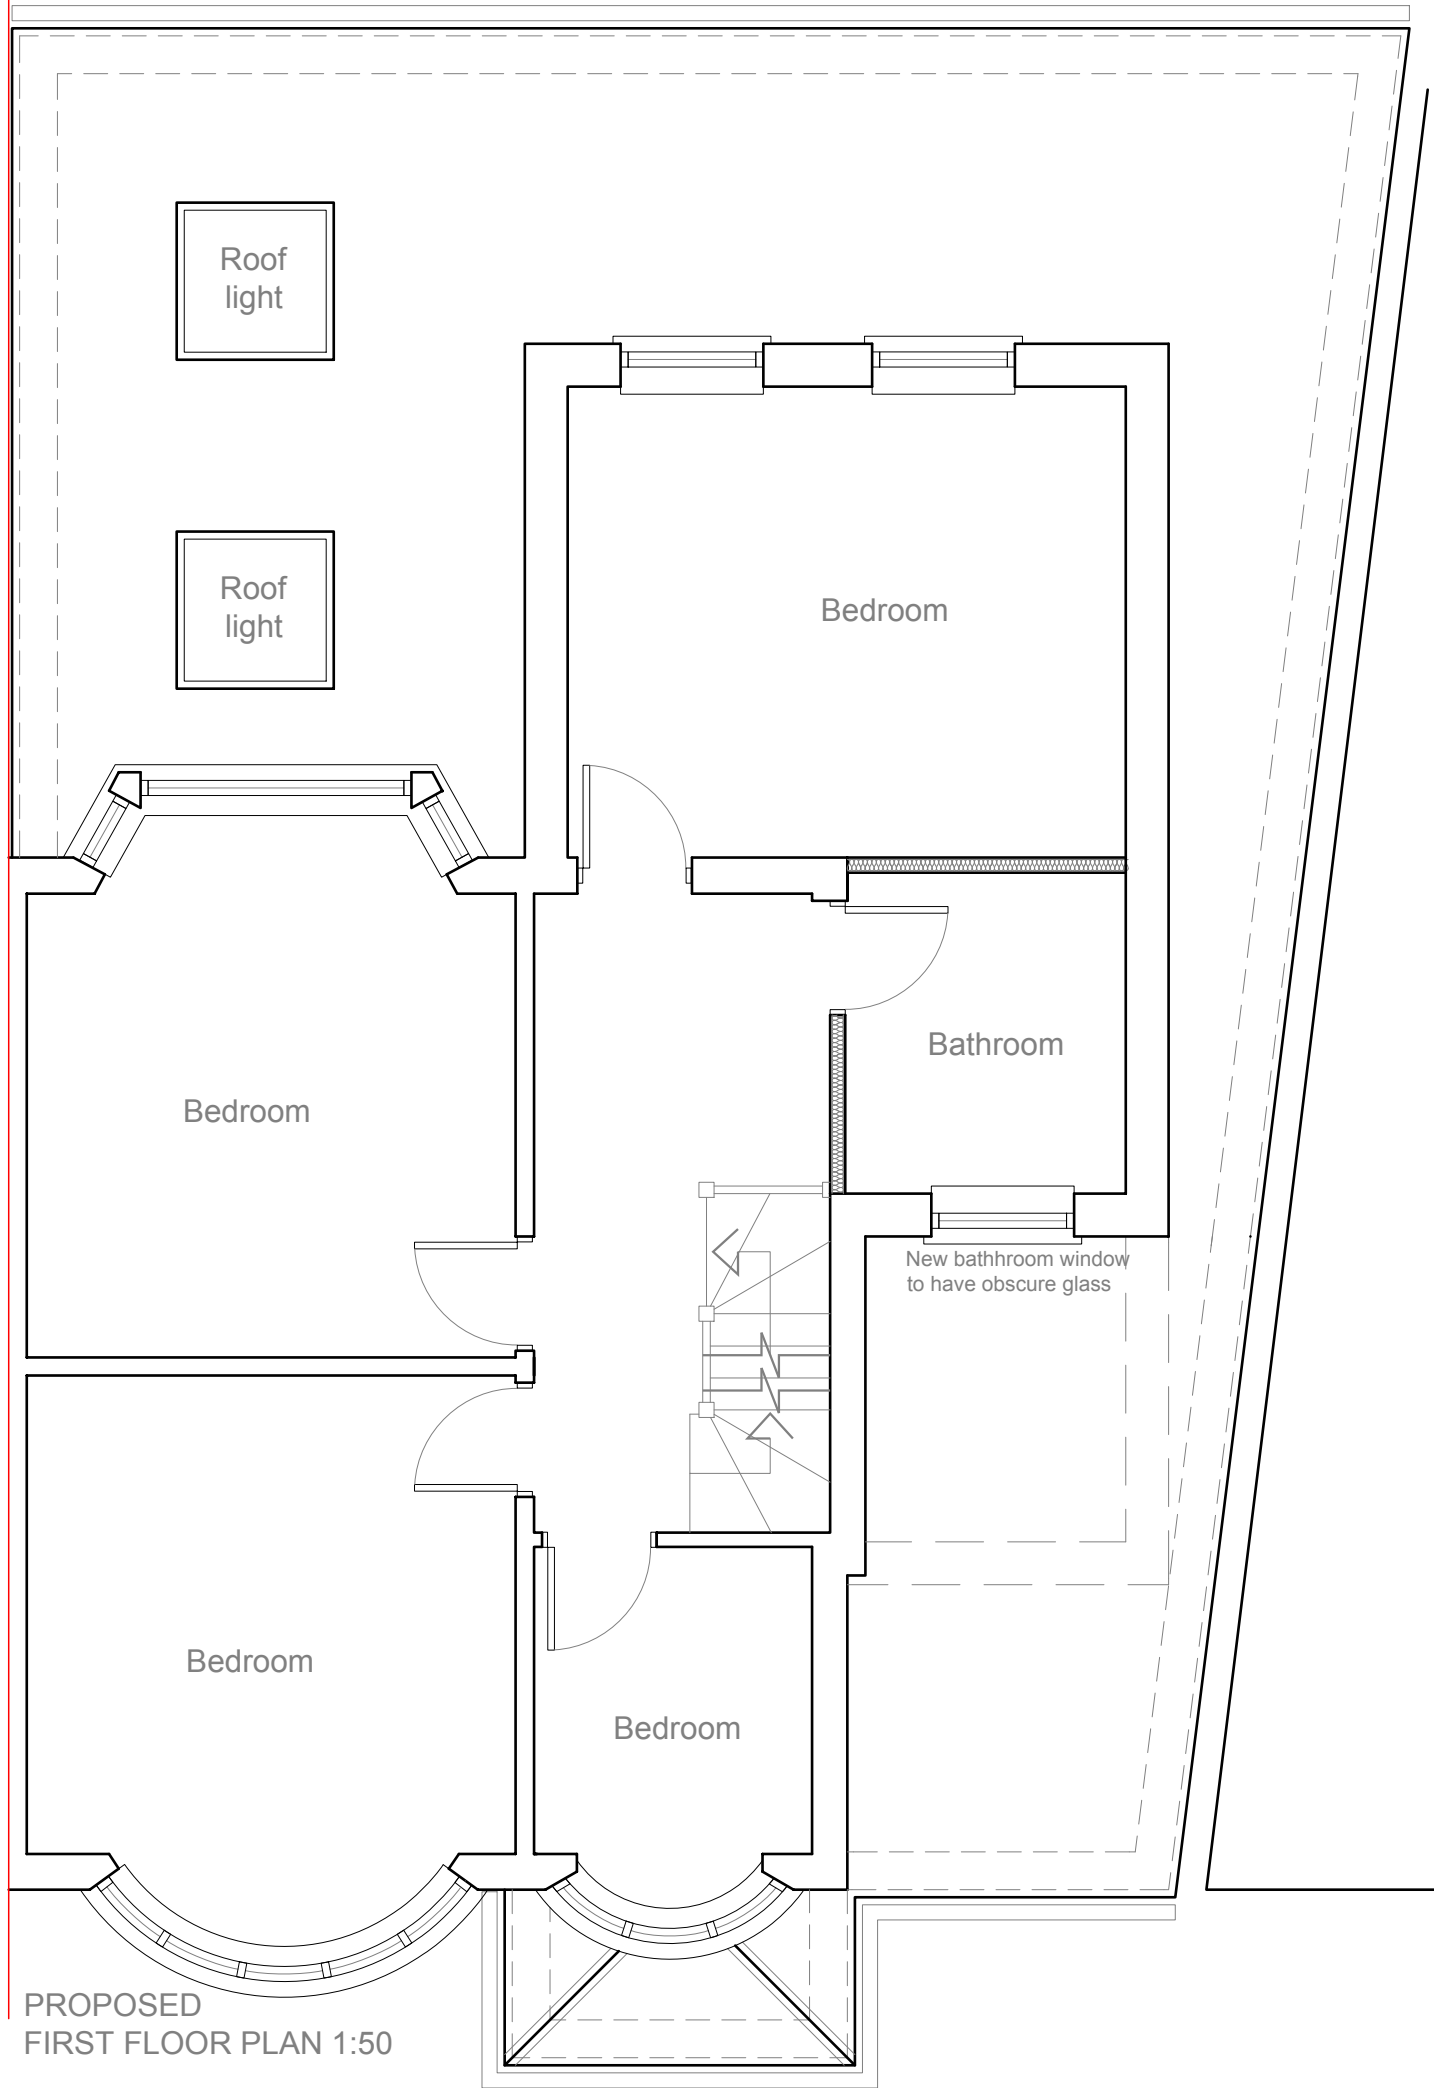

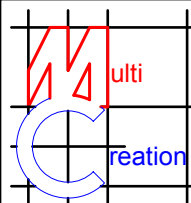	Project:	Title:	Scale: 1:50 @ A3
	14 Colbrook Close	Proposed	Date: Jan 2017
	Hayes	First floor plan	Drawing No.: 3173-06/SP
	UB3 1TH		Revision
239 Western Road, Southall, Middx, UB2 5HS Tel: 020 8571 1369 info@multicreation.co.uk			




EXISTING
FRONT ELEVATION 1:100

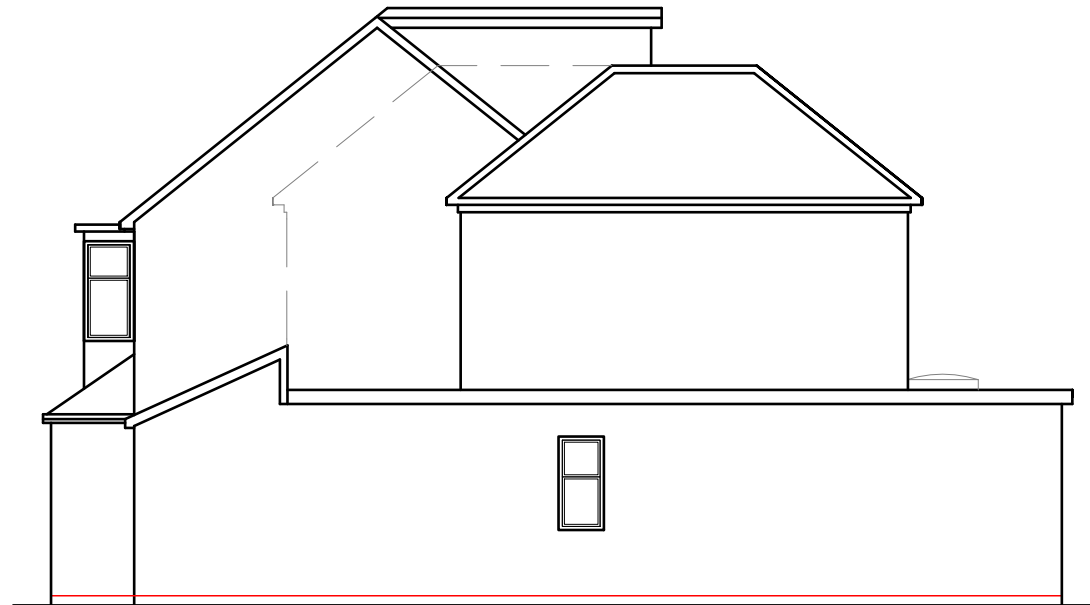

PROPOSED
SIDE ELEVATION 1:100




EXISTING
REAR ELEVATION 1:100

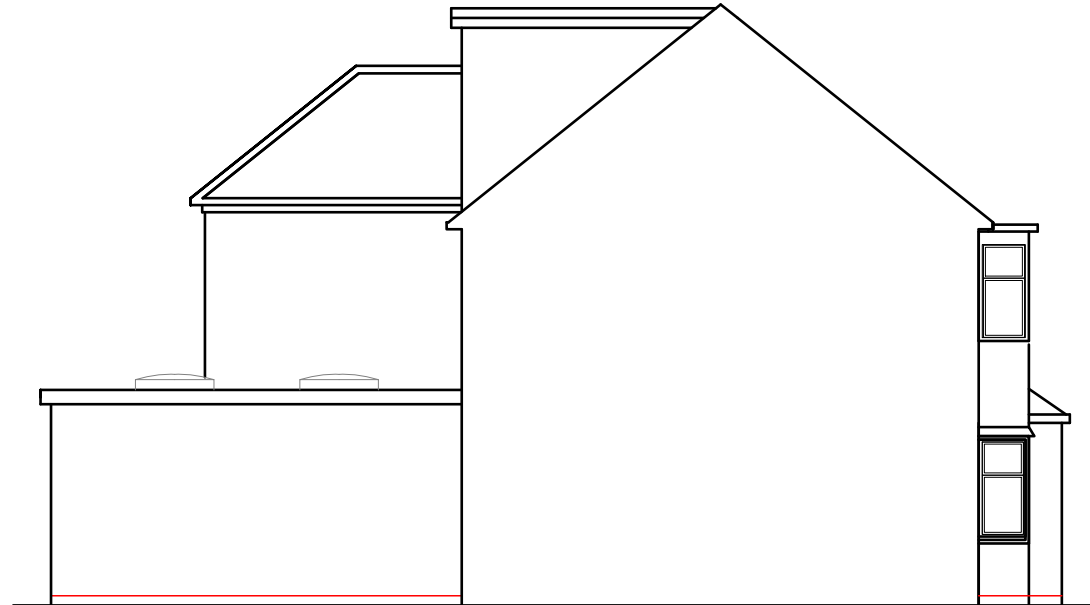

EXISTING
SIDE ELEVATION 1:100

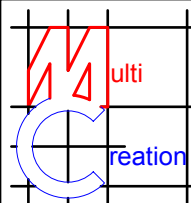

	Project:	Title:	Scale: 1:100 @ A3
	14 Colbrook Close	Proposed	Date: Jan 2017
	Hayes	Elevations	Drawing No.: 3173-07/SP
	UB3 1TH		Revision
239 Western Road, Southall, Middx, UB2 5HS Tel: 020 8571 1369 info@multicreation.co.uk			