


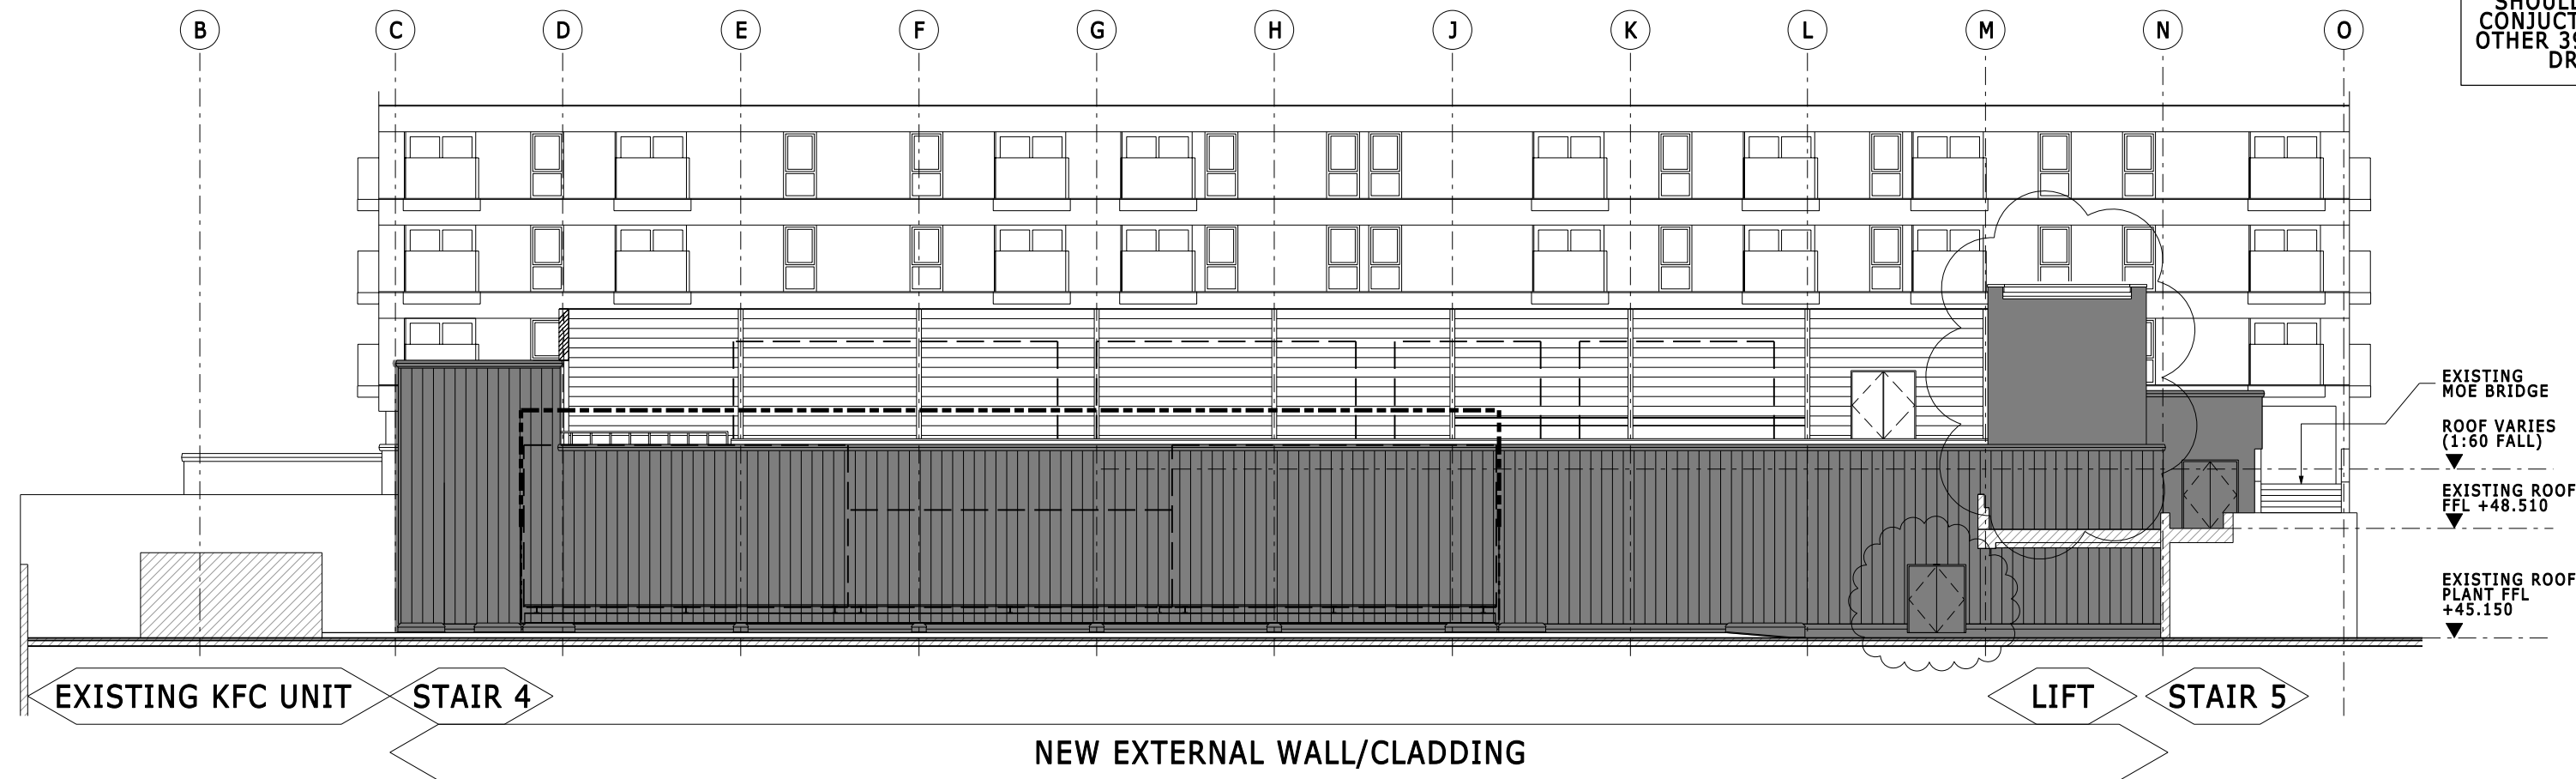

SECTION AA

NOTE: THIS DRAWING SHOULD BE READ IN CONJUNCTION WITH ALL OTHER 3906-D1 SERIES DRAWINGS

THIS DRAWING AND CAD DATA THEREIN IS PROTECTED BY COPYRIGHT AND MUST NOT BE COPIED OR REPRODUCED WITHOUT THE WRITTEN CONSENT OF DLG ARCHITECTS ©

NO DIMENSIONS ARE TO BE SCALED FROM THIS DRAWING. USE FIGURED DIMENSIONS ONLY. ALL DIMENSIONS AND SIZES ARE TO BE CHECKED ON SITE AND ANY DISCREPANCIES REPORTED TO THE ARCHITECT PRIOR TO INITIATION OF ANY WORKS.

THIS DRAWING IS FOR DESIGN PURPOSES ONLY AND IS SUBJECT TO DETAILED SITE AND/OR BUILDING SURVEYS. ALL AREAS ARE SUBJECT TO MEASUREMENT ON SITE AND ARE NOT DEEMED TO BE NET LETTABLE OR DEMISE AREAS.


THESE PROPOSALS ARE SUBJECT TO ALL NECESSARY LOCAL AUTHORITY APPROVALS, STATUTORY CONSENTS AND VERIFICATION OF ALL LEGAL OWNERSHIPS AND ASSOCIATED TENANT AGREEMENTS.

THESE PROPOSALS ARE SUBJECT TO FURTHER STRUCTURAL AND BUILDING SERVICES INVESTIGATIONS AND RELATED STRUCTURAL AND MAE DESIGN, INCLUDING COORDINATION OF MEANS OF ESCAPE, FIRE FIGHTING PROVISIONS AND WHERE APPROPRIATE AGREEMENT OF A FIRE STRATEGY.

EXISTING LANDLORD & TENANT SERVICES FROM UNITS ABOVE AND ADJACENT TO THE NEW STORE WILL PASS THROUGH THE NEW STORE. THESE WILL BE IDENTIFIED AND RECORDED AS WORKS PROCEED.

THESE PROPOSALS HAVE BEEN CREATED FROM LIMITED AS-BUILT DATA AND SURVEY DRAWINGS AND ARE THEREFORE SUBJECT TO FURTHER SITE MEASUREMENTS AND APPROPRIATE SITE INVESTIGATIONS.

NOTE: ALL SOFFIT HEIGHTS & DEPTH OF BEAMS SUBJECT TO SITE SURVEY. DEPTH OF PROPOSED STRUCTURAL BEAMS TO BE CONFIRMED

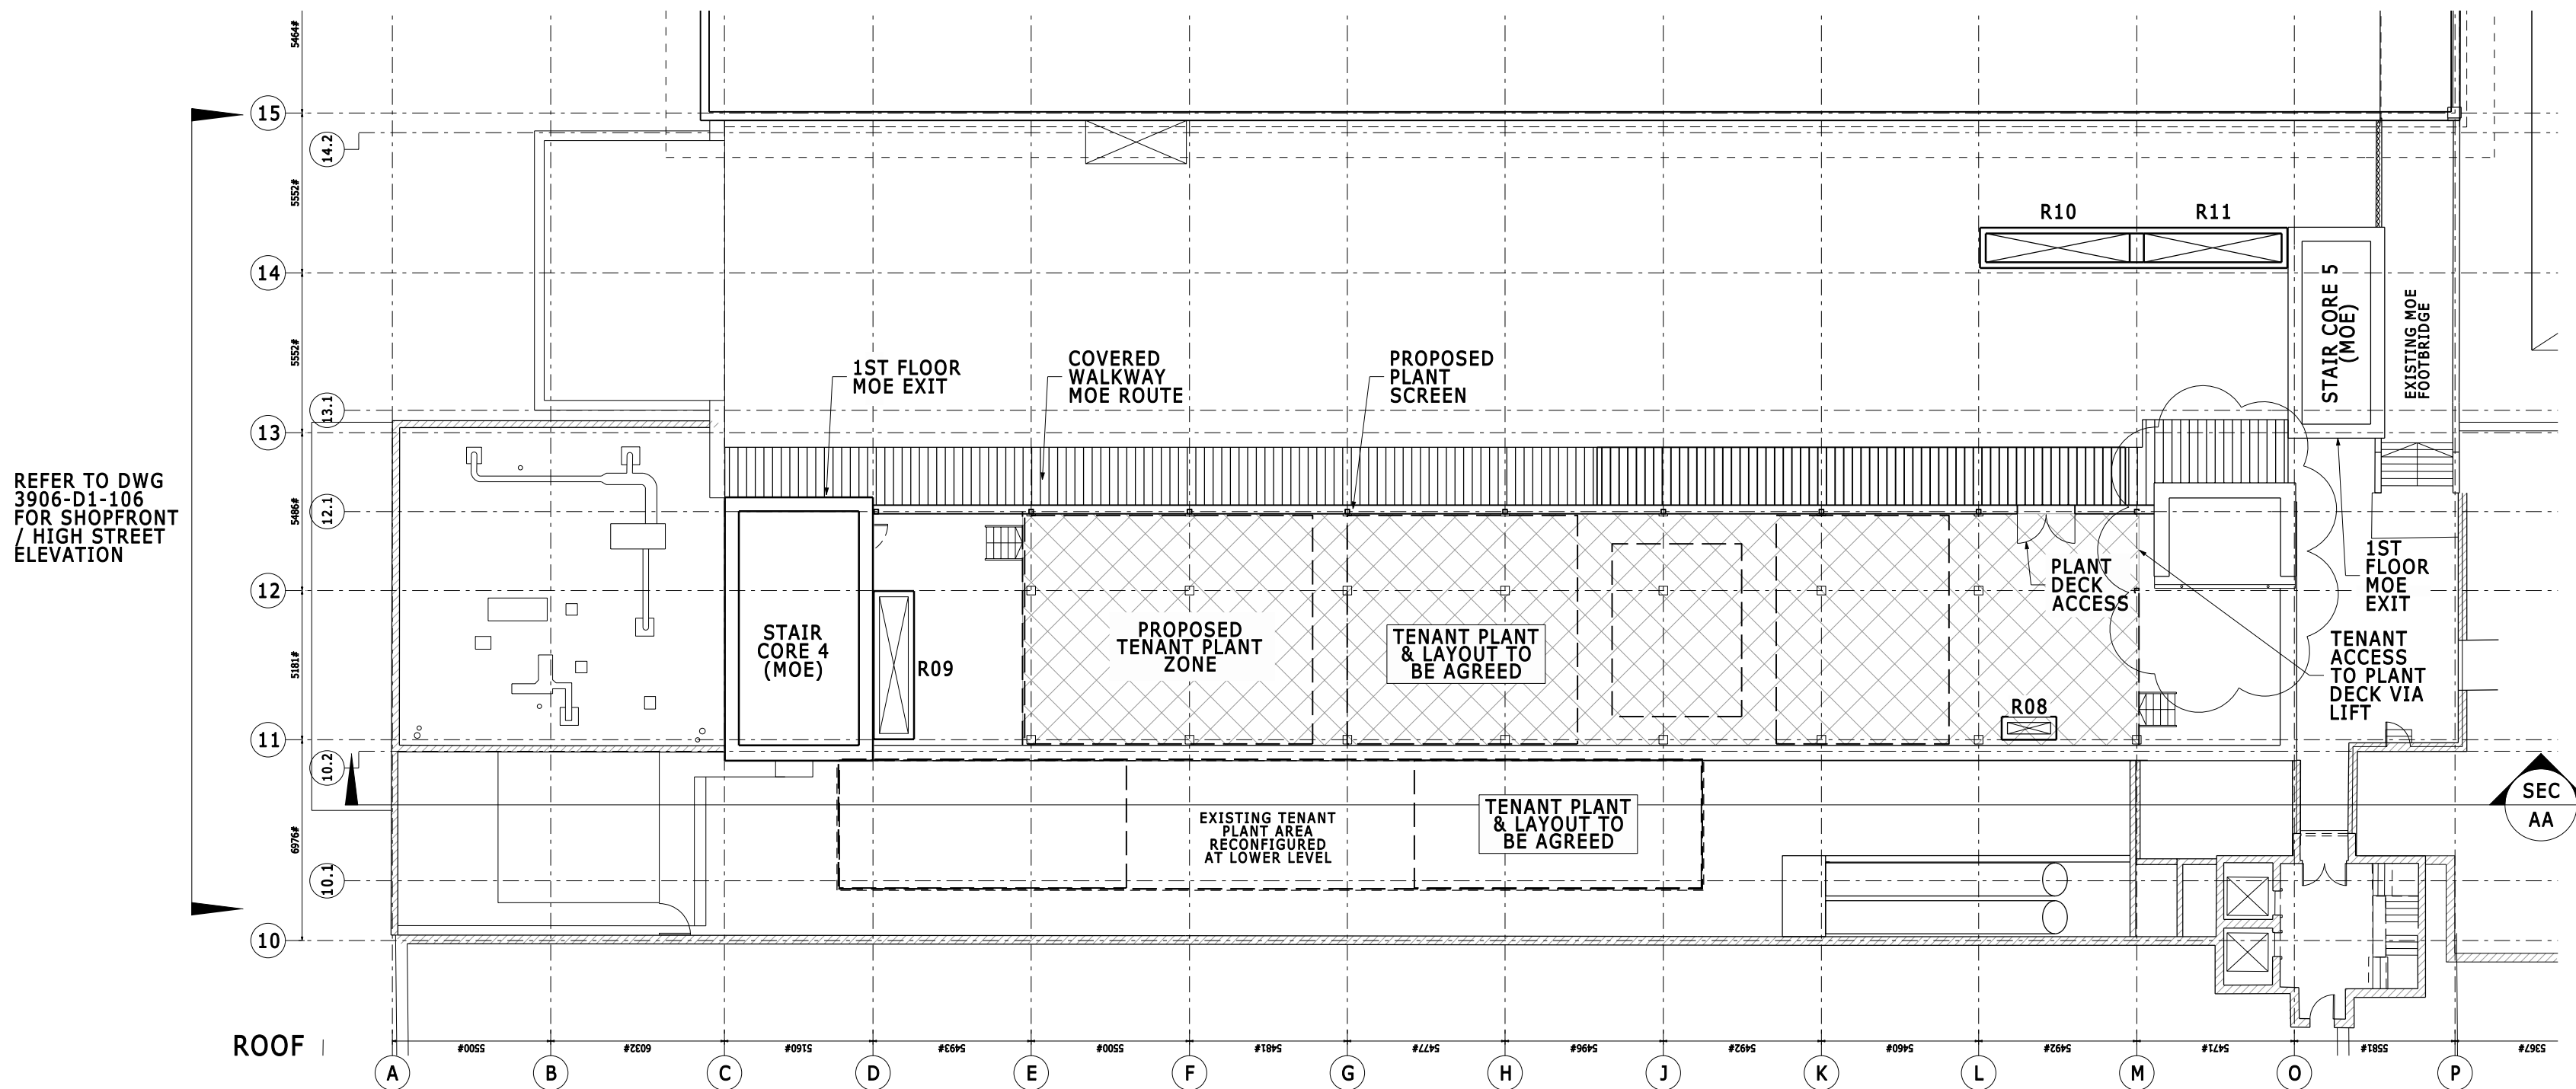

G	LIFT EXTENDED AND SINGLE DOOR OPENING INCREASED TO A DOUBLE DOOR FOR PLANT ACCESS.	01.02.16
F	PLANT SCREEN/CANOPY AMENDED	SL/30.09.14
E	REVISED PLANNING SUBMISSION	RAA/18.09.14
D	STAGE 2 - TENDER ISSUE	AN/12.08.14
C	TENDER ISSUE	SL/11.06.14
B	STAIRCORE 1 PARAPET HEIGHT AMENDED.	SL/11.04.14
A	PLANNING SUBMISSION	SL/18.03.14
REV	DESCRIPTION	INITIALS/ DATE
Job Name	LASALLE IM THE PAVILIONS UXBRIDGE	

Drawing Title
MSU REDEVELOPMENT
EXTERNAL PLANT AREA
ELEVATION


Status
PLANNING

Date	Sheet By	Scale @ Size
NOV'13	SL	1:200@A2
Job Number	Code	Drawing Number
3906	D1	108
		Rev
		G

DLG Architects LLP
Studio 12.G.1 The Leathermarket
11-13 Weston Street
London SE1 3ER

t +44(0)20 7620 1236
admin.london@dlgarchitects.com

dlgarchitects.com

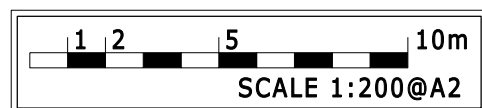

PLANT AREA
ELEVATION

