
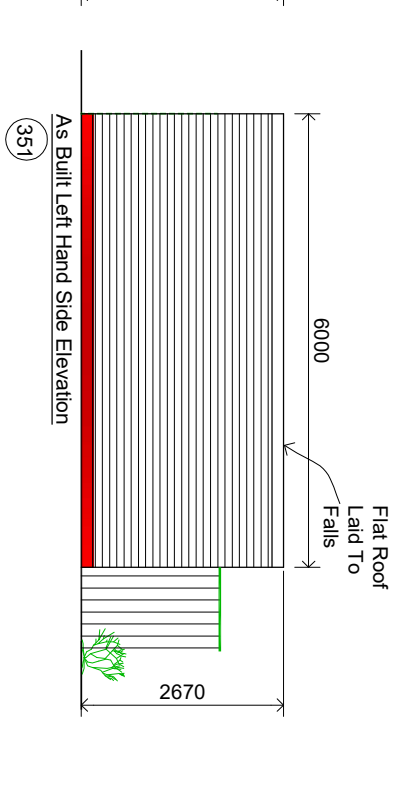


Certificate Of Lawful Development Was Obtained
On 23.09.2024 - Application Ref. No: 3599/APP/2024/2213

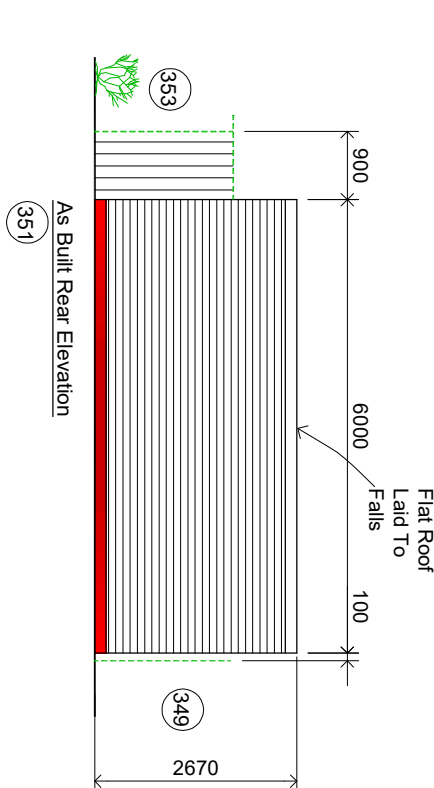

Notes:

1. Do not scale this drawing
2. All dimensions to be verified on site and any discrepancy reported to the client

3. This drawing to be read in conjunction with all relevant drawings

**Owners To Serve Party Wall Act Notice
On Owners Of Adjacent Property And
Obtain Written Agreement, Prior To
Commencement Of Any Works**

Client/Builder To Obtain All Planning Permission Approvals From The Relevant Authority. Commencement Of Building Works Prior To The Planning & Building Control Approvals Is To Client/Builders Own Risk

Client/Builder To Liaise With
Local Water Board For Any New Works
On Or Within The Public Sewer Or Drain Runs
And Obtain Approval From The Local Authority
Prior To Commencement Of Any Works

A horizontal scale bar with four vertical tick marks. Below the bar, the labels 0, 1m, 2m, and 3m are positioned at the first, second, third, and fourth tick marks respectively. The text "Scale Bar" is written below the 0 and 1m labels.

As Built Out Building

CLIENT
Narinder Pal

351 Balmoral Drive
Hayes - Middlesex
UB4 8DL

DRAWING TITLE
Proposed OutBuilding
Floor Layouts & Elevations
Sheet 1

SCALE	DRAWN BY	CHECKED	DATE
1:50 @ A1	RS	RS	29.08.25
1:100 @ A3			

Planning Issues

2024 - 100 - 07

A