

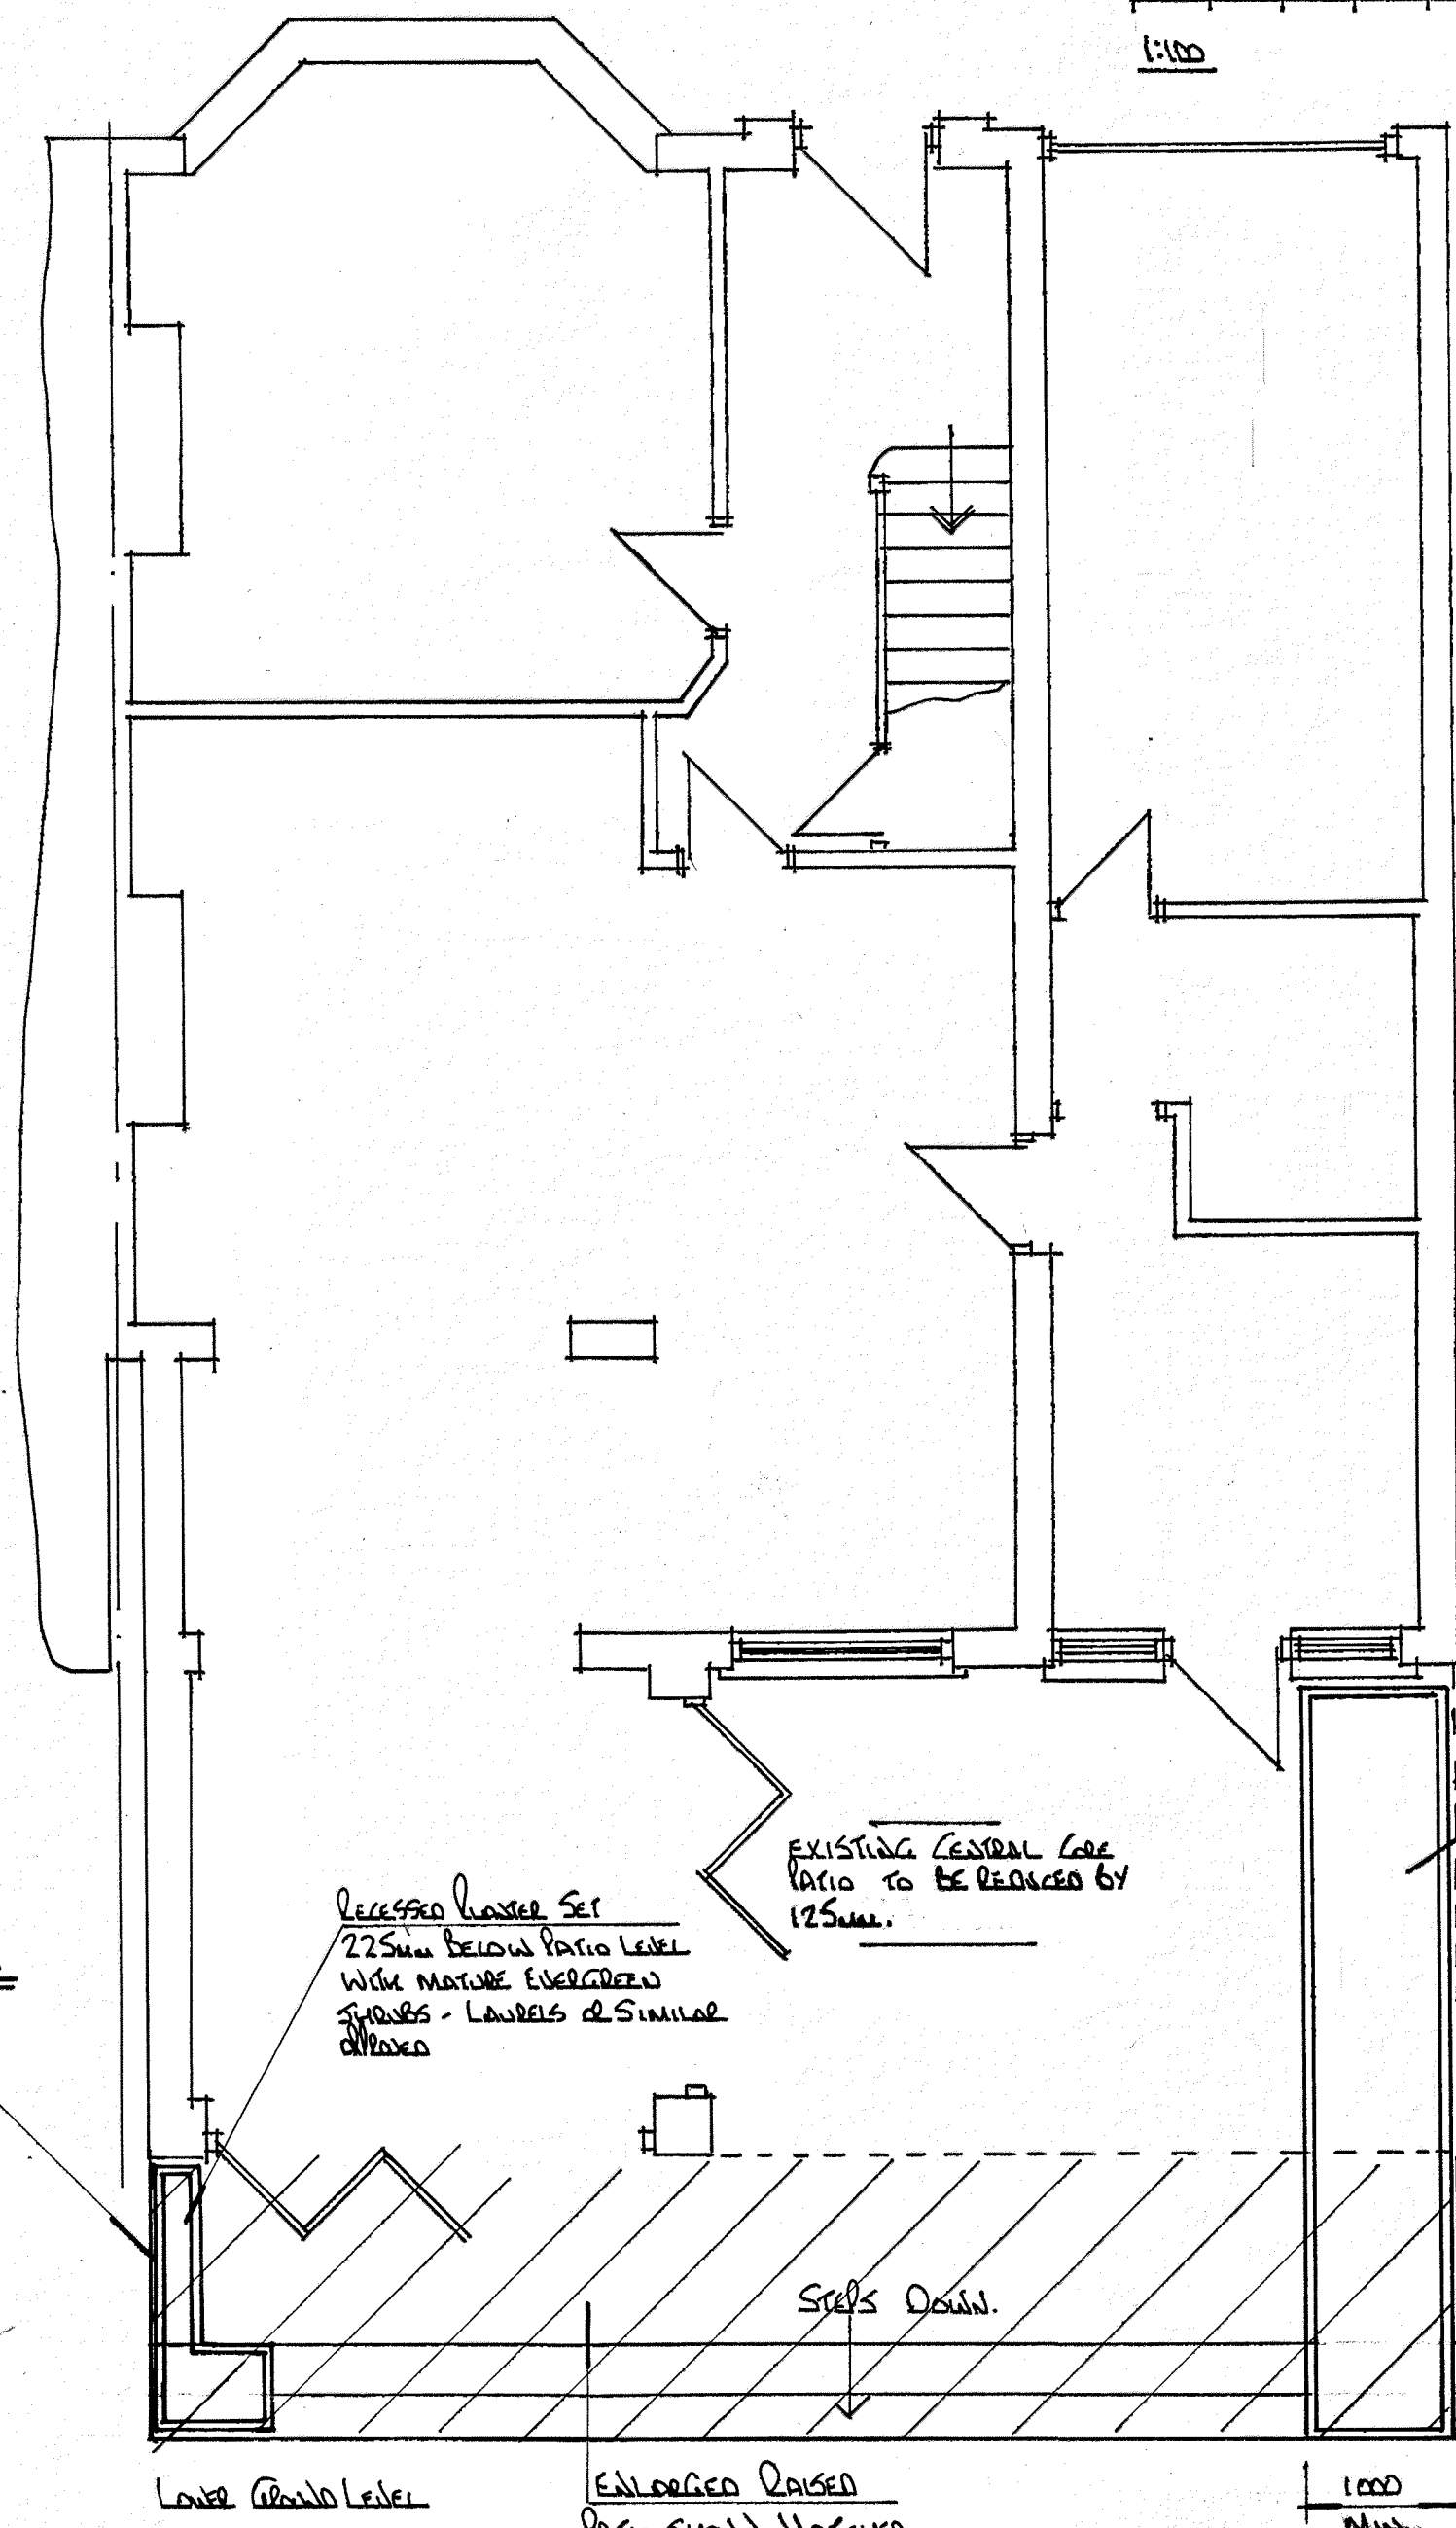


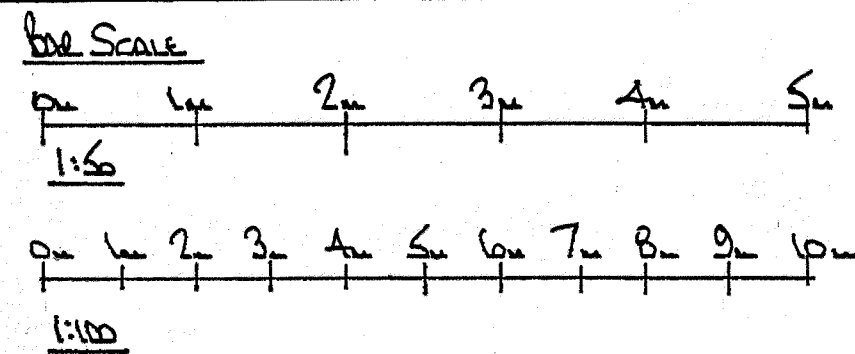


FENCING.
CLOSE BORDERED WITH CONCRETE
POSTS & GRAVEL BOARDS.

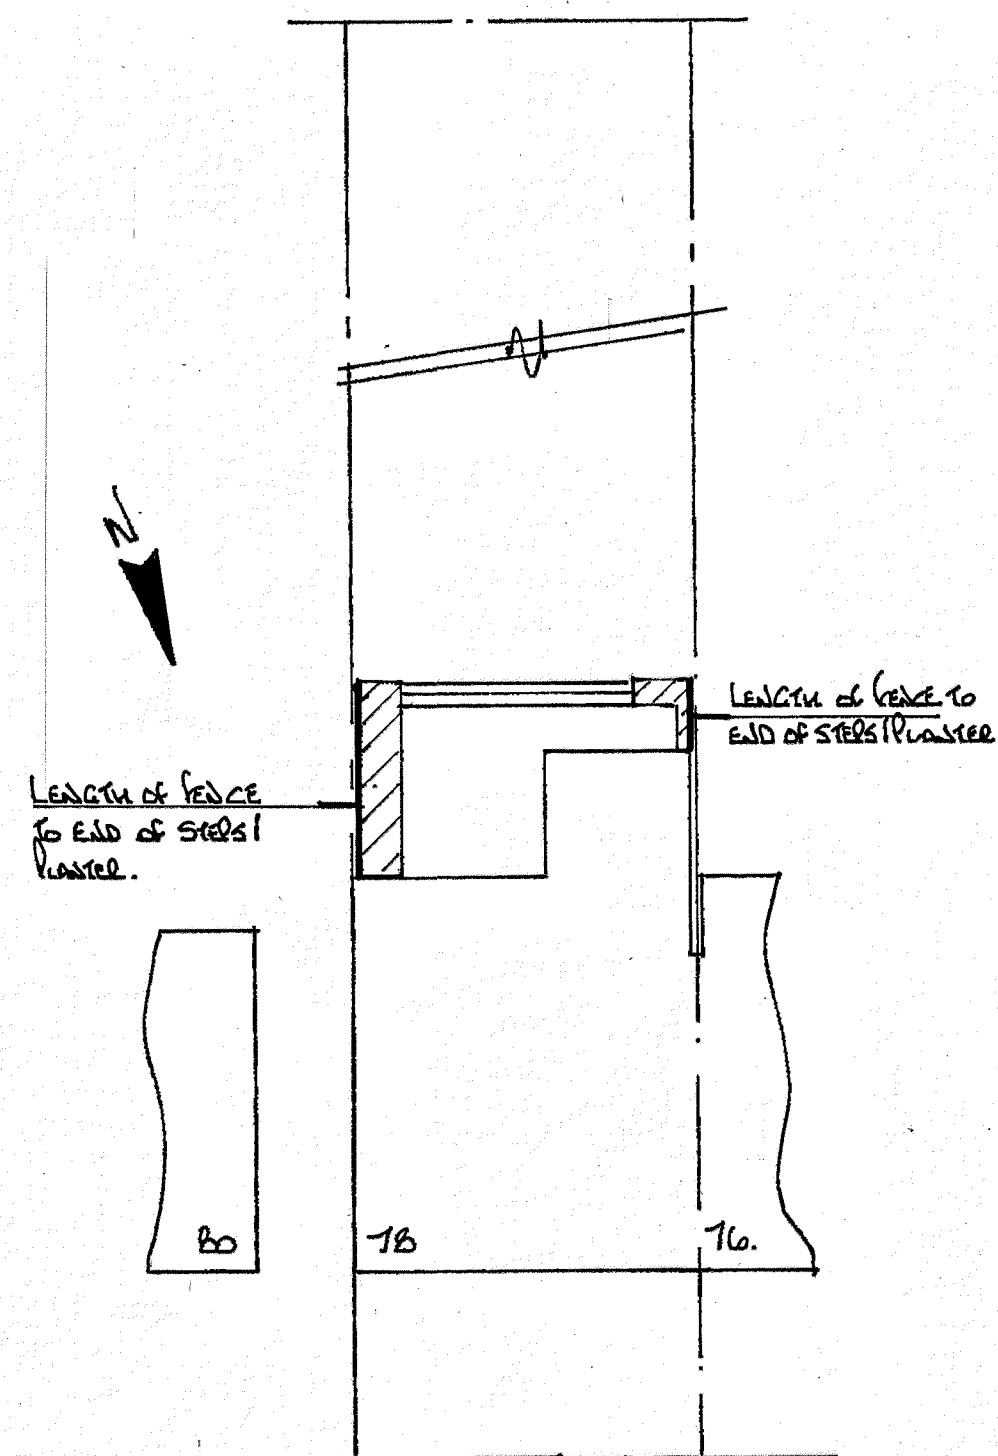

Make Way.
Side Plan Scale 1:200.


LINE OF EXISTING OFFERED
RAISED PATIO SHOULD DOTTED.
RECESSED PLANTER SET 225mm BELOW
PATIO LEVEL WITH MATURE EVERGREEN
SHRUBS - LAURELS OR SIMILAR
APPROVED.

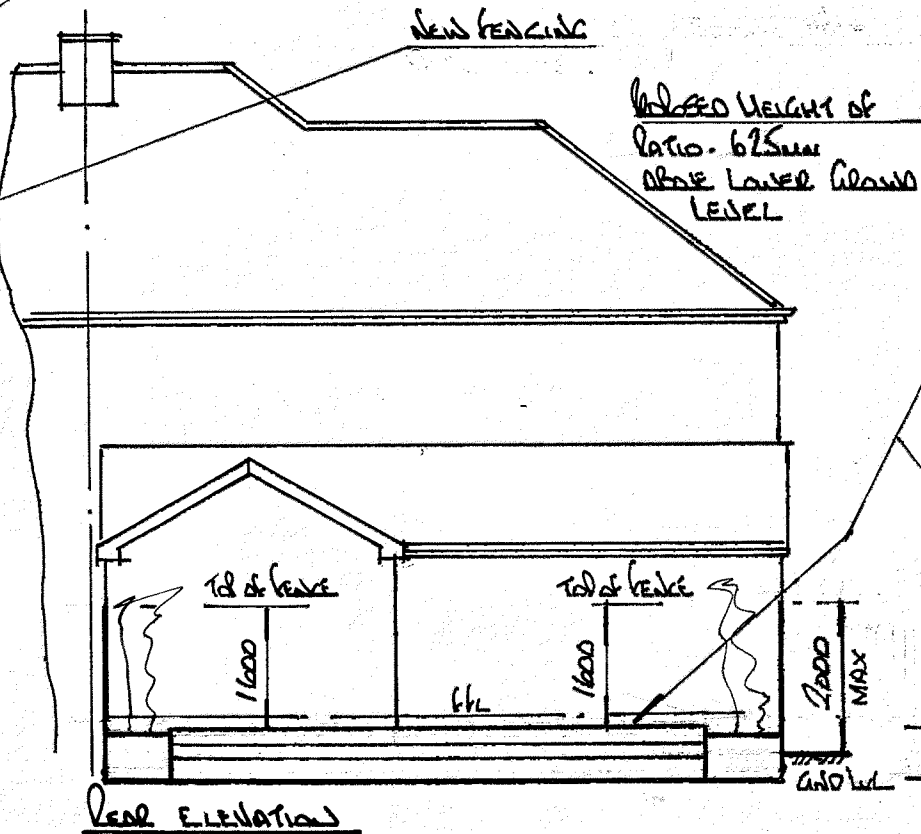

NEW RAISED PATIO TO BE
REDUCED IN HEIGHT BY
125mm FROM 'AS-BUILT'
SITUATION.

PREVIOUSLY OFFERED LEVEL
OF RAISED PATIO.

NEW REDUCED HEIGHT
OF PATIO TO BE ABOVE
EXISTING GROUND LVL

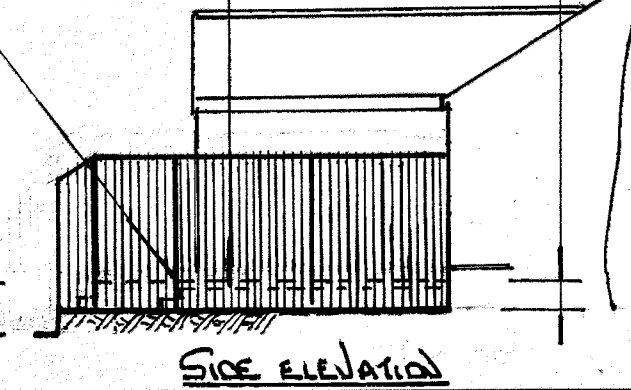

NOTES:
All dimensions must be checked on site and not
scaled from this drawing.

	Date	Revisions
C	JUNE 2021	REV'D TO SUIT PLANNING
B	JUNE 2021	REV'D TO SUIT PLANNING
A	MARCH 2021	SCHEME REVISED

©copyright

Pottle & Co Ltd
Planning & Building Consultants

Suite A, 128 Manor Way
Ruislip, Middlesex, HA4 8HR

Tel: 01895 622800
www.pottle.uk.com

Client

Mr Mrs Buesell

Job Title

1B Manor Way
Ruislip
Middx.

Drawing Title

RETROSPECTIVE PLANNING
APPLICATION FOR VARIATION TO
RECENTLY OFFERED RAISED PATIO.

Scale 1:100 .50

Date MARCH 2021

Drawn by GEB

Drg No.

4552101.

Rev.

X.B.