


# LOCATION PLAN

SCALE 1:1250



AS BUILT GROUND FLOOR PLAN

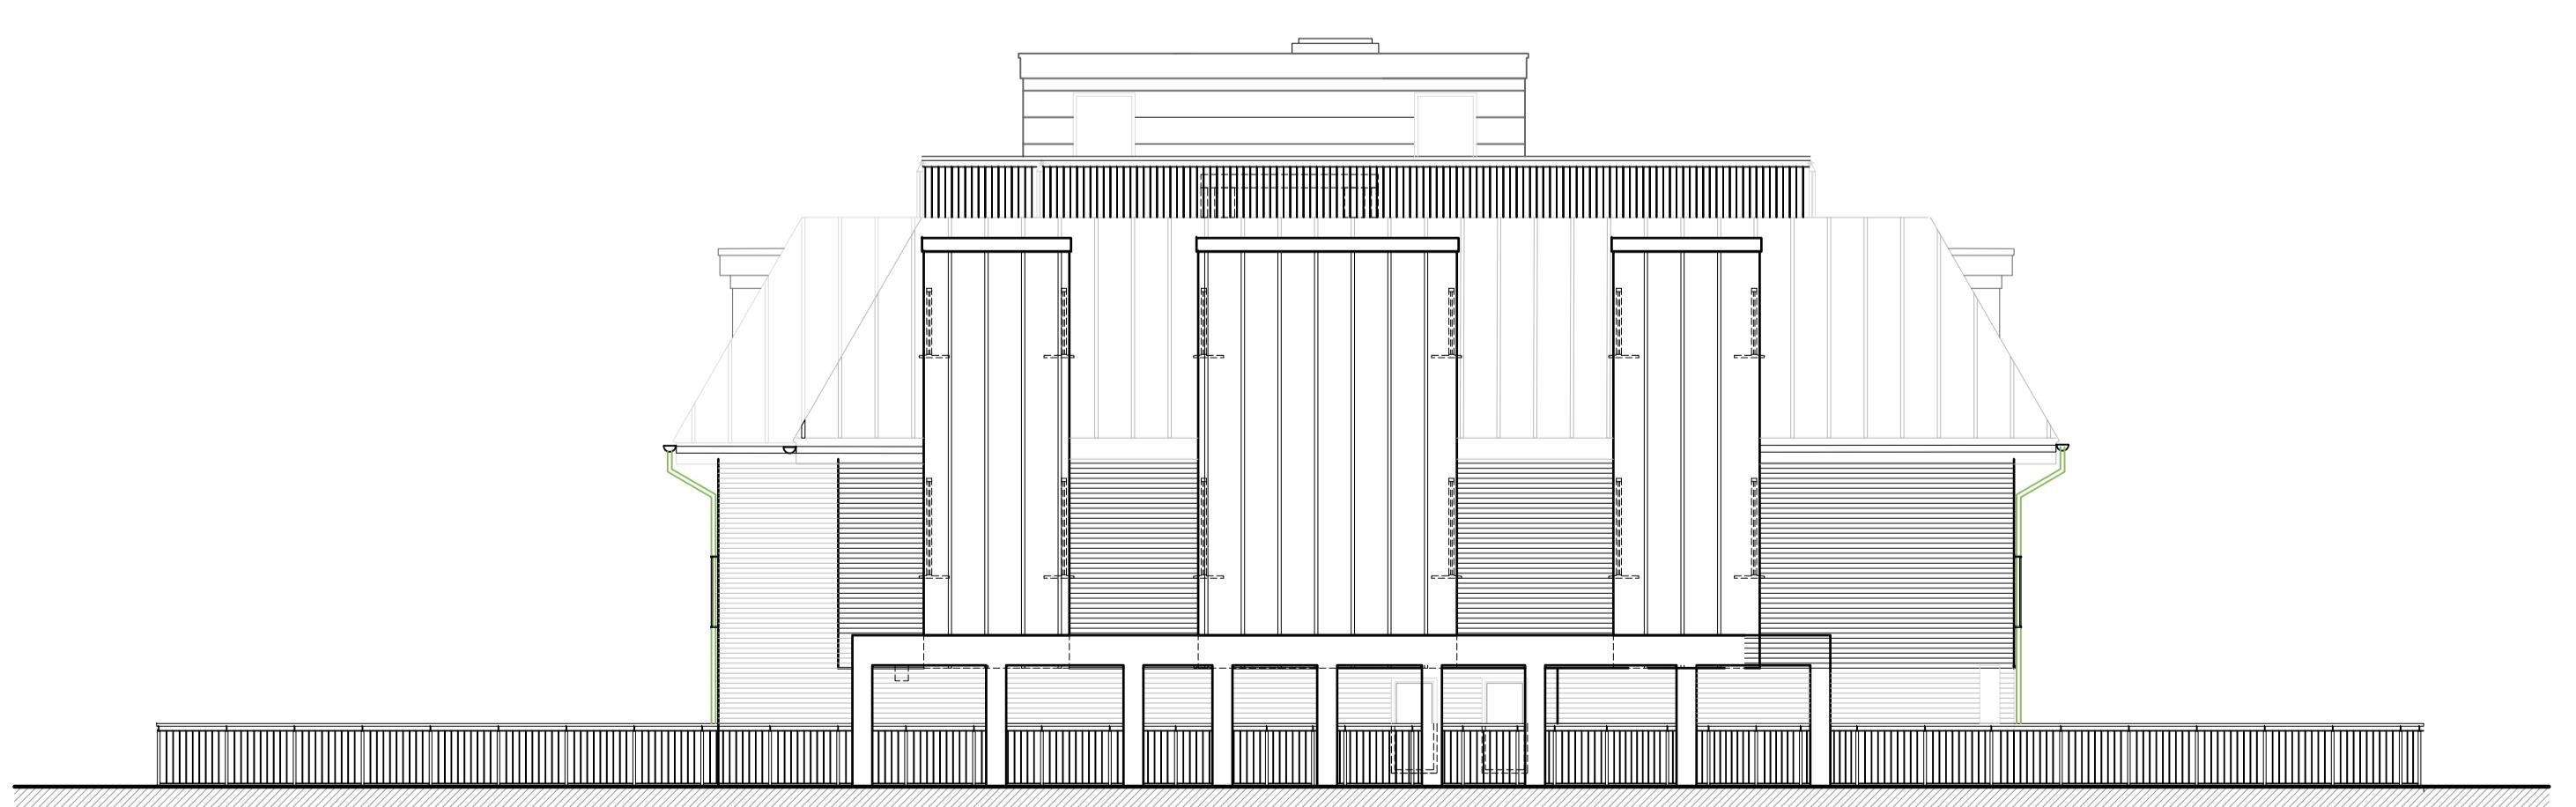

## AS BUILT EAST ELEVATION

Rev	Date	Description	Init.
-	-	-	-

HUSSAIN SHAH

# Project Title PROPOSED PART GROUND FLOOR CHANGE OF USE

81 FIELD END ROAD, PINNER, HA5 1TD  
Drawing Title

AS BUILT GROUND FLOOR PLAN AND SIDE ELEVATION		
Cad File	Sheet Size	Scale
P003	A1	1:50
Drawn by	Drawing Date	Approved by
BR	MAR 2024	NJ
Project No.	Drawing No.	Revision
1674	P202	-



Juttlä  
Architects

Middlesex HA4 7AR  
t 01923 840077 f 01923 840078  
info@juttl-a-architects.com  
juttl-a-architects.com

---

This drawing is property of Juttlä Architects

This drawing is property of Juttla Architects Ltd © and must not be copied or otherwise reproduced. All dimensions must be checked on site before commencing work. No dimensions to be scaled from this drawing. This drawing was produced using AutoCad 2016.

1. **What is the primary purpose of the study?**

## PLANNING ISSUE