


LOCATION PLAN
SCALE 1:1250



AS BUILT GROUND FLOOR PLAN

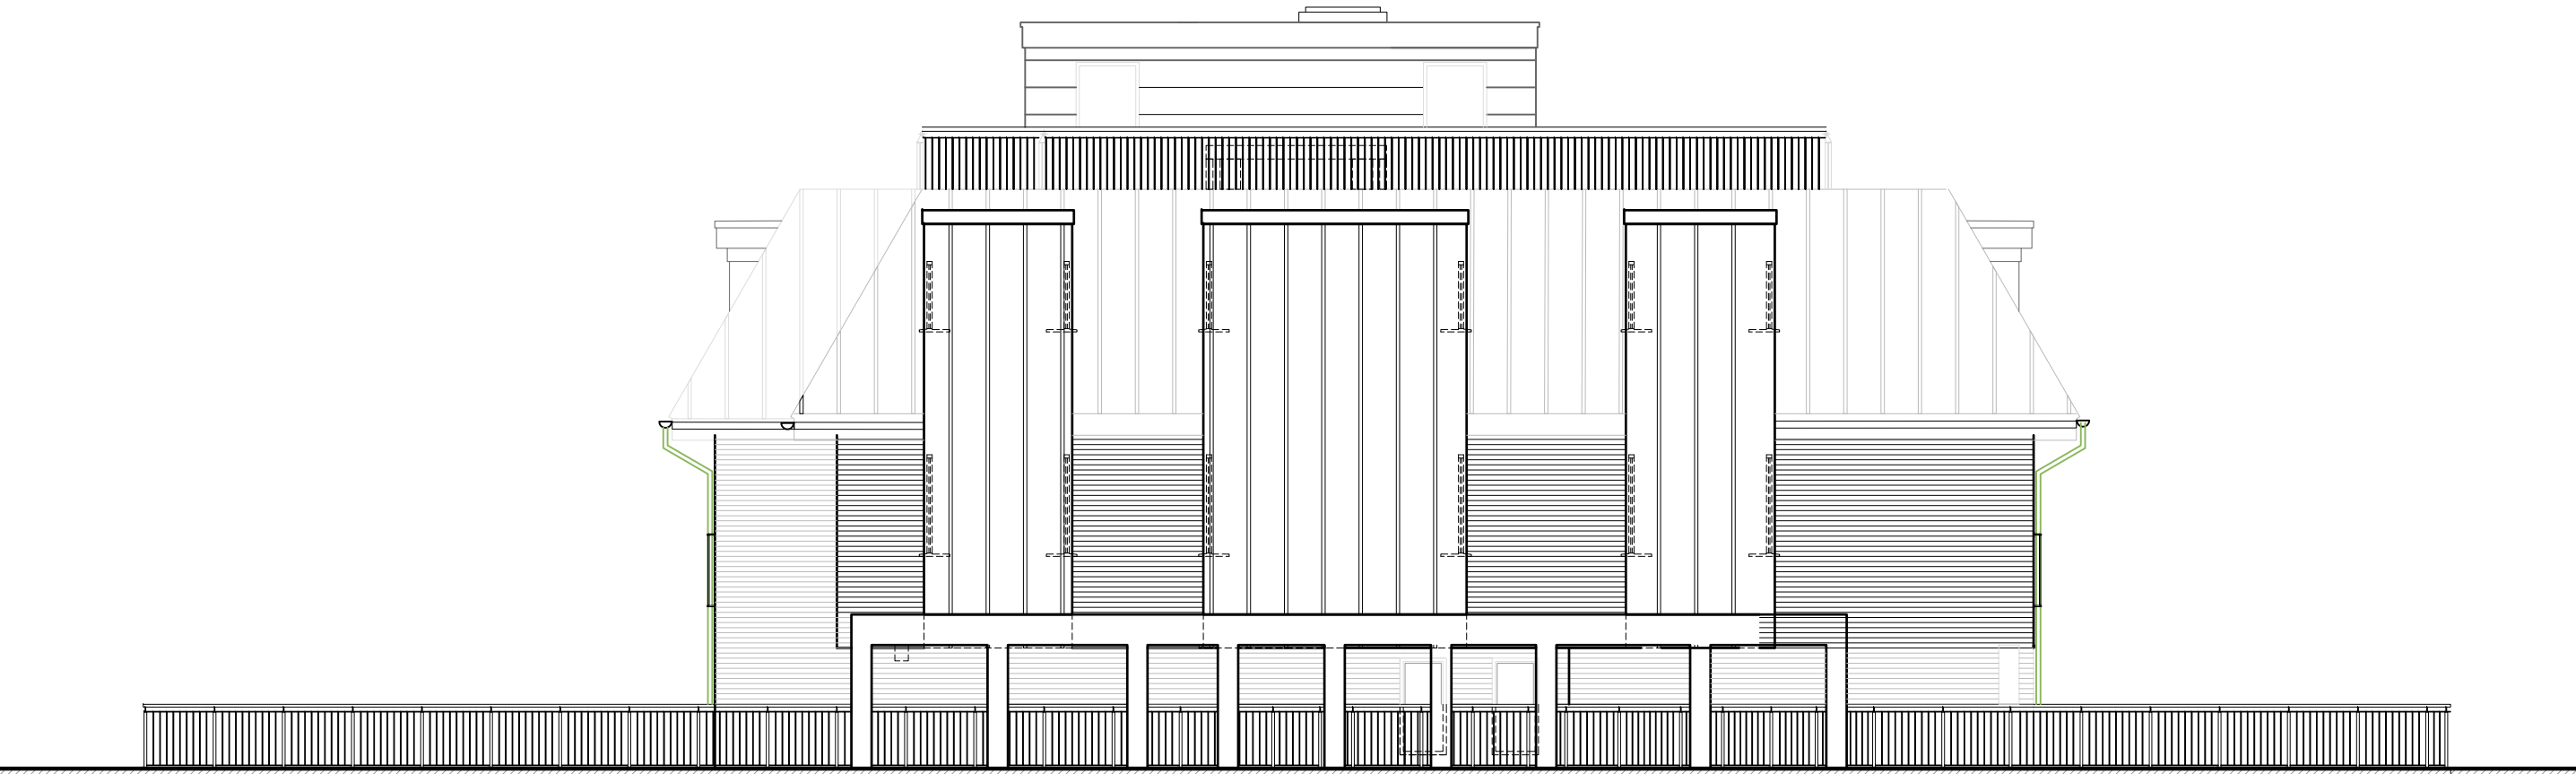

AS BUILT EAST ELEVATION

A	14.06.24	AMENDED TO SUIT PLANNING COMMENTS	KP
Rev	Date	Description	Init.

Client

HUSSAIN SHAH

Project Title
PROPOSED PART GROUND FLOOR CHANGE OF USE

81 FIELD END ROAD, PINNER, HA5 1TD

Drawing Title

AS BUILT GROUND FLOOR PLAN AND SIDE ELEVATION

Cad File	Sheet Size	Scale
P003	A1	1:50
Drawn by	Drawing Date	Approved by
BR	MAR 2024	NJ
Project No.	Drawing No.	Revision
1674	P202	A



2-4 High Street, Ruislip
Middlesex HA4 7AP
t 01923 840077 f 01923 840078
info@juttla-architects.com
juttla-architects.com

This drawing is property of Juttla Architects Ltd © and must not be copied or otherwise reproduced. All dimensions must be checked on site before commencing work. No dimensions to be scaled from this drawing. This drawing was produced using AutoCad 2016.

PLANNING ISSUE