




AS BUILT BLOCK PLAN SCALE 1:100

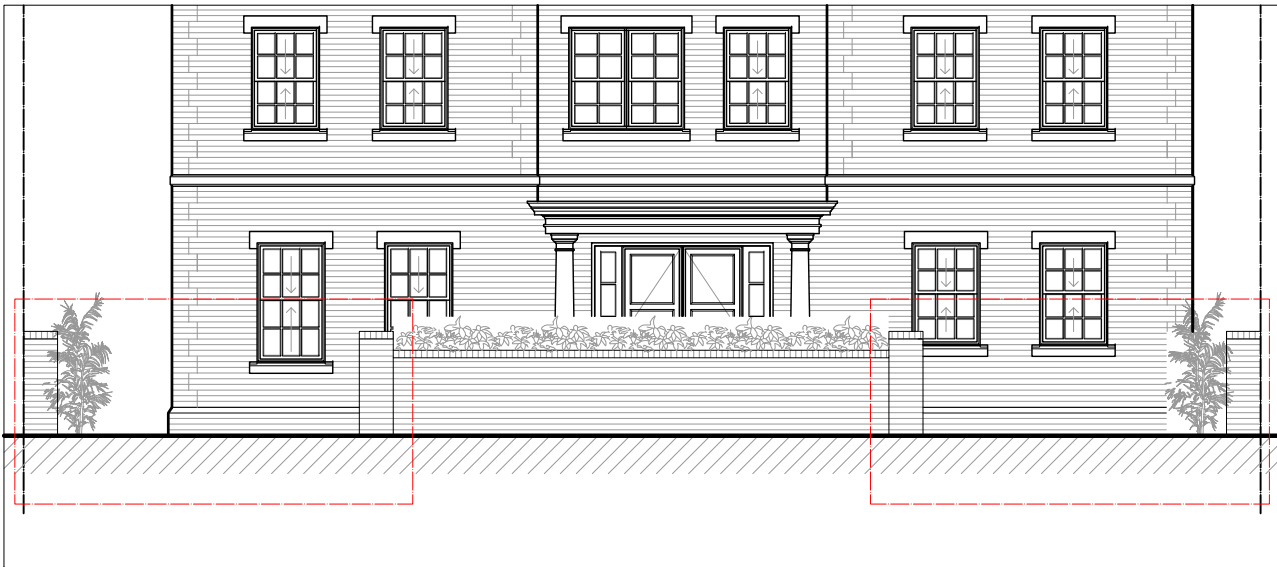

AS BUILT STREET SCENE SCALE 1:100

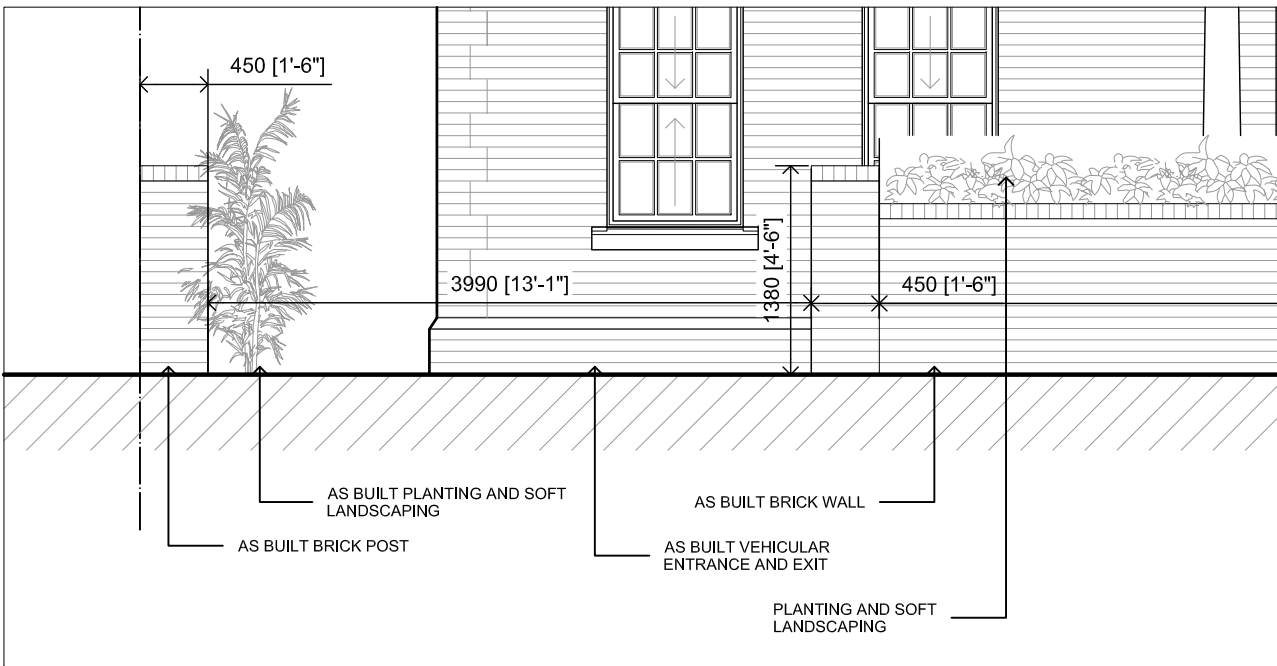


AS BUILT VEHICULAR ACCESS SCALE 1:50

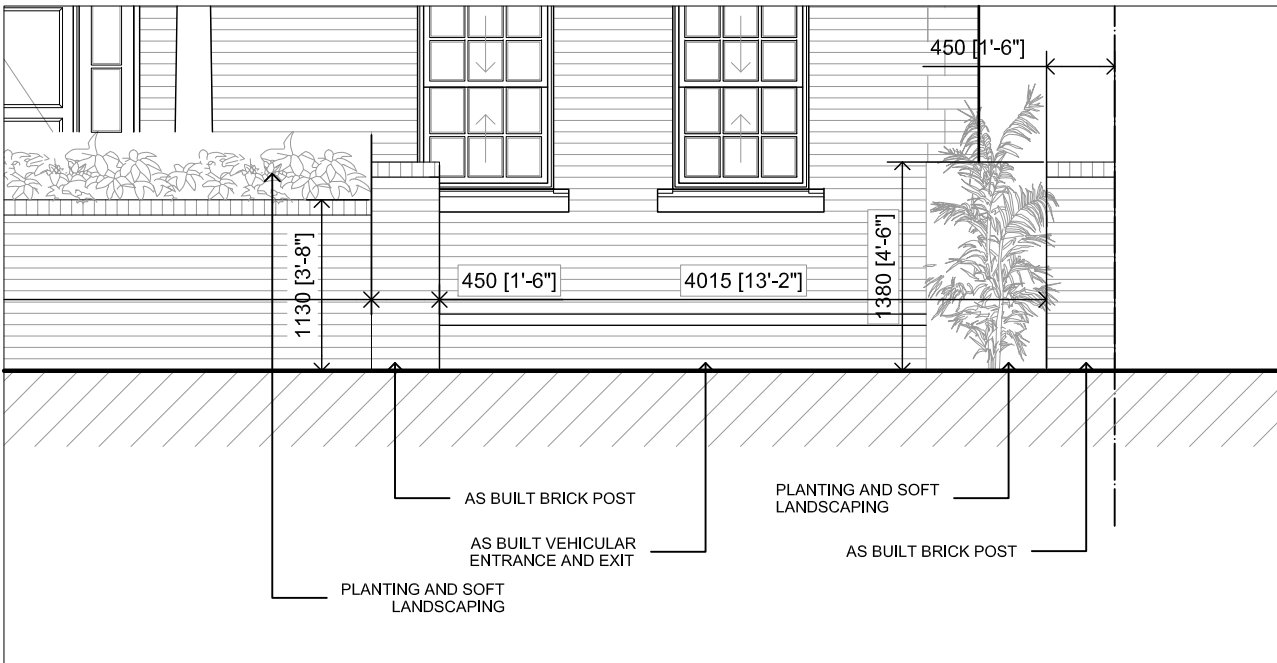

AS BUILT VEHICULAR ACCESS SCALE 1:50

Rev	Date	Description	Init.
-	-	-	-
Client			
MR & MRS SHAH			
Project Title			
PROPOSED NEW DWELLING (RETROSPECTIVE)			
28 MOOR PARK ROAD, NORTHWOOD, HA6 2DJ			
Drawing Title			
AS BUILT FRONT BOUNDARY WALL			
Cad File		Sheet Size	Scale
P005		A3	1:50
Drawn by		Drawing Date	Approved by
BR		JAN 2024	NJ
Project No.		Drawing No.	Revision
1594		P103	-



Jutla Architects

2-4 High Street Ruitlip
Middlesex HA4 7AR
T: 01923 640077 F: 01923 640078
info@jutla-architects.com
jutla-architects.com

This drawing is property of Jutla Architects Ltd © and must not be copied or otherwise reproduced. All dimensions must be checked on site before commencing work. No dimensions to be scaled from this drawing. This drawing was produced using AutoCad 2016.

PLANNING ISSUE