




0 1m 2m 5m 10m 20m  
SCALE BAR 1:100

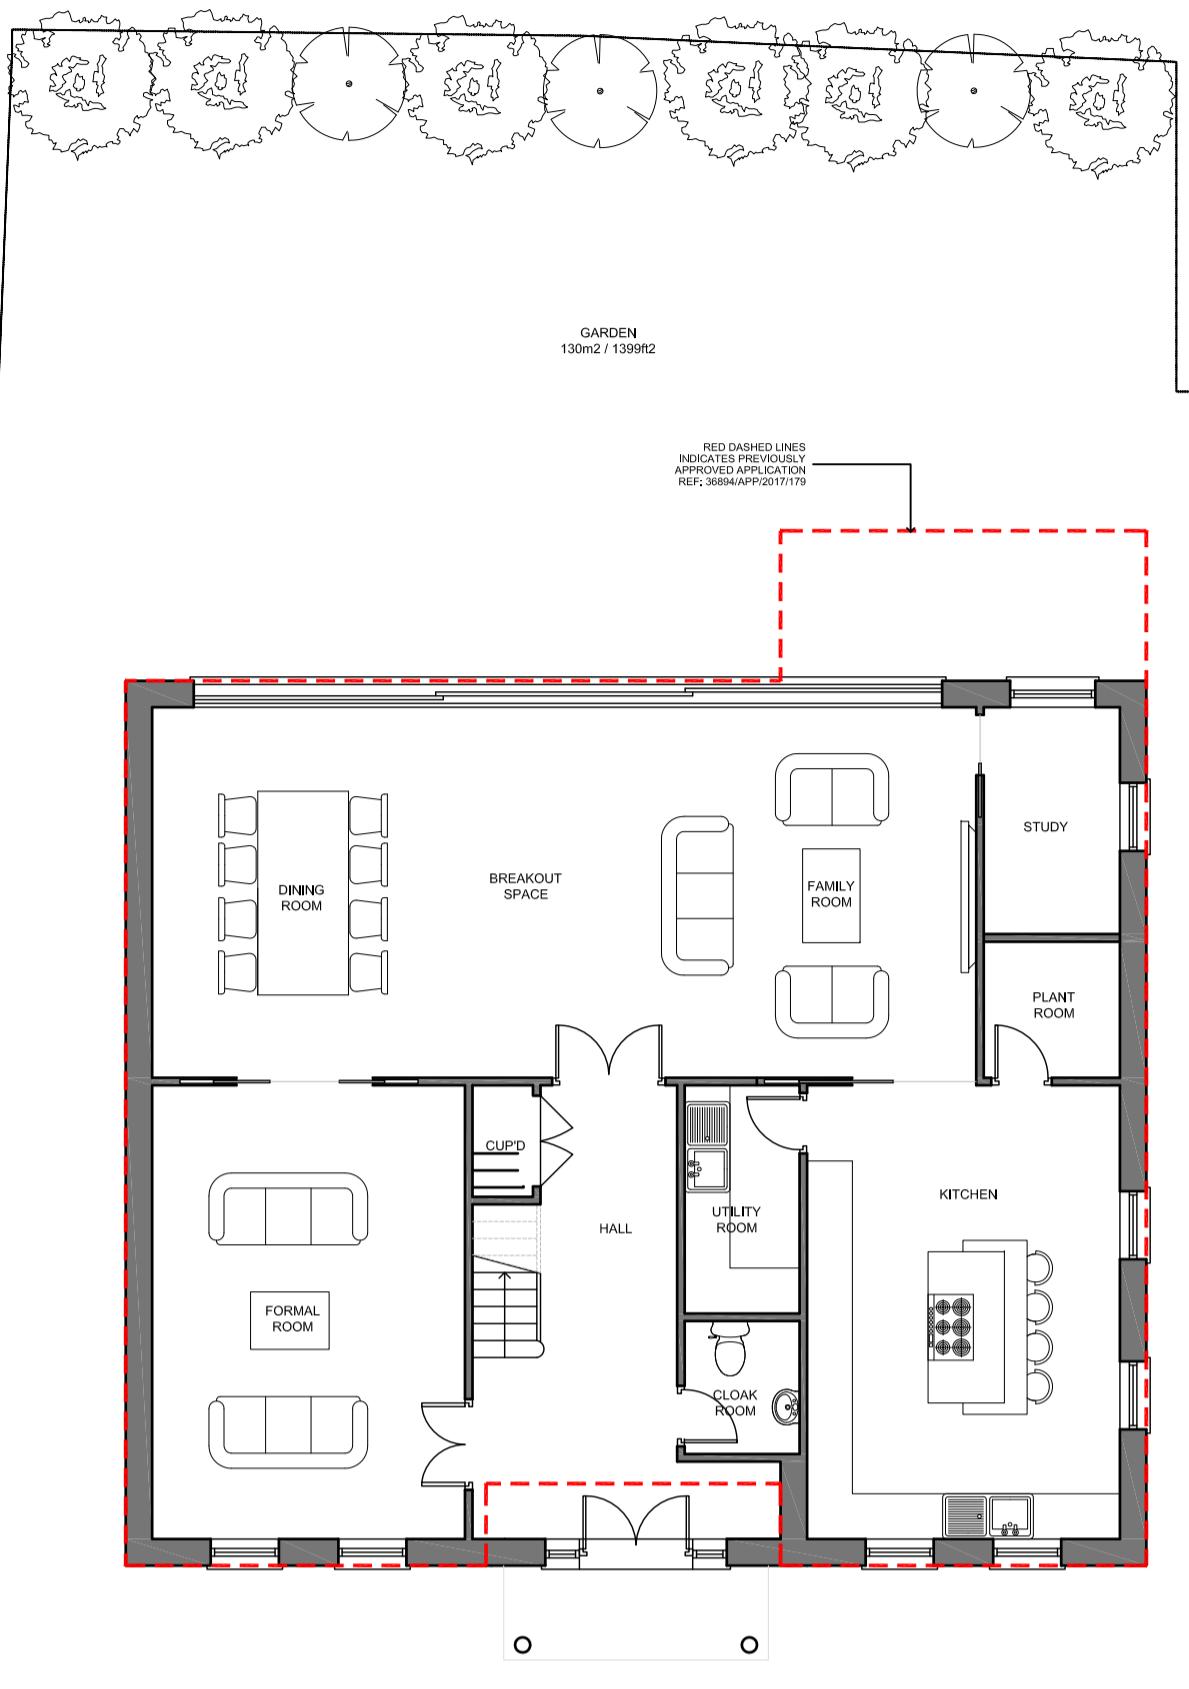


AS BUILT GROUND FLOOR PLAN

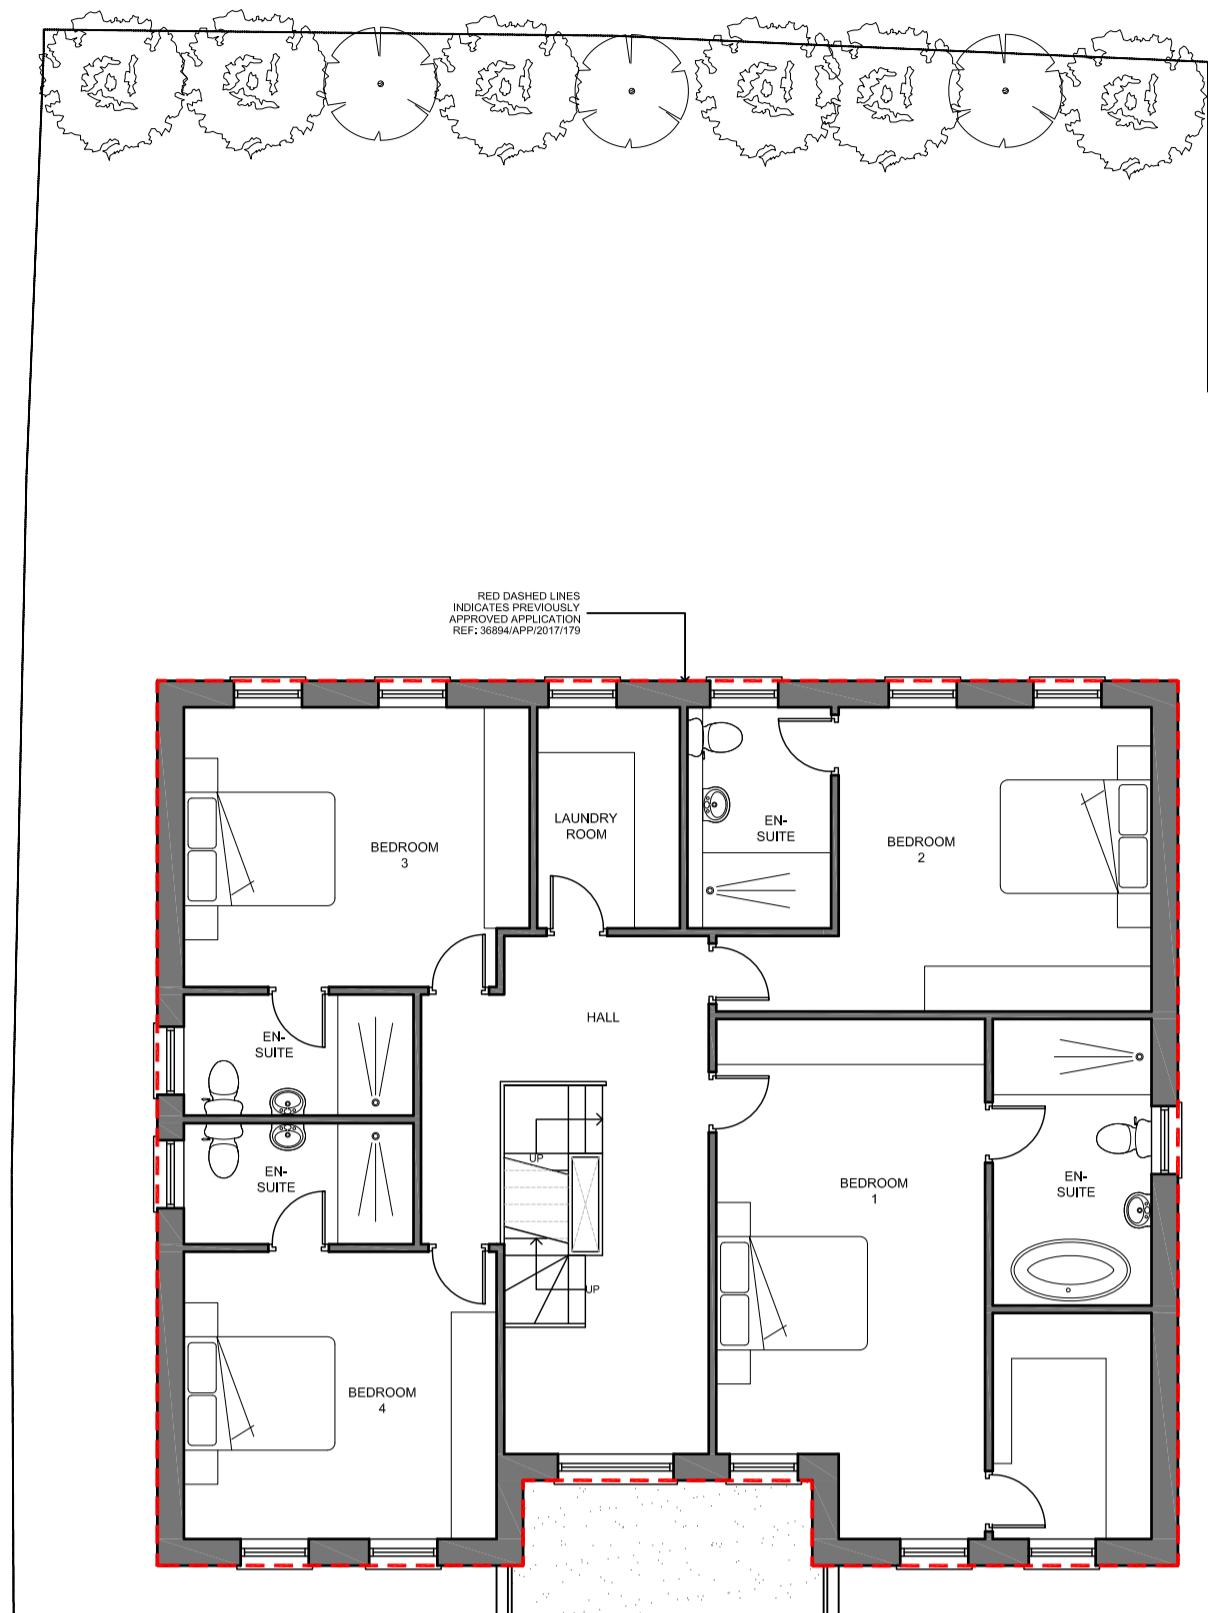

AS BUILT FIRST FLOOR PLAN

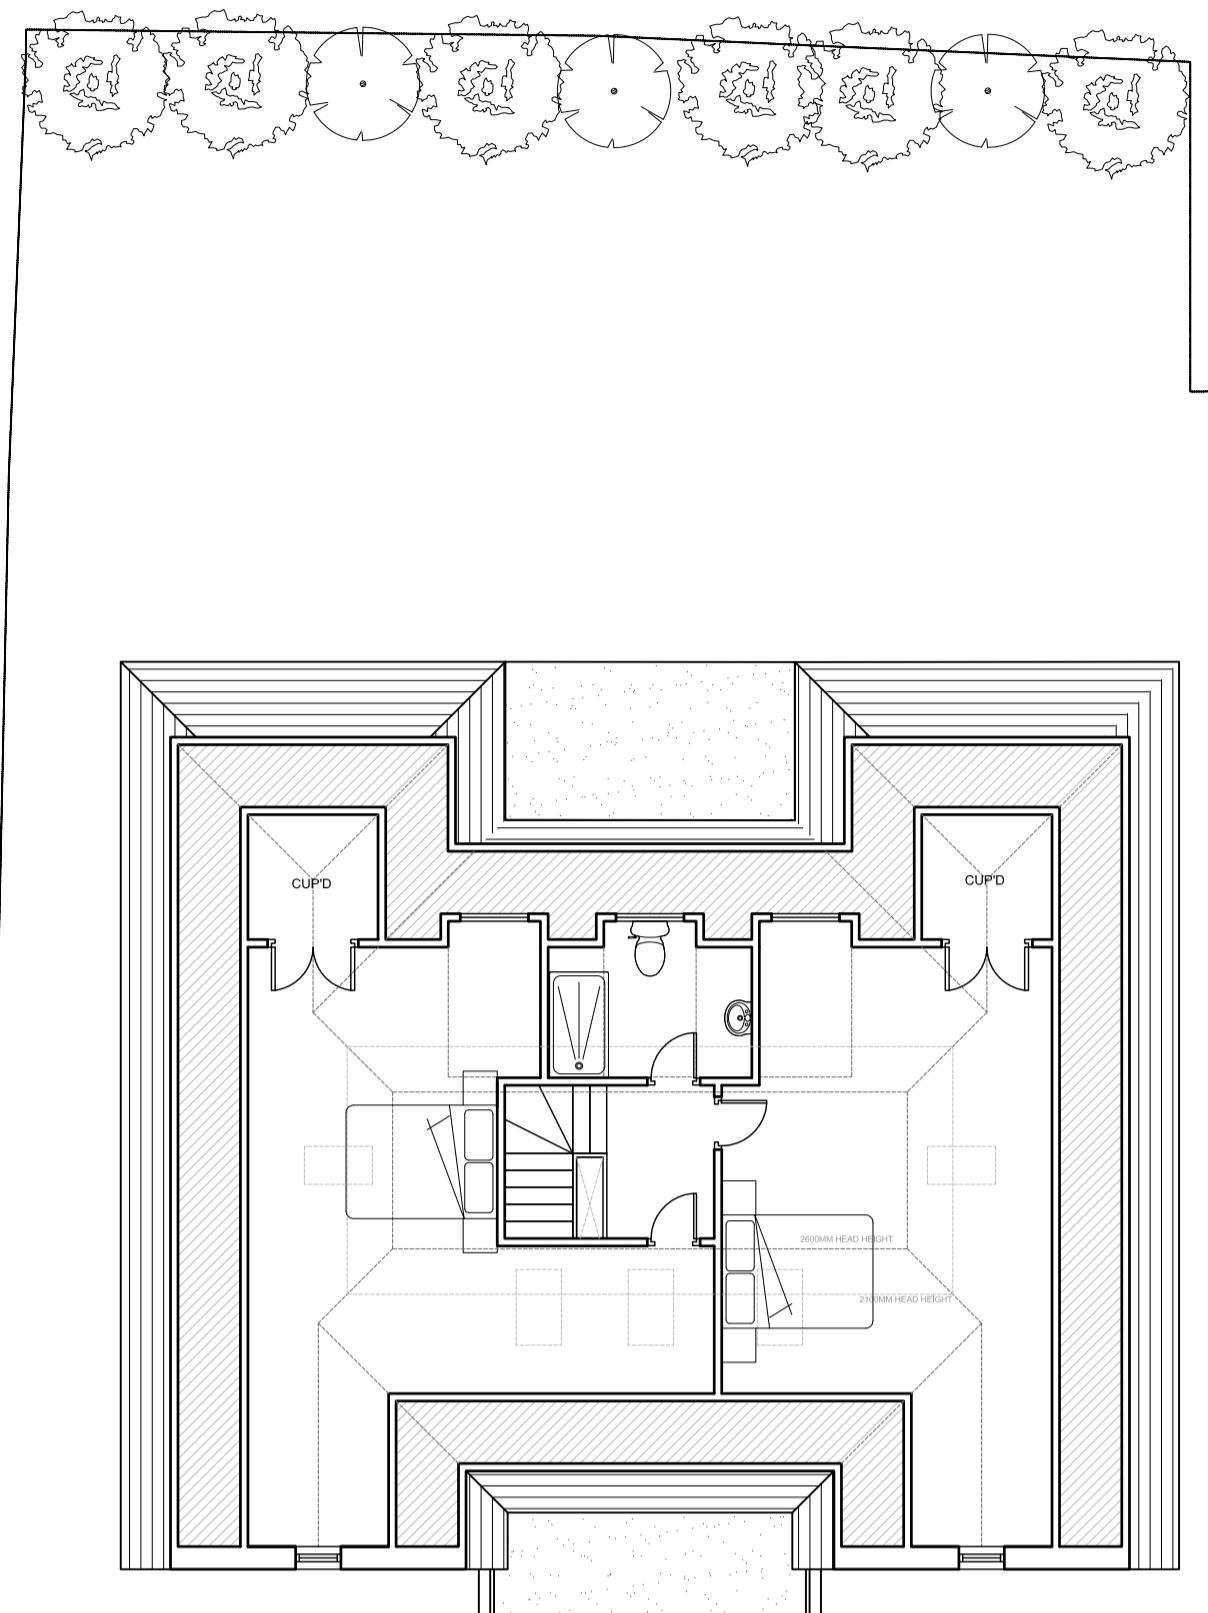


AS BUILT SECOND FLOOR PLAN

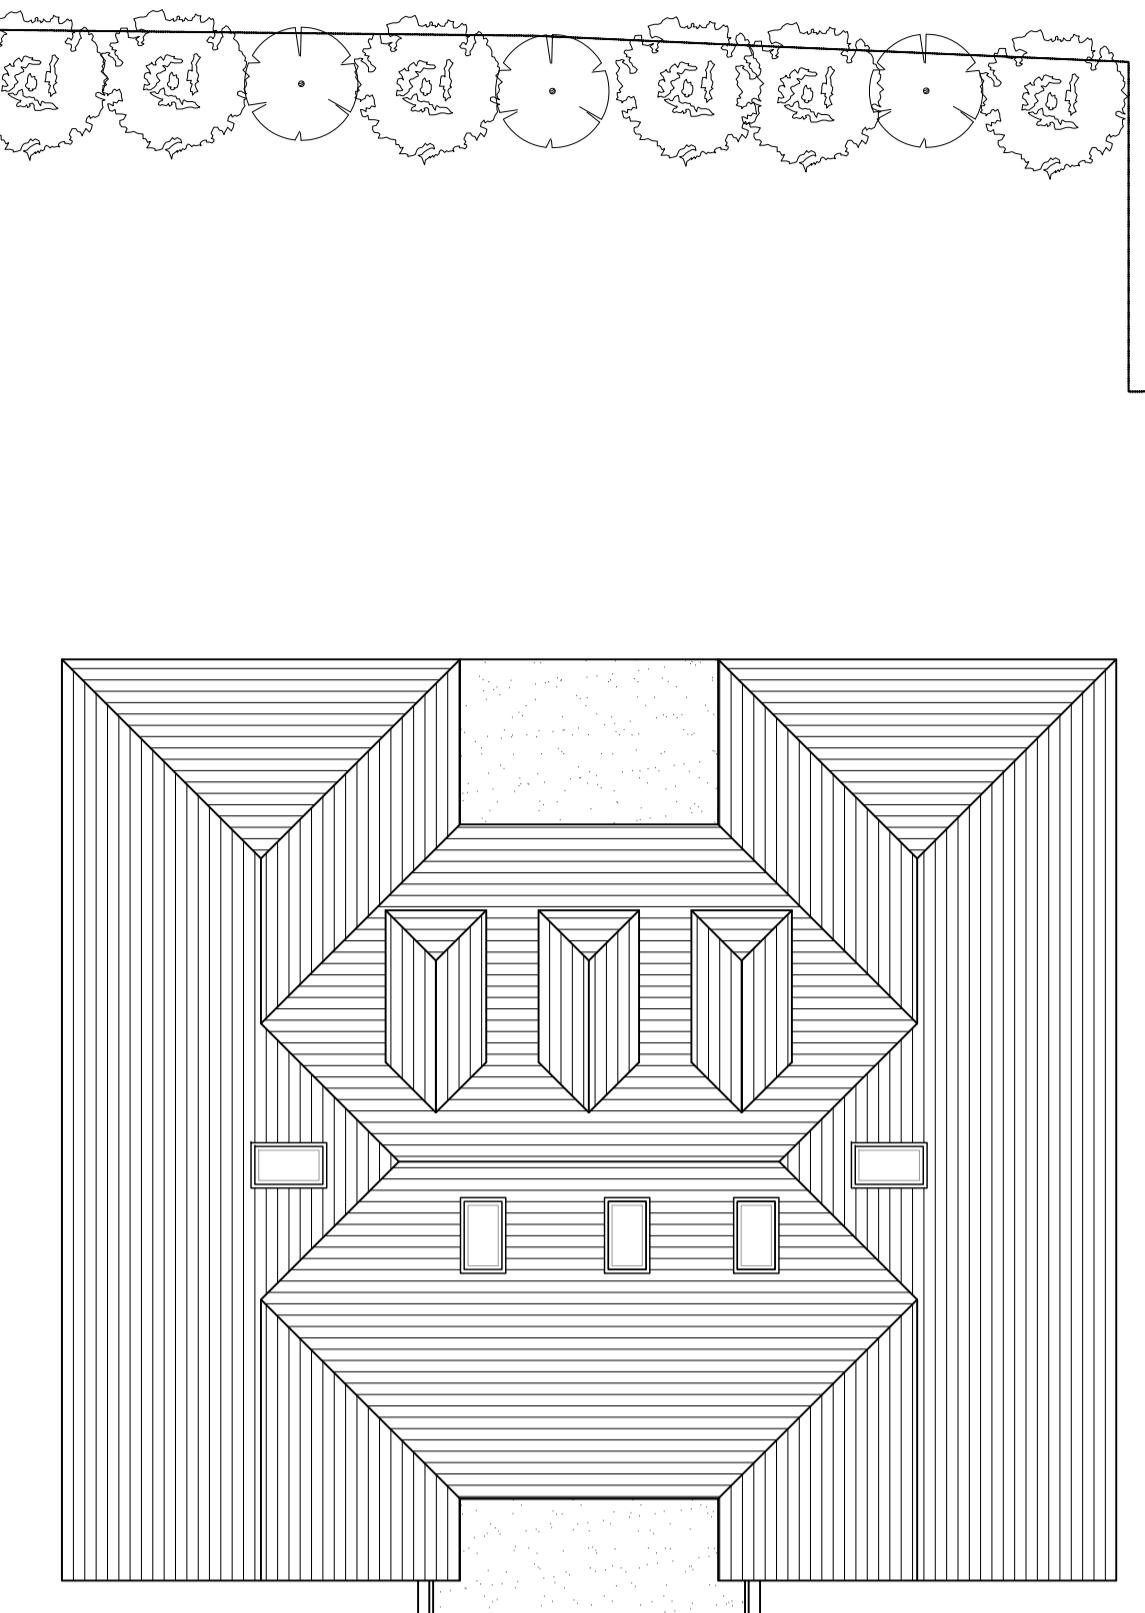



AS BUILT ROOF PLAN



AS BUILT FRONT ELEVATION

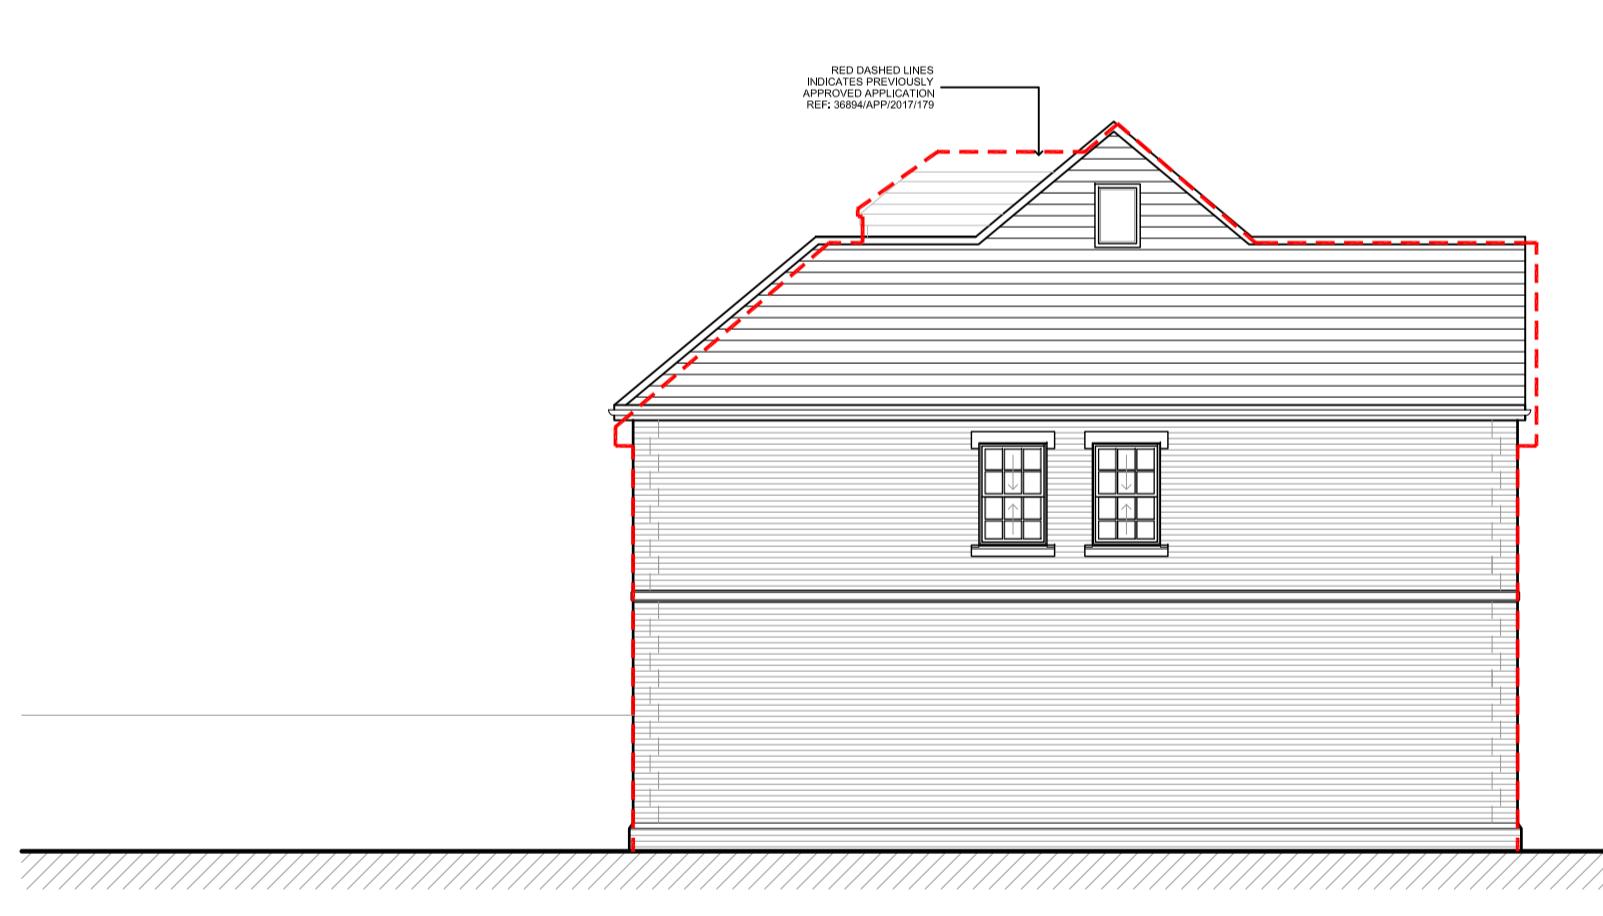

AS BUILT SIDE ELEVATION

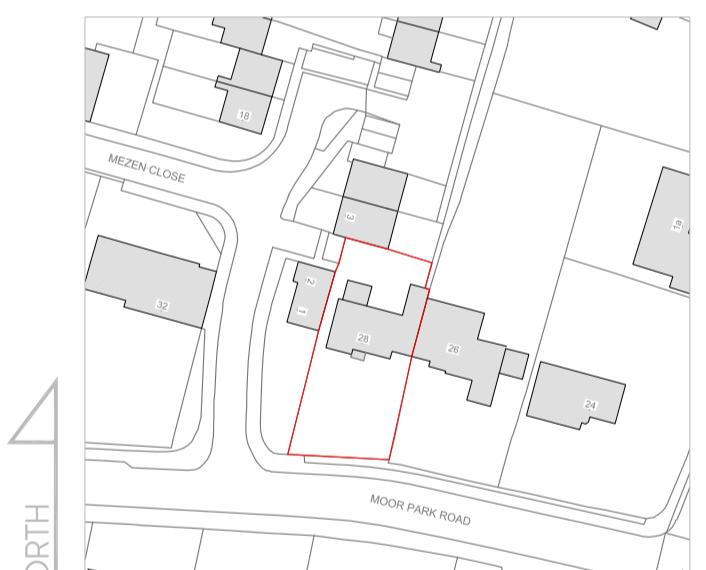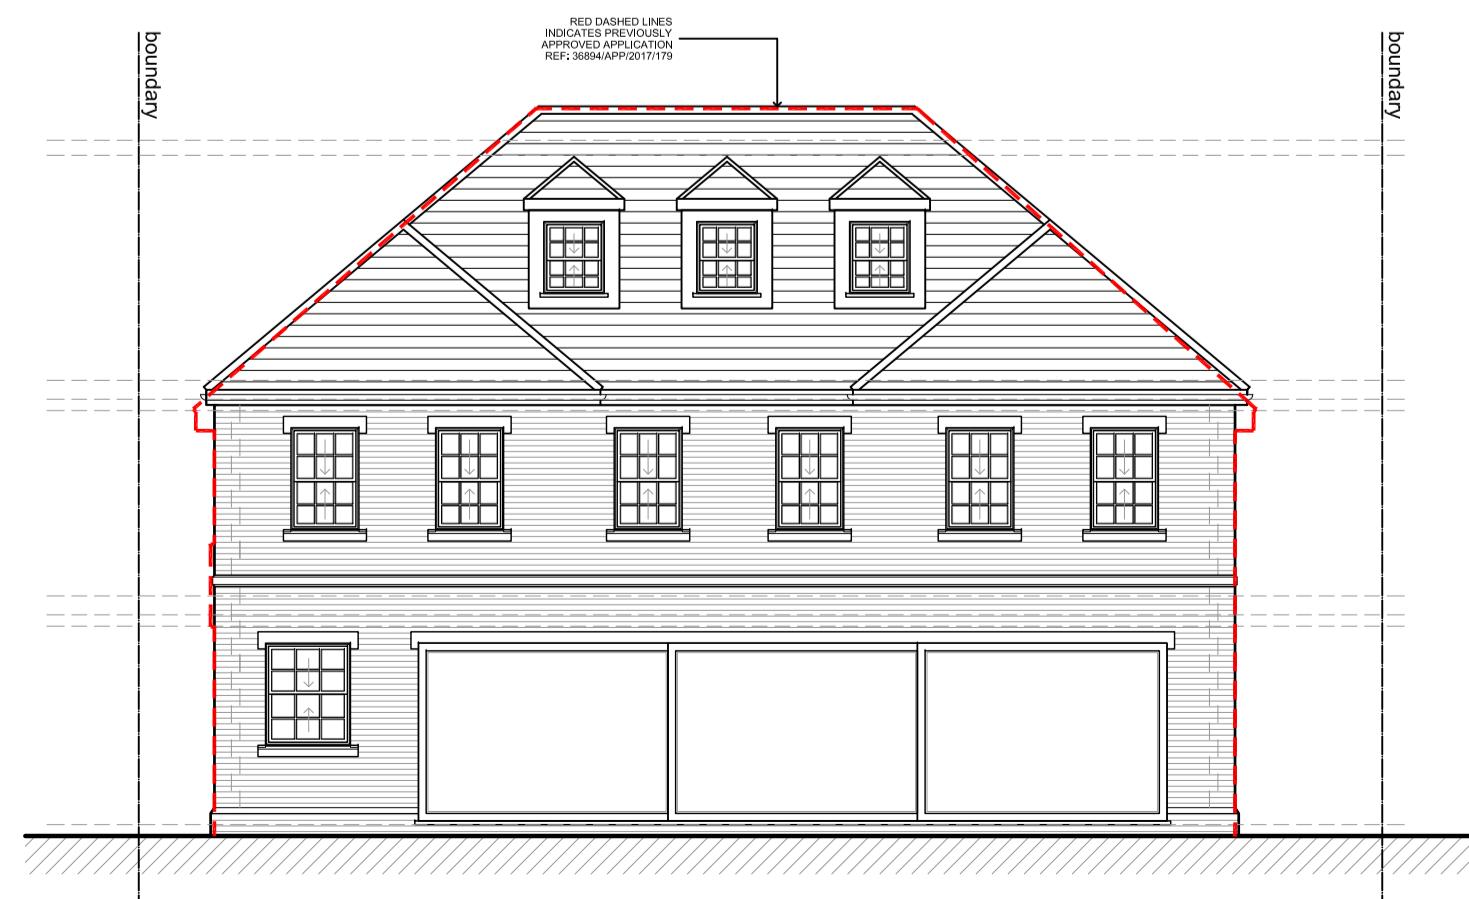

LOCATION PLAN  
SCALE 1:1250

Rev Date Description Init.  
Client

MR & MRS SHAH

Project Title  
PROPOSED NEW DWELLING (RETROSPECTIVE)

28 MOOR PARK ROAD, NORTHWOOD, HA6 2DJ  
Drawing Title

AS BUILT PLANS & ELEVATIONS

Cad File P005	Sheet Size A1	Scale 1:100
Drawn by BR	Drawing Date JAN 2024	Approved by NJ
Project No. 1594	Drawing No. P202	Revision -

**Juttlia  
Architects**  
24 High Street Ruislip  
Middlesex HA4 7AR  
01933 840077 | 01933 840078  
info@juttlia-architects.com  
juttlia-architects.com

This drawing is property of Juttlia Architects Ltd © and must not be copied or otherwise reproduced. All dimensions must be checked on site before commencing work. No dimensions to be scaled from this drawing. This drawing was produced using AutoCad 2016.

PLANNING ISSUE