


NORTH

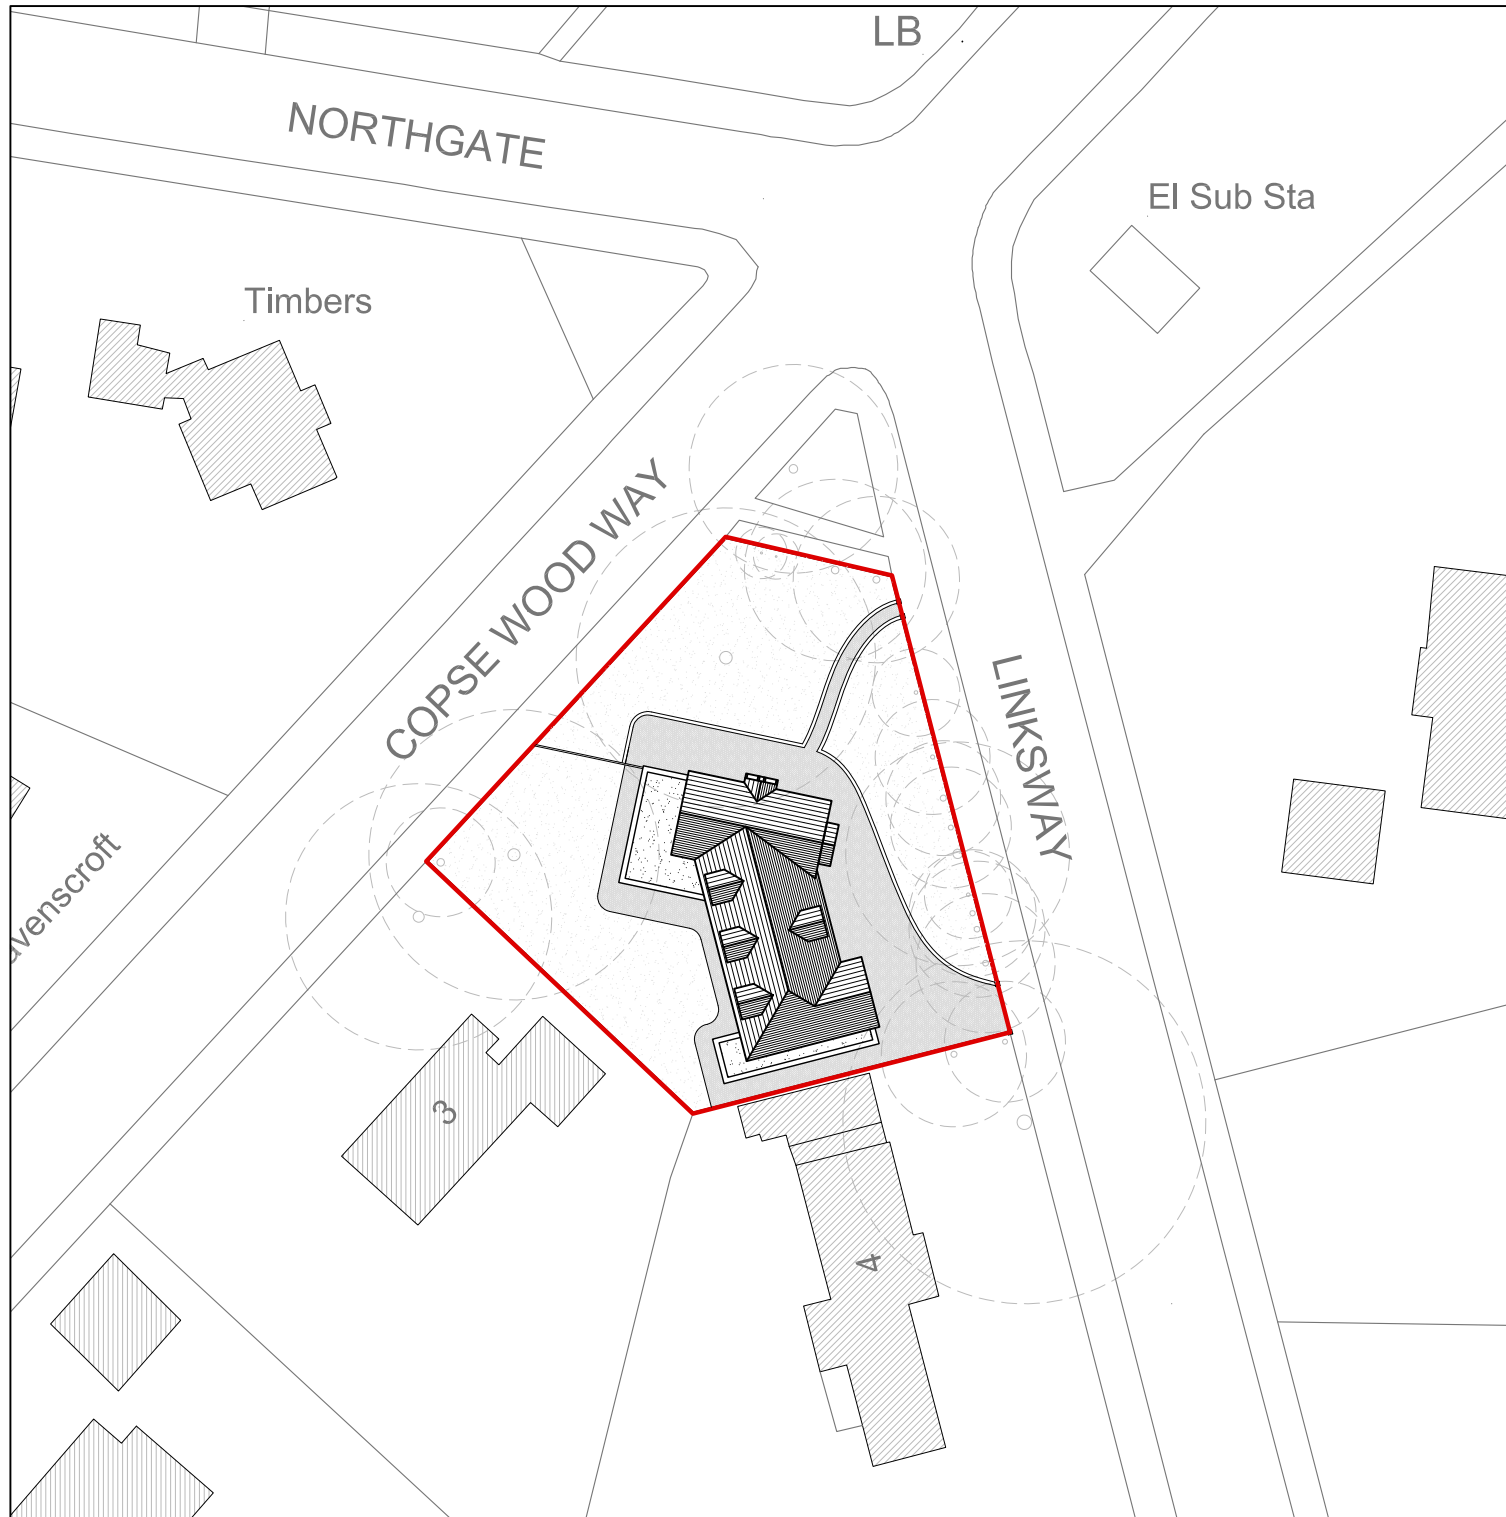

KEY:

— SITE BOUNDARY

- - - - - OUTLINE OF EXISTING TREE CANOPY

Rev	Date	Description	Init.
Client			

MR. K. VHORA

Project Title
PROPOSED EXTENSION TO PROPERTY

2 LINKSWAY, NORTHWOOD, HA6 2XB

Drawing Title

AS BUILT BLOCK PLAN

Cad File	Sheet Size	Scale
A001	A1	1:100
Drawn by	Drawing Date	Approved by
RP	AUG 2016	NJ
Project No.	Drawing No.	Revision
1440	A102	-



Argyle House, Joel Street,
Northwood Hills, Middlesex, HA6 1NW

T 01923 840077 F 01923 840078
info@jutlla-architects.com
jutlla-architects.com

This drawing is property of Jutlla Architects Ltd © and must not be copied or otherwise reproduced. All dimensions must be checked on site before commencing work. No dimensions to be scaled from this drawing. This drawing was produced using AutoCad 2016.

AS BUILT ISSUE