



PRE-EXISTING BLOCK PLAN



PRE-EXISTING FRONT ELEVATION (A)




PRE-EXISTING SIDE ELEVATION (B)




PRE-EXISTING REAR ELEVATION (C)




PRE-EXISTING SIDE ELEVATION (D)

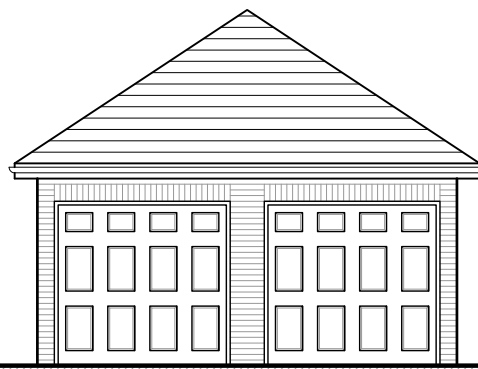



PRE-EXISTING STREET ELEVATION

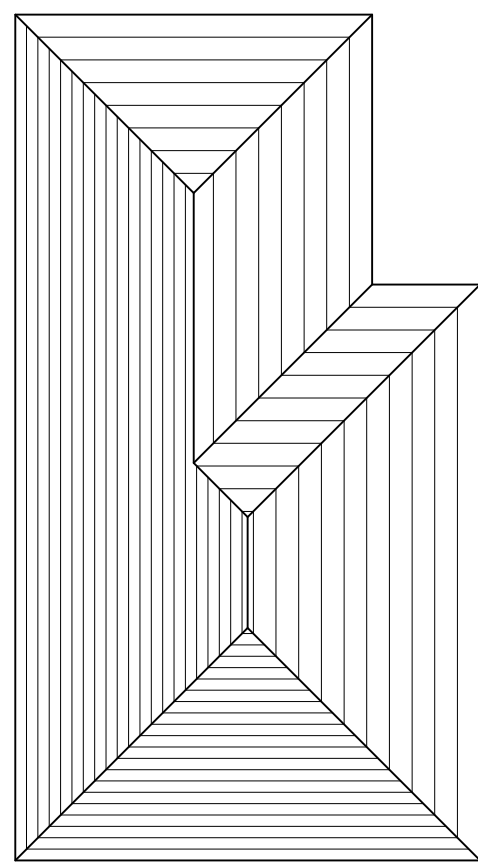


PRE-EXISTING ROOF PLAN

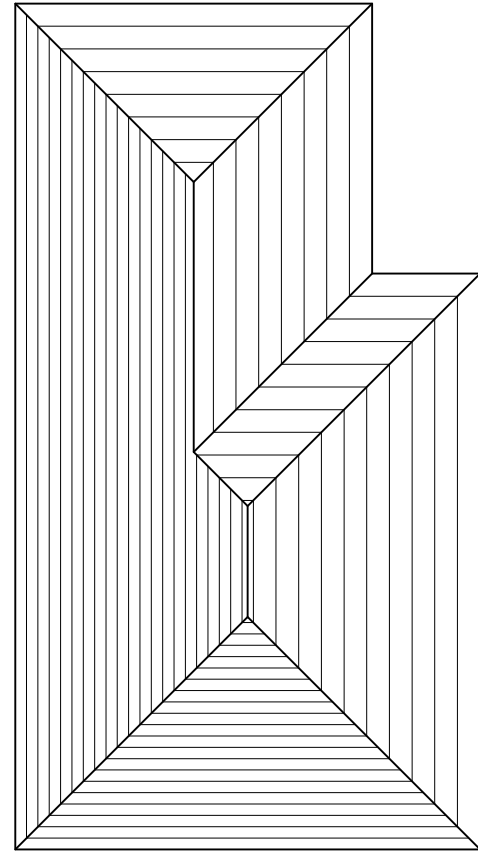


PRE-EXISTING FIRST FLOOR PLAN

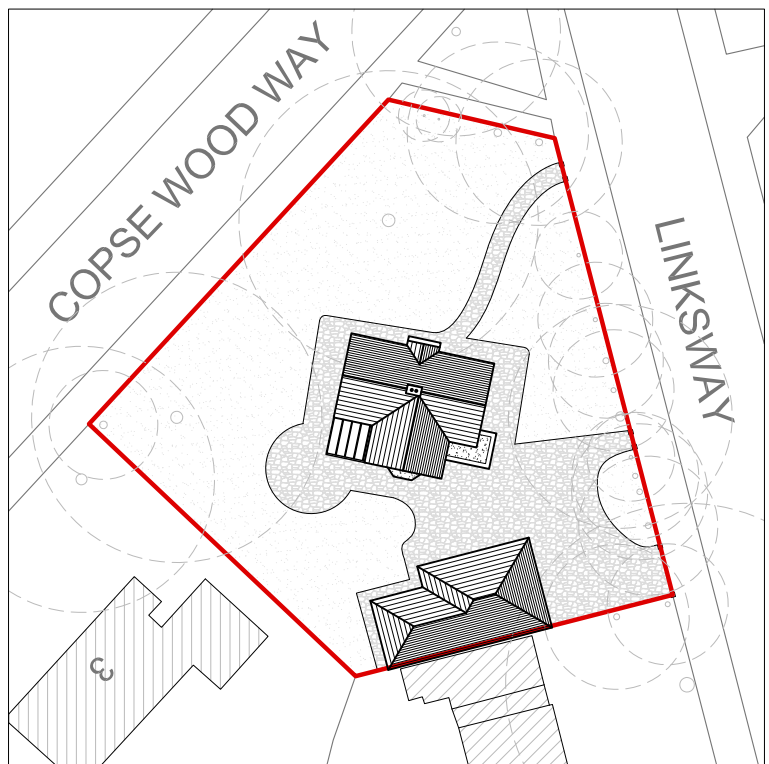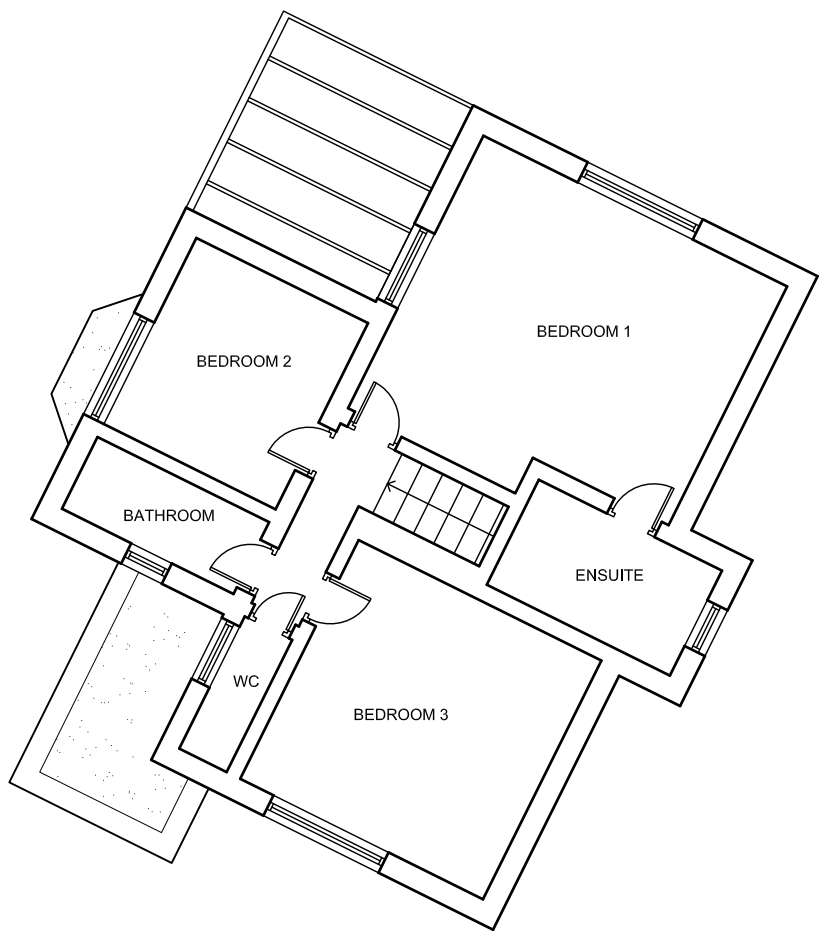


PRE-EXISTING BLOCK PLAN
SCALE 1:500

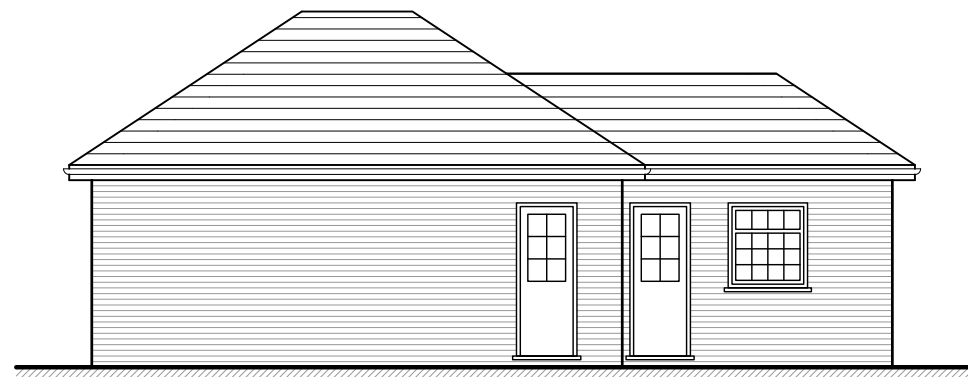

PRE-EXISTING GARAGE SIDE ELEVATION (B)

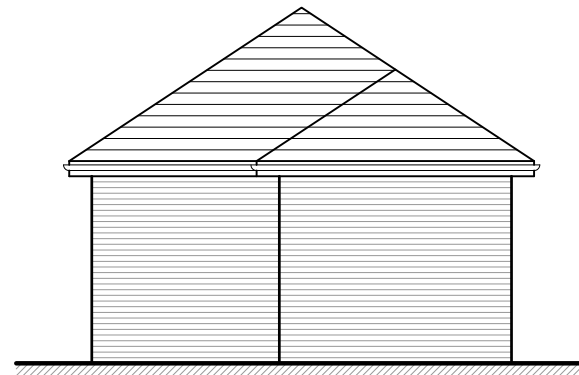

PRE-EXISTING GARAGE REAR ELEVATION (C)

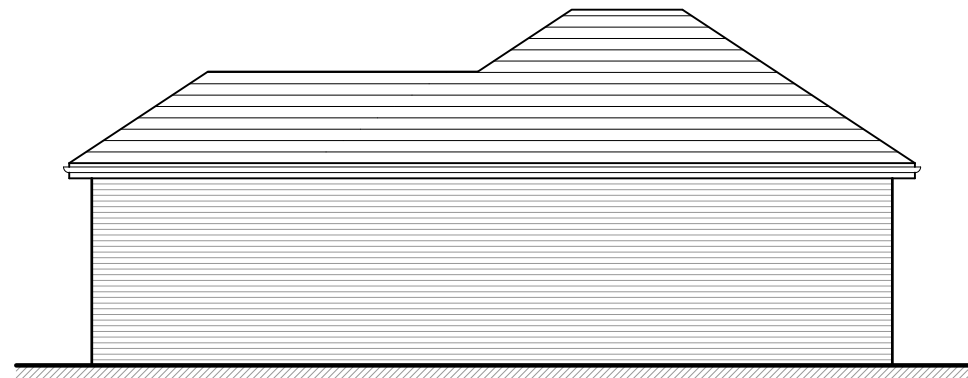

PRE-EXISTING GARAGE SIDE ELEVATION (D)

Rev	Date	Description	Init.
-----	------	-------------	-------

Client

MR. K. VHORA

Project Title
PROPOSED EXTENSION TO PROPERTY

2 LINKSWAY, NORTHWOOD, HA6 2XB

Drawing Title

PRE-EXISTING PLANS & ELEVATIONS

Cad File	Sheet Size	Scale
A001	A1	1:100
Drawn by	Drawing Date	Approved by
RP	AUG 2016	NJ
Project No.	Drawing No.	Revision
1440	A201	-



Argyle House, Joel Street,
Northwood Hills, Middlesex, HA6 1NW

T 01923 840077 F 01923 840078
info@jutla-architects.com
jutla-architects.com

This drawing is property of Jutla Architects Ltd © and must not be
copied or otherwise reproduced. All dimensions must be checked on
site before commencing work. No dimensions to be scaled from this
drawing. This drawing was produced using AutoCad 2016.

AS BUILT ISSUE