




APPROVED BLOCK PLAN




APPROVED FRONT ELEVATION (B)



APPROVED SIDE ELEVATION (C)

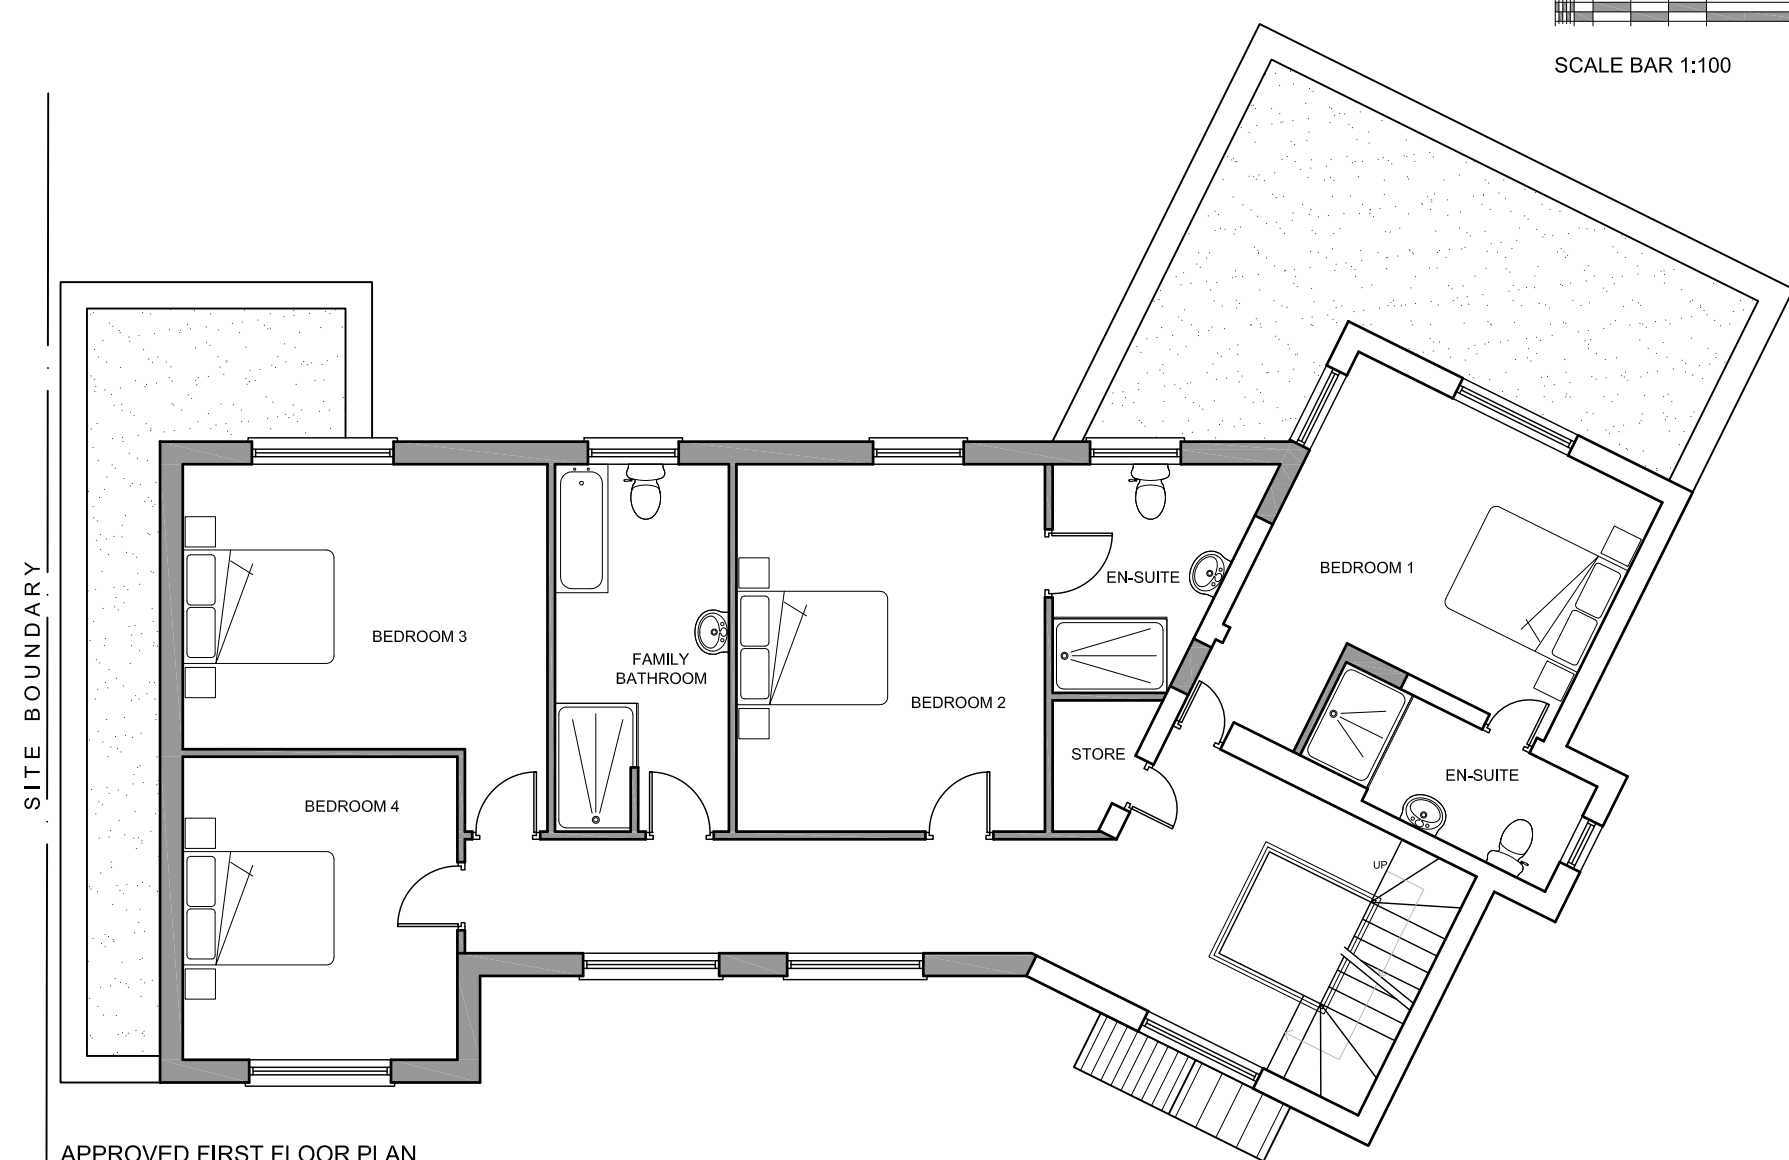

APPROVED FIRST FLOOR PLAN

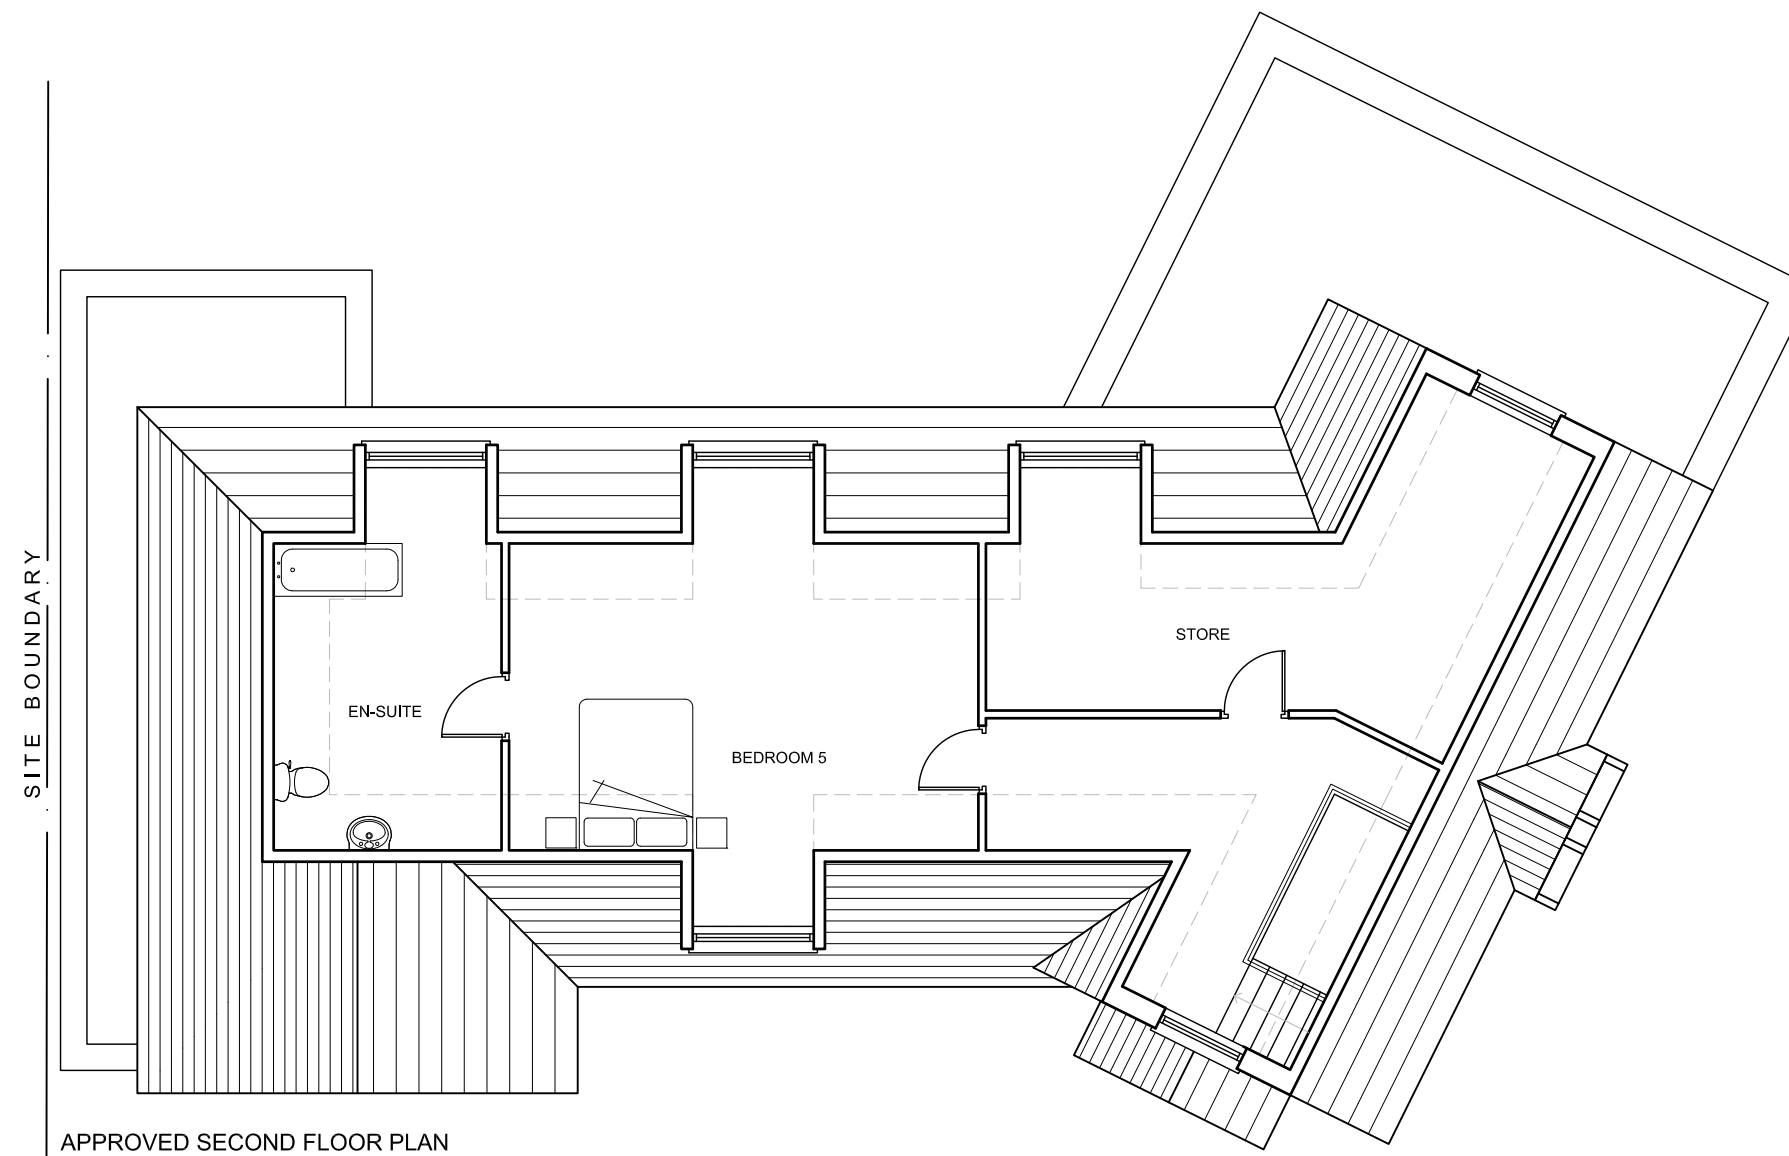

APPROVED SECOND FLOOR PLAN




APPROVED FRONT ELEVATION (A)




APPROVED SIDE ELEVATION (E)



APPROVED REAR ELEVATION (D)

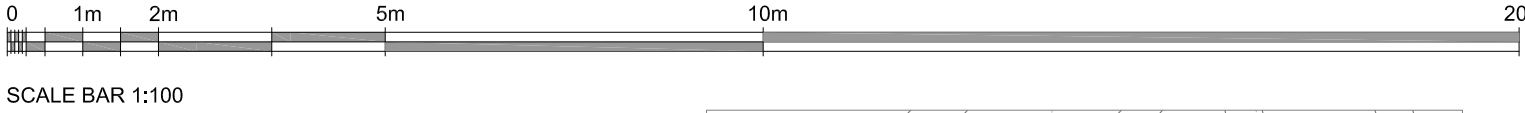

SCALE BAR 1:100

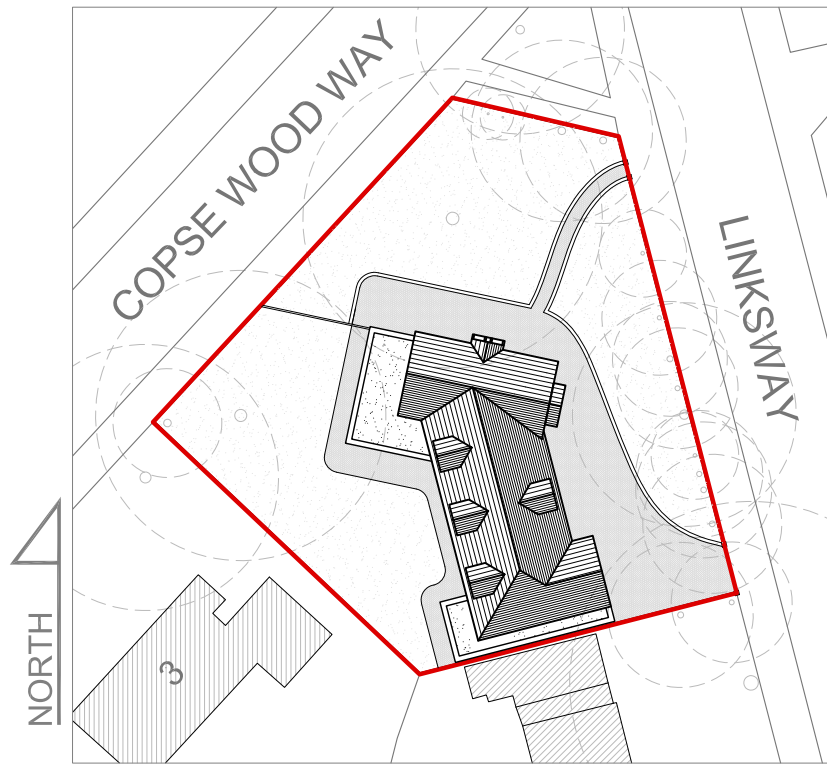

APPROVED BLOCK PLAN
SCALE 1:500

- ① FACING BRICKWORK TO MATCH EXISTING
- ② DOUBLE GLAZED WINDOW WITH SOLDIER COURSE HEAD DETAIL TO MATCH EXISTING
- ③ PLAIN ROOFING TILES TO MATCH EXISTING
- ④ HIPPED ROOF DORMER WITH MATCHING ROOF TILES AND WINDOWS
- ⑤ SELF COLOURED RENDER TO NEW EXTENSION
- ⑥ BRICK ON EDGE DETAILING TO ALL ELEVATIONS
- ⑦ HIPPED ROOF PORCH WITH TIMBER POSTS
- ⑧ PLAT ROOF WITH PARAPET AND CONCRETE BOX GUTTERS
- ⑨ VERTICAL TILING TO DORMER WINDOW IN MATCHING ROOF TILES TO MAIN ROOF
- ⑩ DOUBLE GLAZED SLIDING FOLDING DOORS IN MATCHING STYLE TO MAIN WINDOWS

Rev	Date	Description	Init.
A	05.12.16	AS BUILT ROOF HEIGHTS CORRECTED	RP

Client

MR. K. Vhora

Project Title
PROPOSED EXTENSION TO PROPERTY

2 LINKSWAY, NORTHWOOD, HA6 2XB

Drawing Title

APPROVED PLANS & ELEVATIONS

Cad File	Sheet Size	Scale
A001	A1	1:100
Drawn by	Drawing Date	Approved by
RP	NOV 2016	NJ
Project No.	Drawing No.	Revision
1440	A202	A

Jutla Architects

Argyle House, Joel Street,
Northwood Hills, Middlesbrough, HA6 1NW
t 01923 840077 f 01923 840078
info@jutla-architects.com
jutla-architects.com

This drawing is property of Jutla Architects Ltd © and must not be copied or otherwise reproduced. All dimensions must be checked on site before commencing work. No dimensions to be scaled from this drawing. This drawing was produced using AutoCad 2016.

AS BUILT ISSUE