






FRONT ELEVATION  
1:100

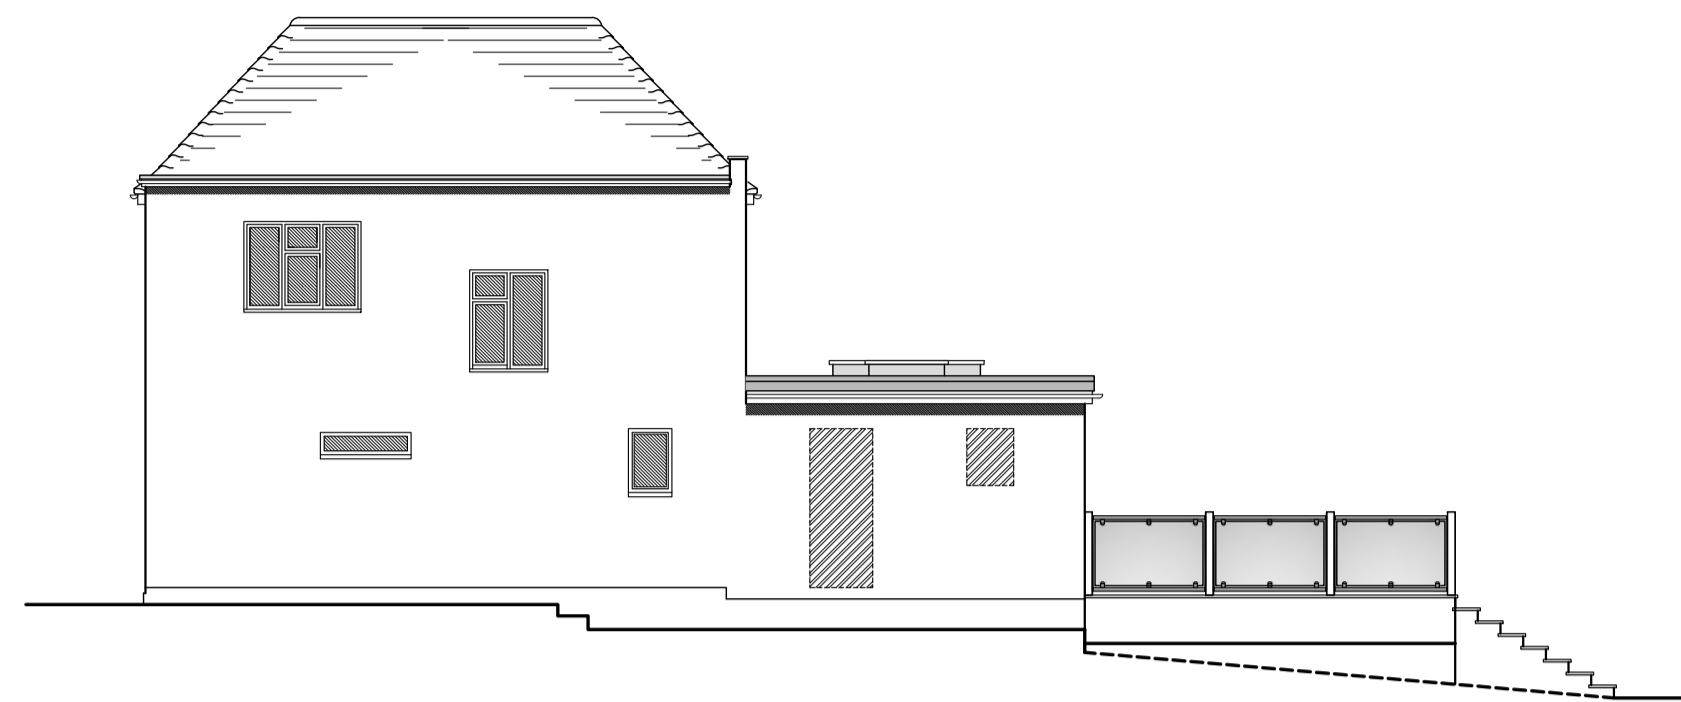


SIDE ELEVATION  
1:100

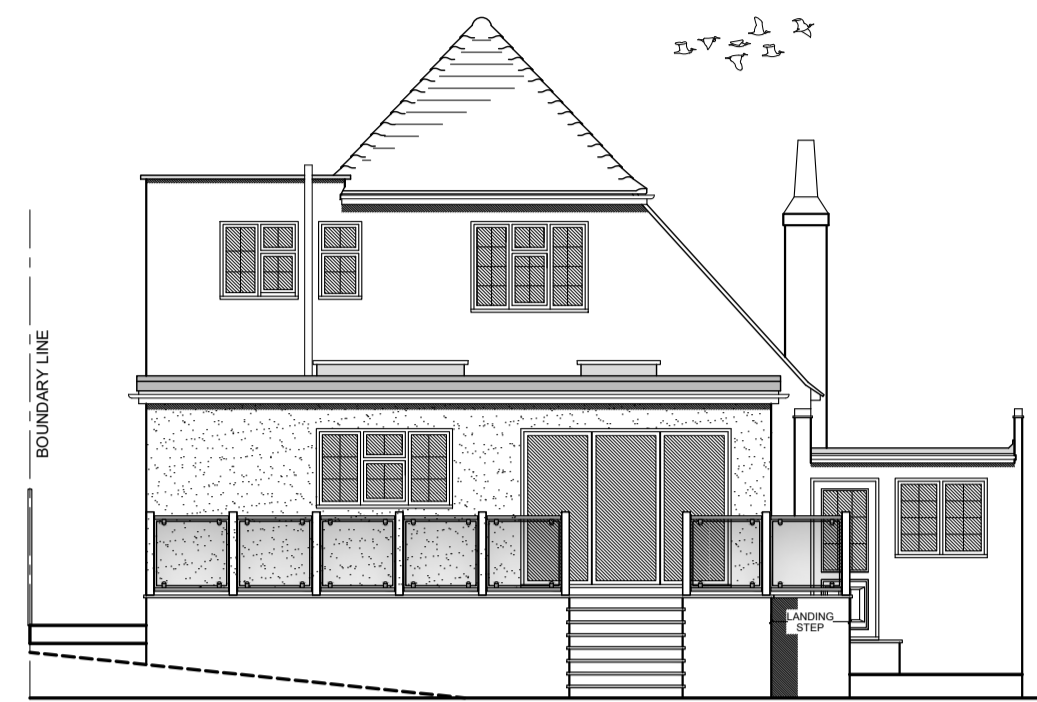


REAR ELEVATION  
1:100

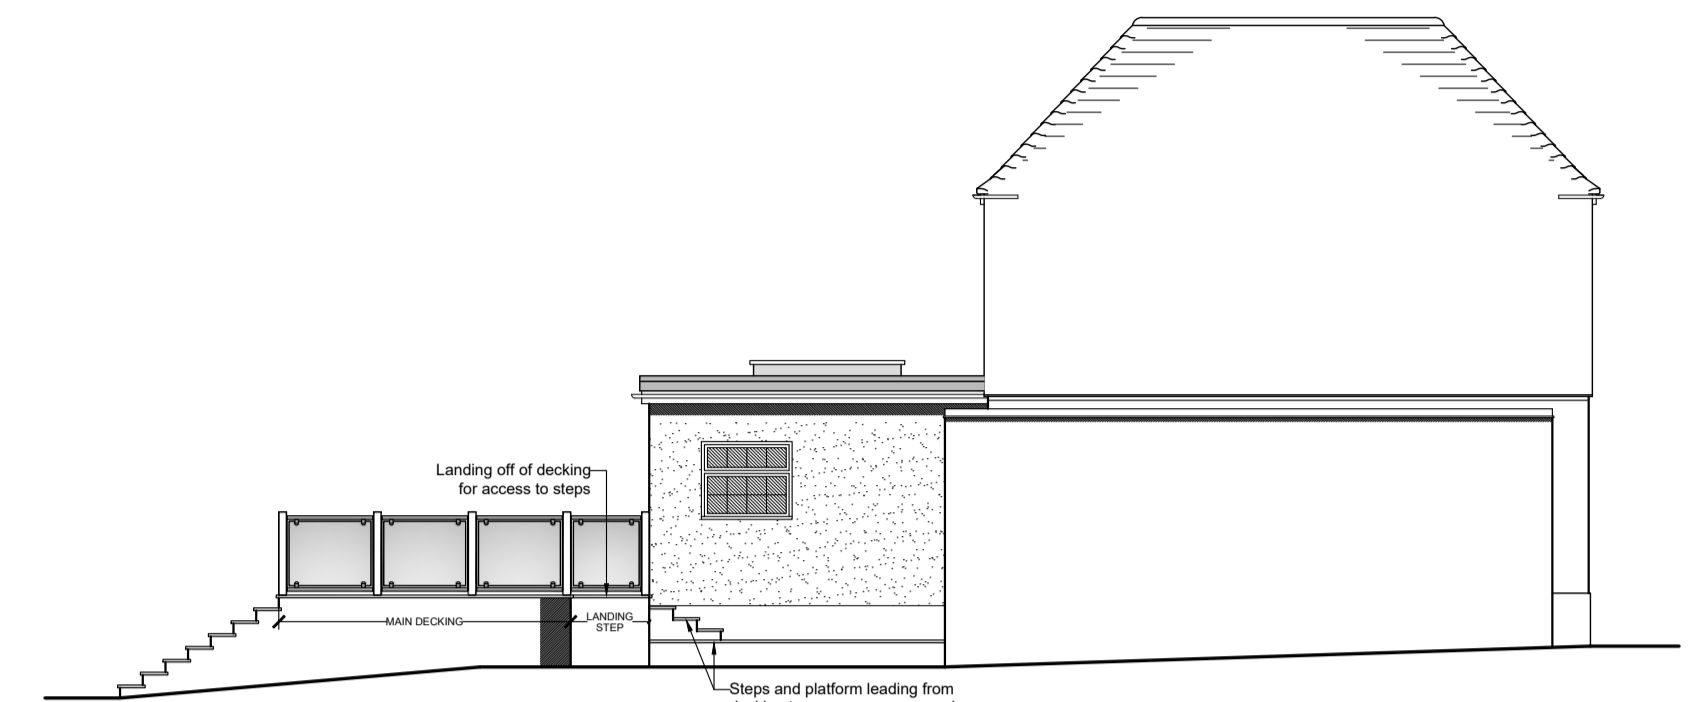


SIDE ELEVATION  
1:100

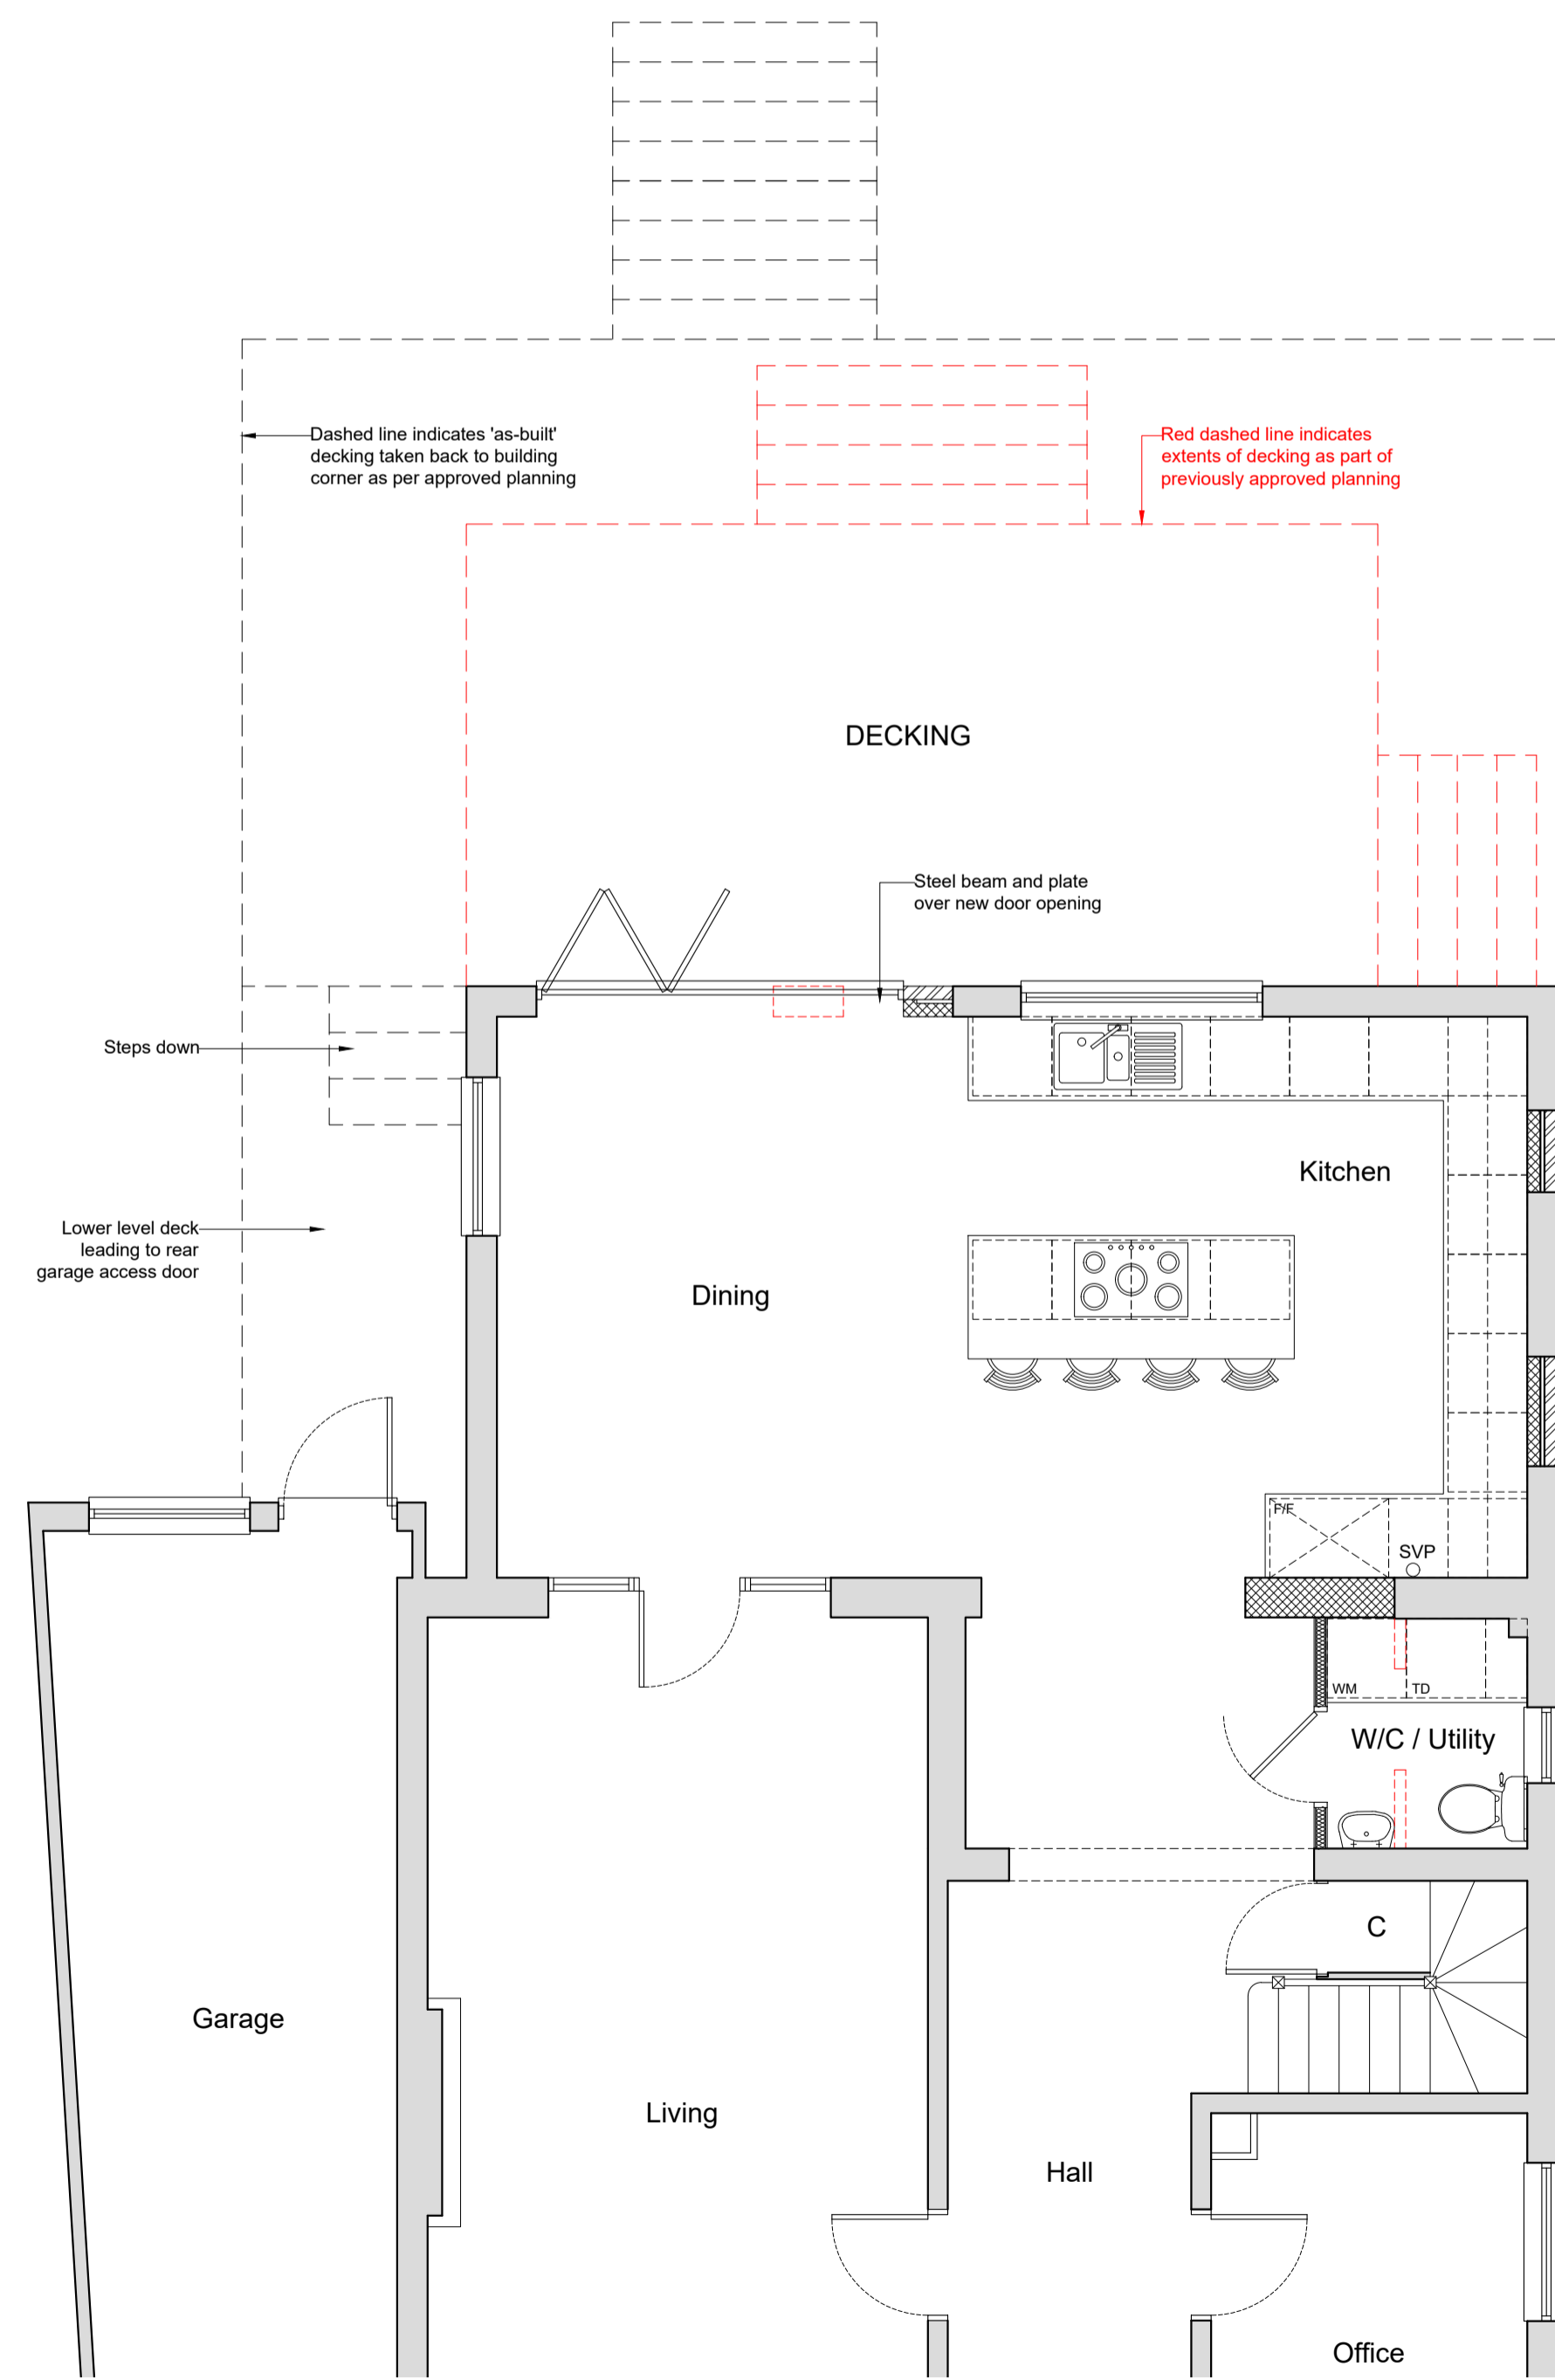

GROUND FLOOR PLAN  
(showing full extents of as-built decking)  
1:500

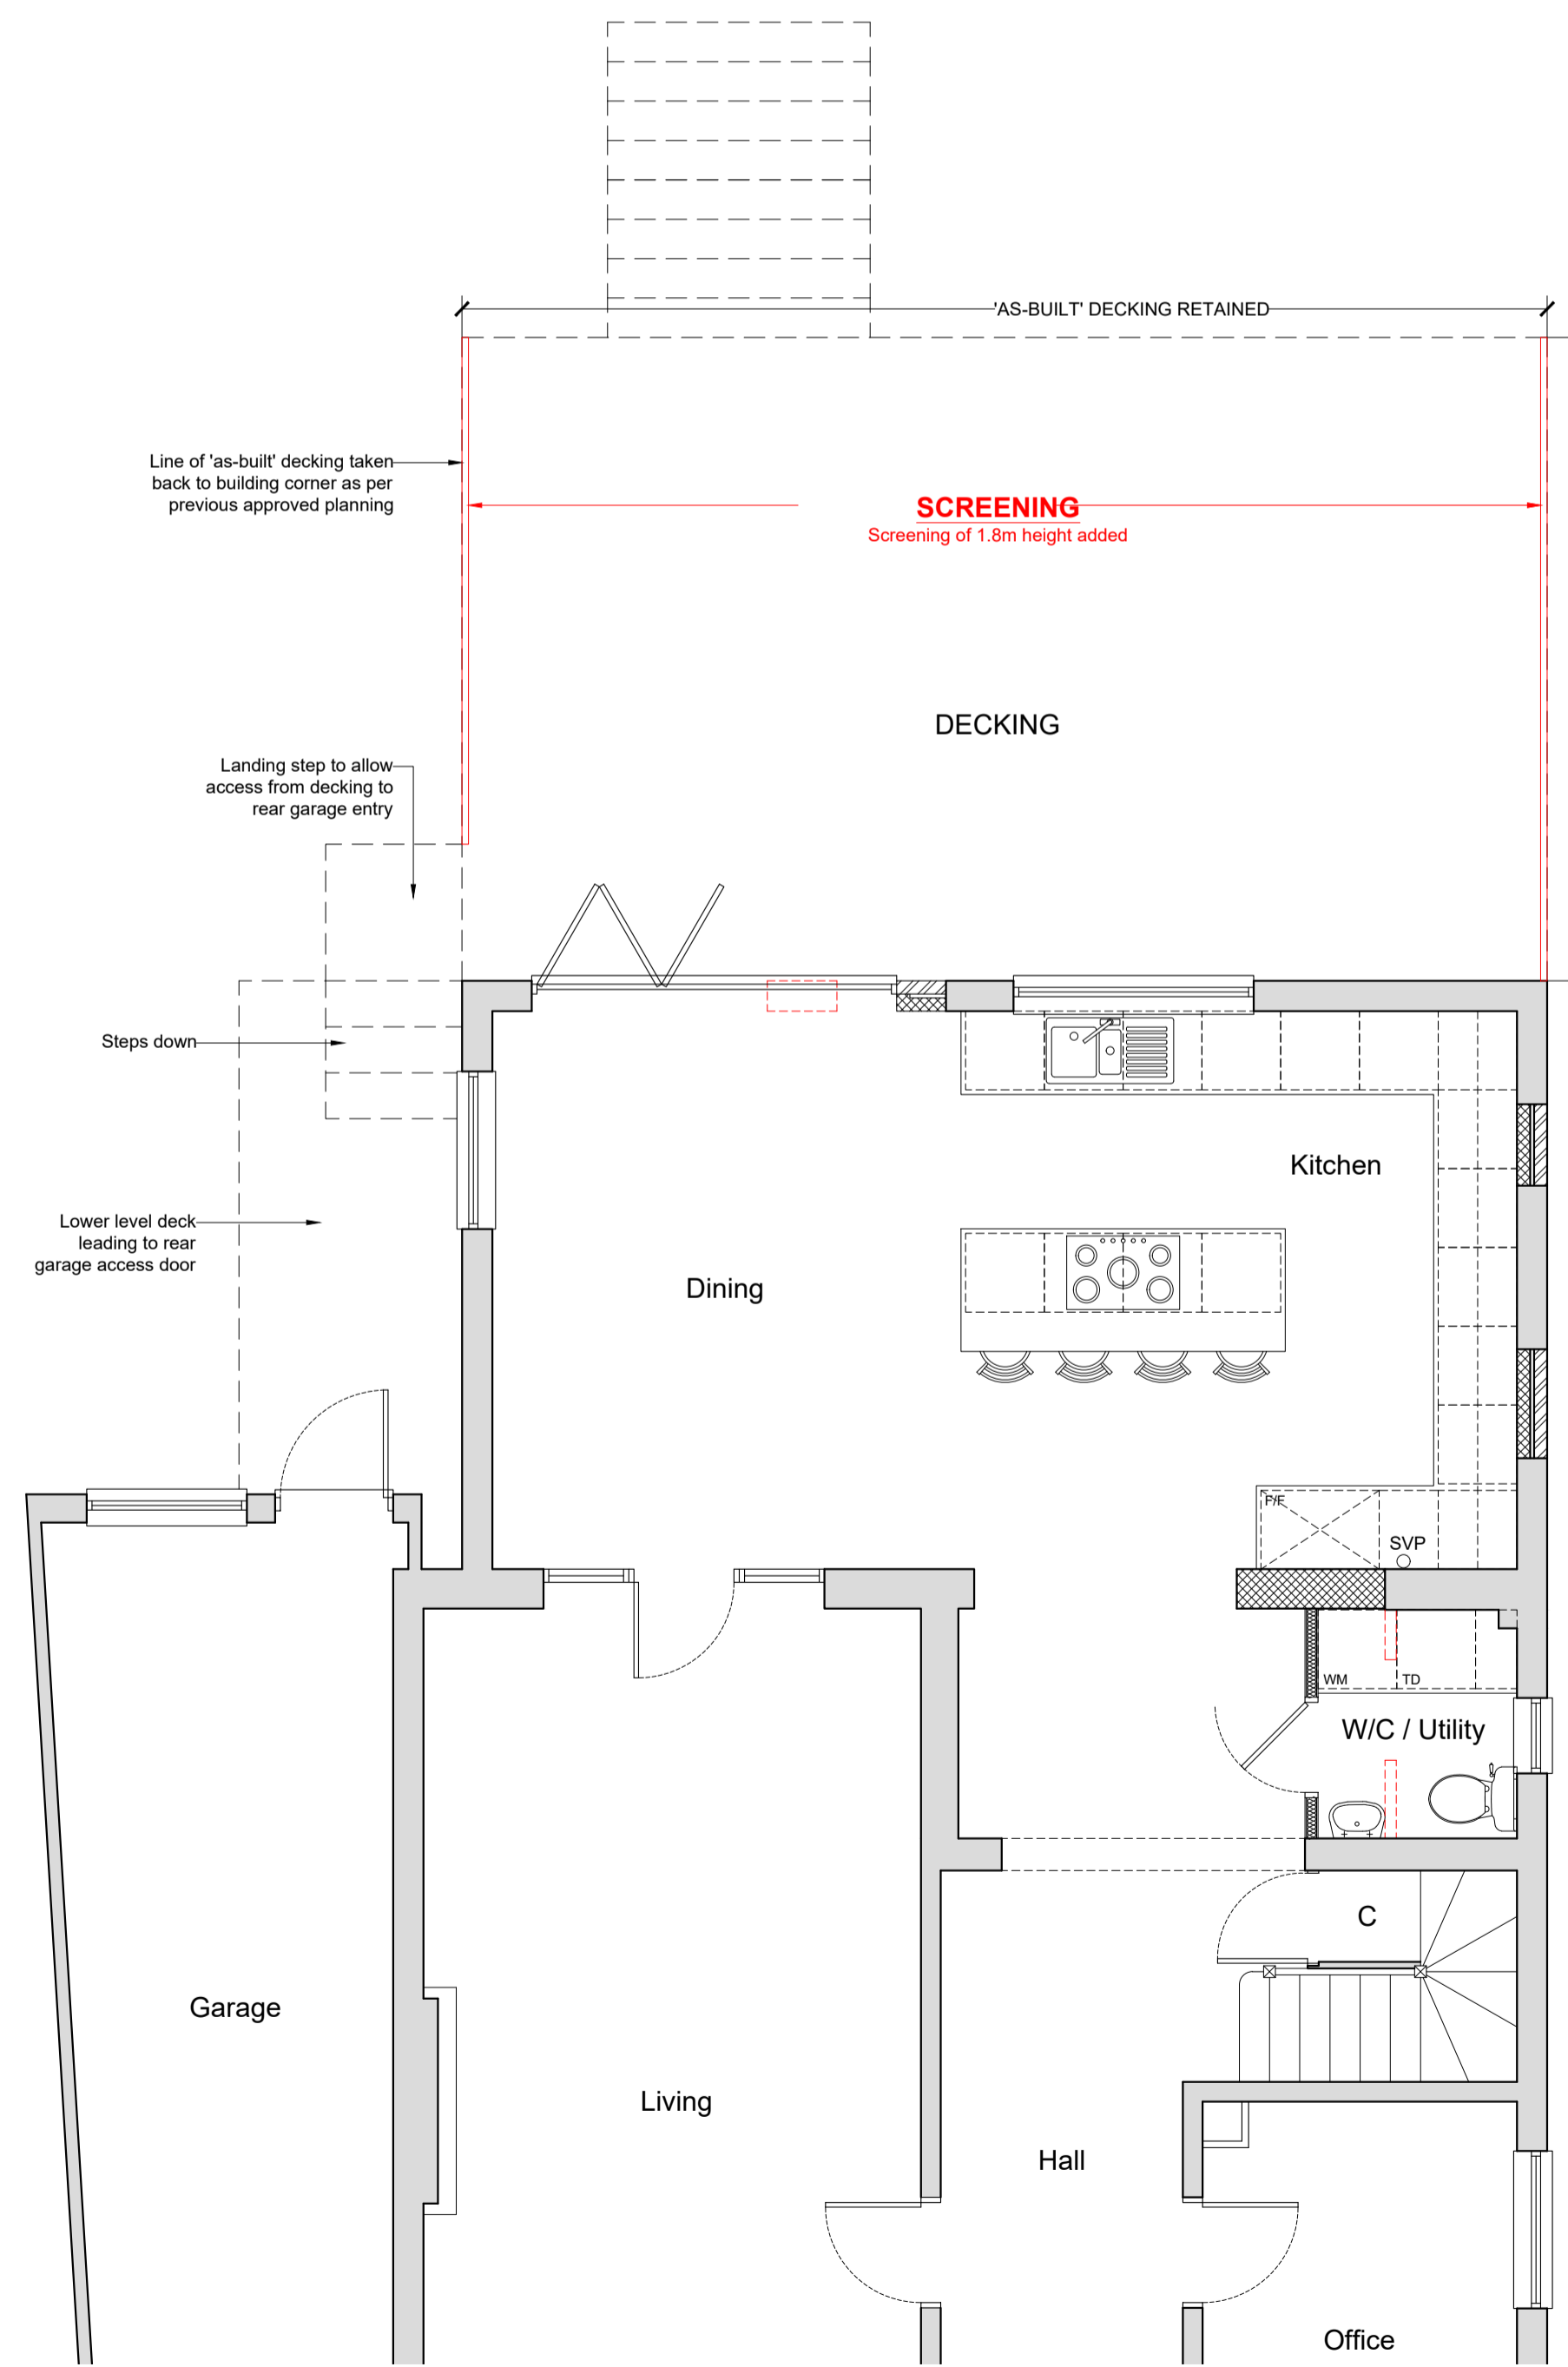



GROUND FLOOR PLAN  
(showing proposed decking adaptations for section 73)  
1:500

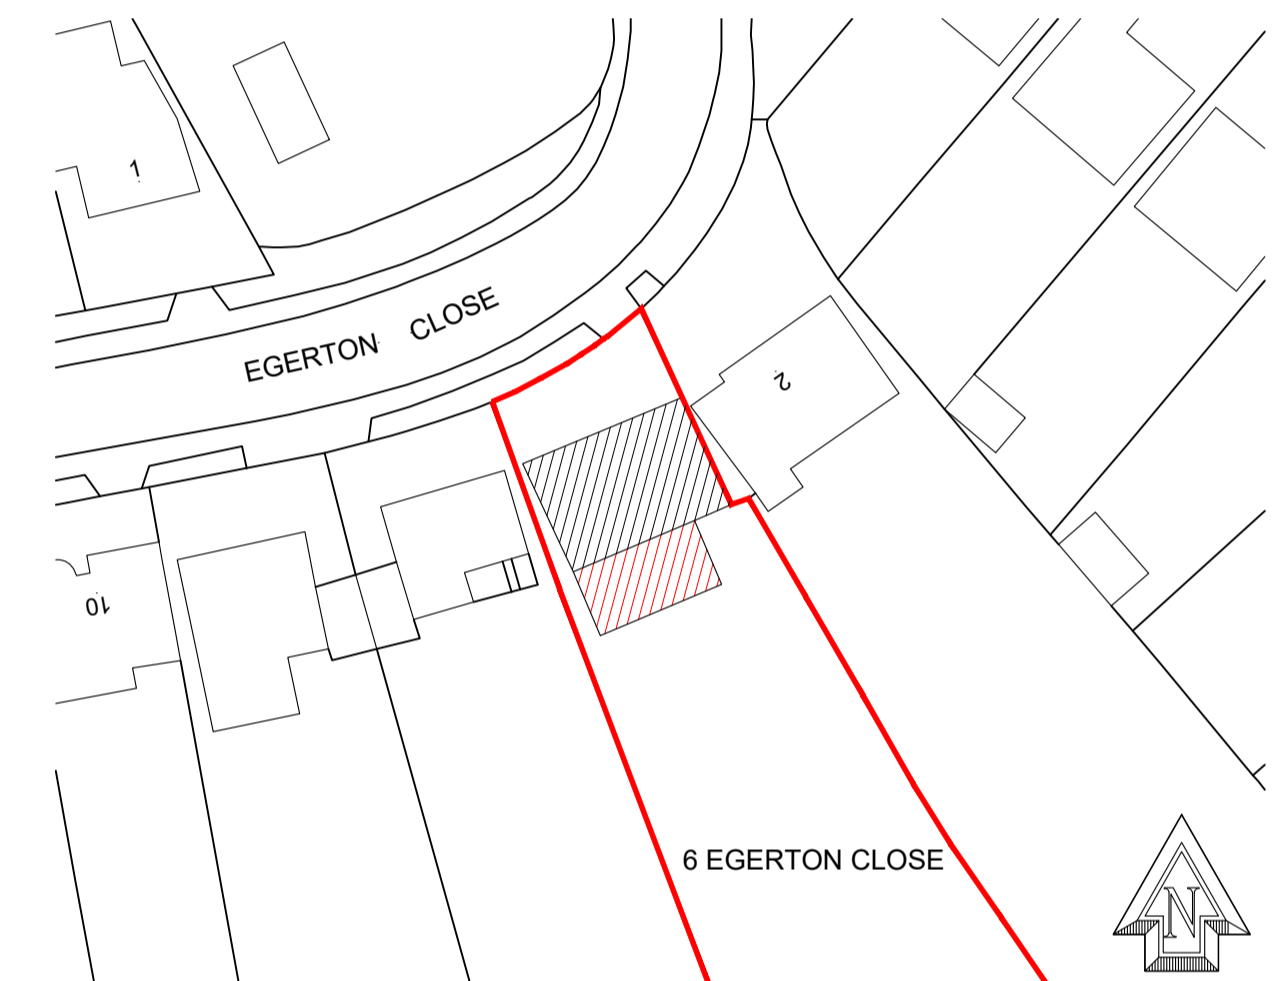

©Crown Copyright. All rights reserved. Licence no. 100019980  
BLOCK PLAN  
1:500

PLANS/ELEVATIONS KEY

	Existing Masonry
	New Brickwork
	New Blockwork
	New Roof
	Insulation
	Demolition
	Fence

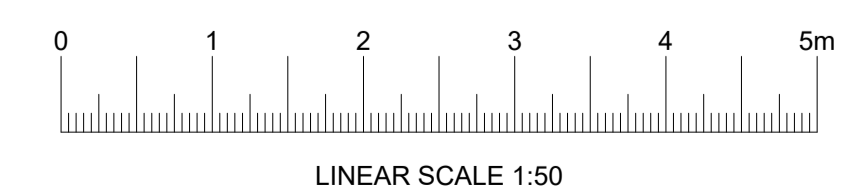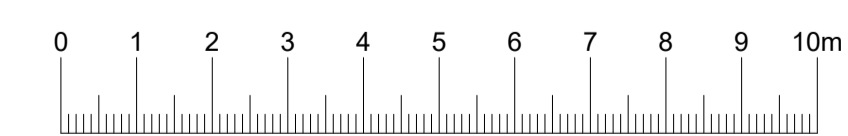

Client:  
Mr & Mrs T Murkett

Address:  
4 Egerton Close,  
Pinner,  
HA5 2LP

Drawing Title:  
*Section 73: Proposed Decking  
Adaptions*

Date  
January 2026

Scale @ A1  
1:50 / 1:100 / 1:500

Rev.	Date	Description
#	20.01.26	Plans/Elevs: patio decking amended to show 'as-built' and further revisions for Section 73.
A	25.02.26	Note added to plan at PO's request: 1.8m ht screening to be installed to both sides of deck.

Drawing No  
PL-003.A

