




FRONT ELEVATION
1:100

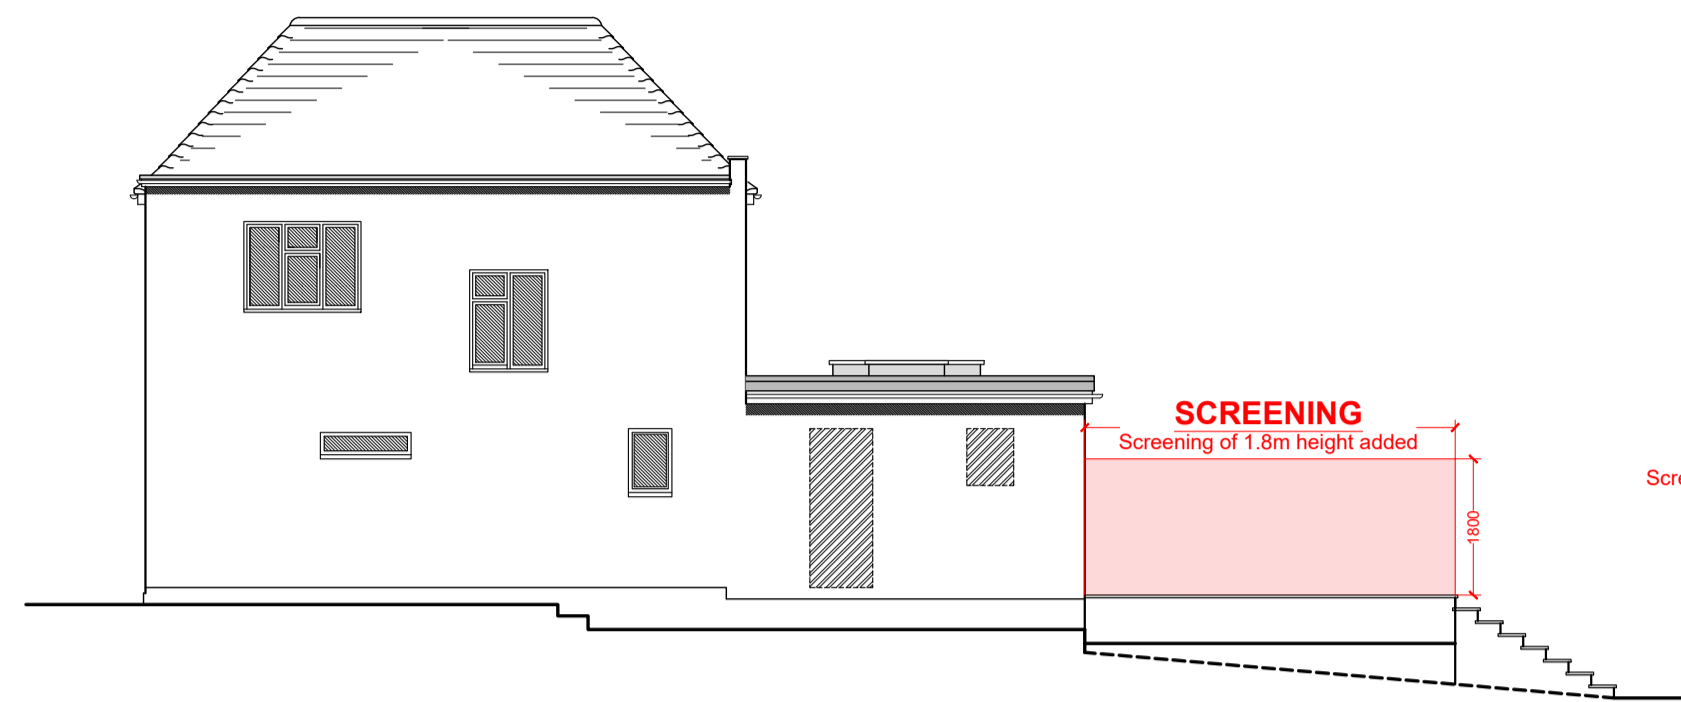


SIDE ELEVATION
1:100

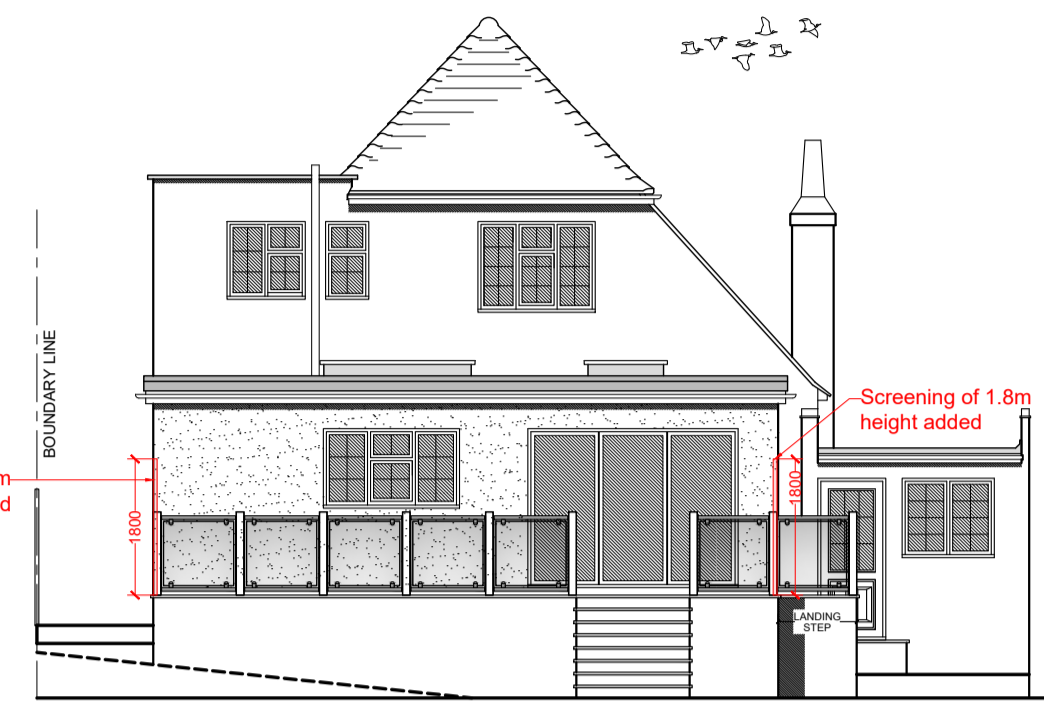


REAR ELEVATION
1:100

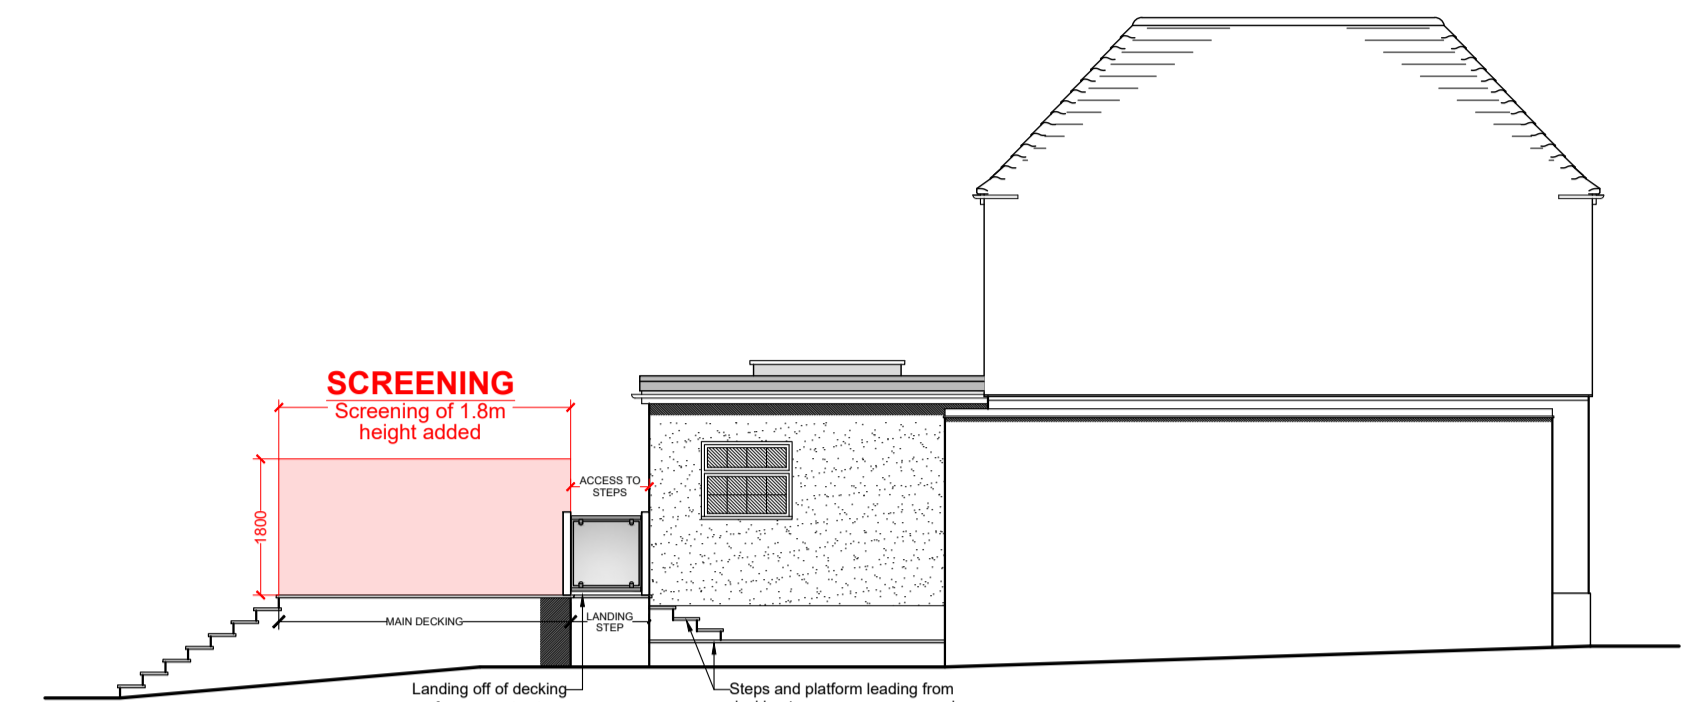


SIDE ELEVATION
1:100

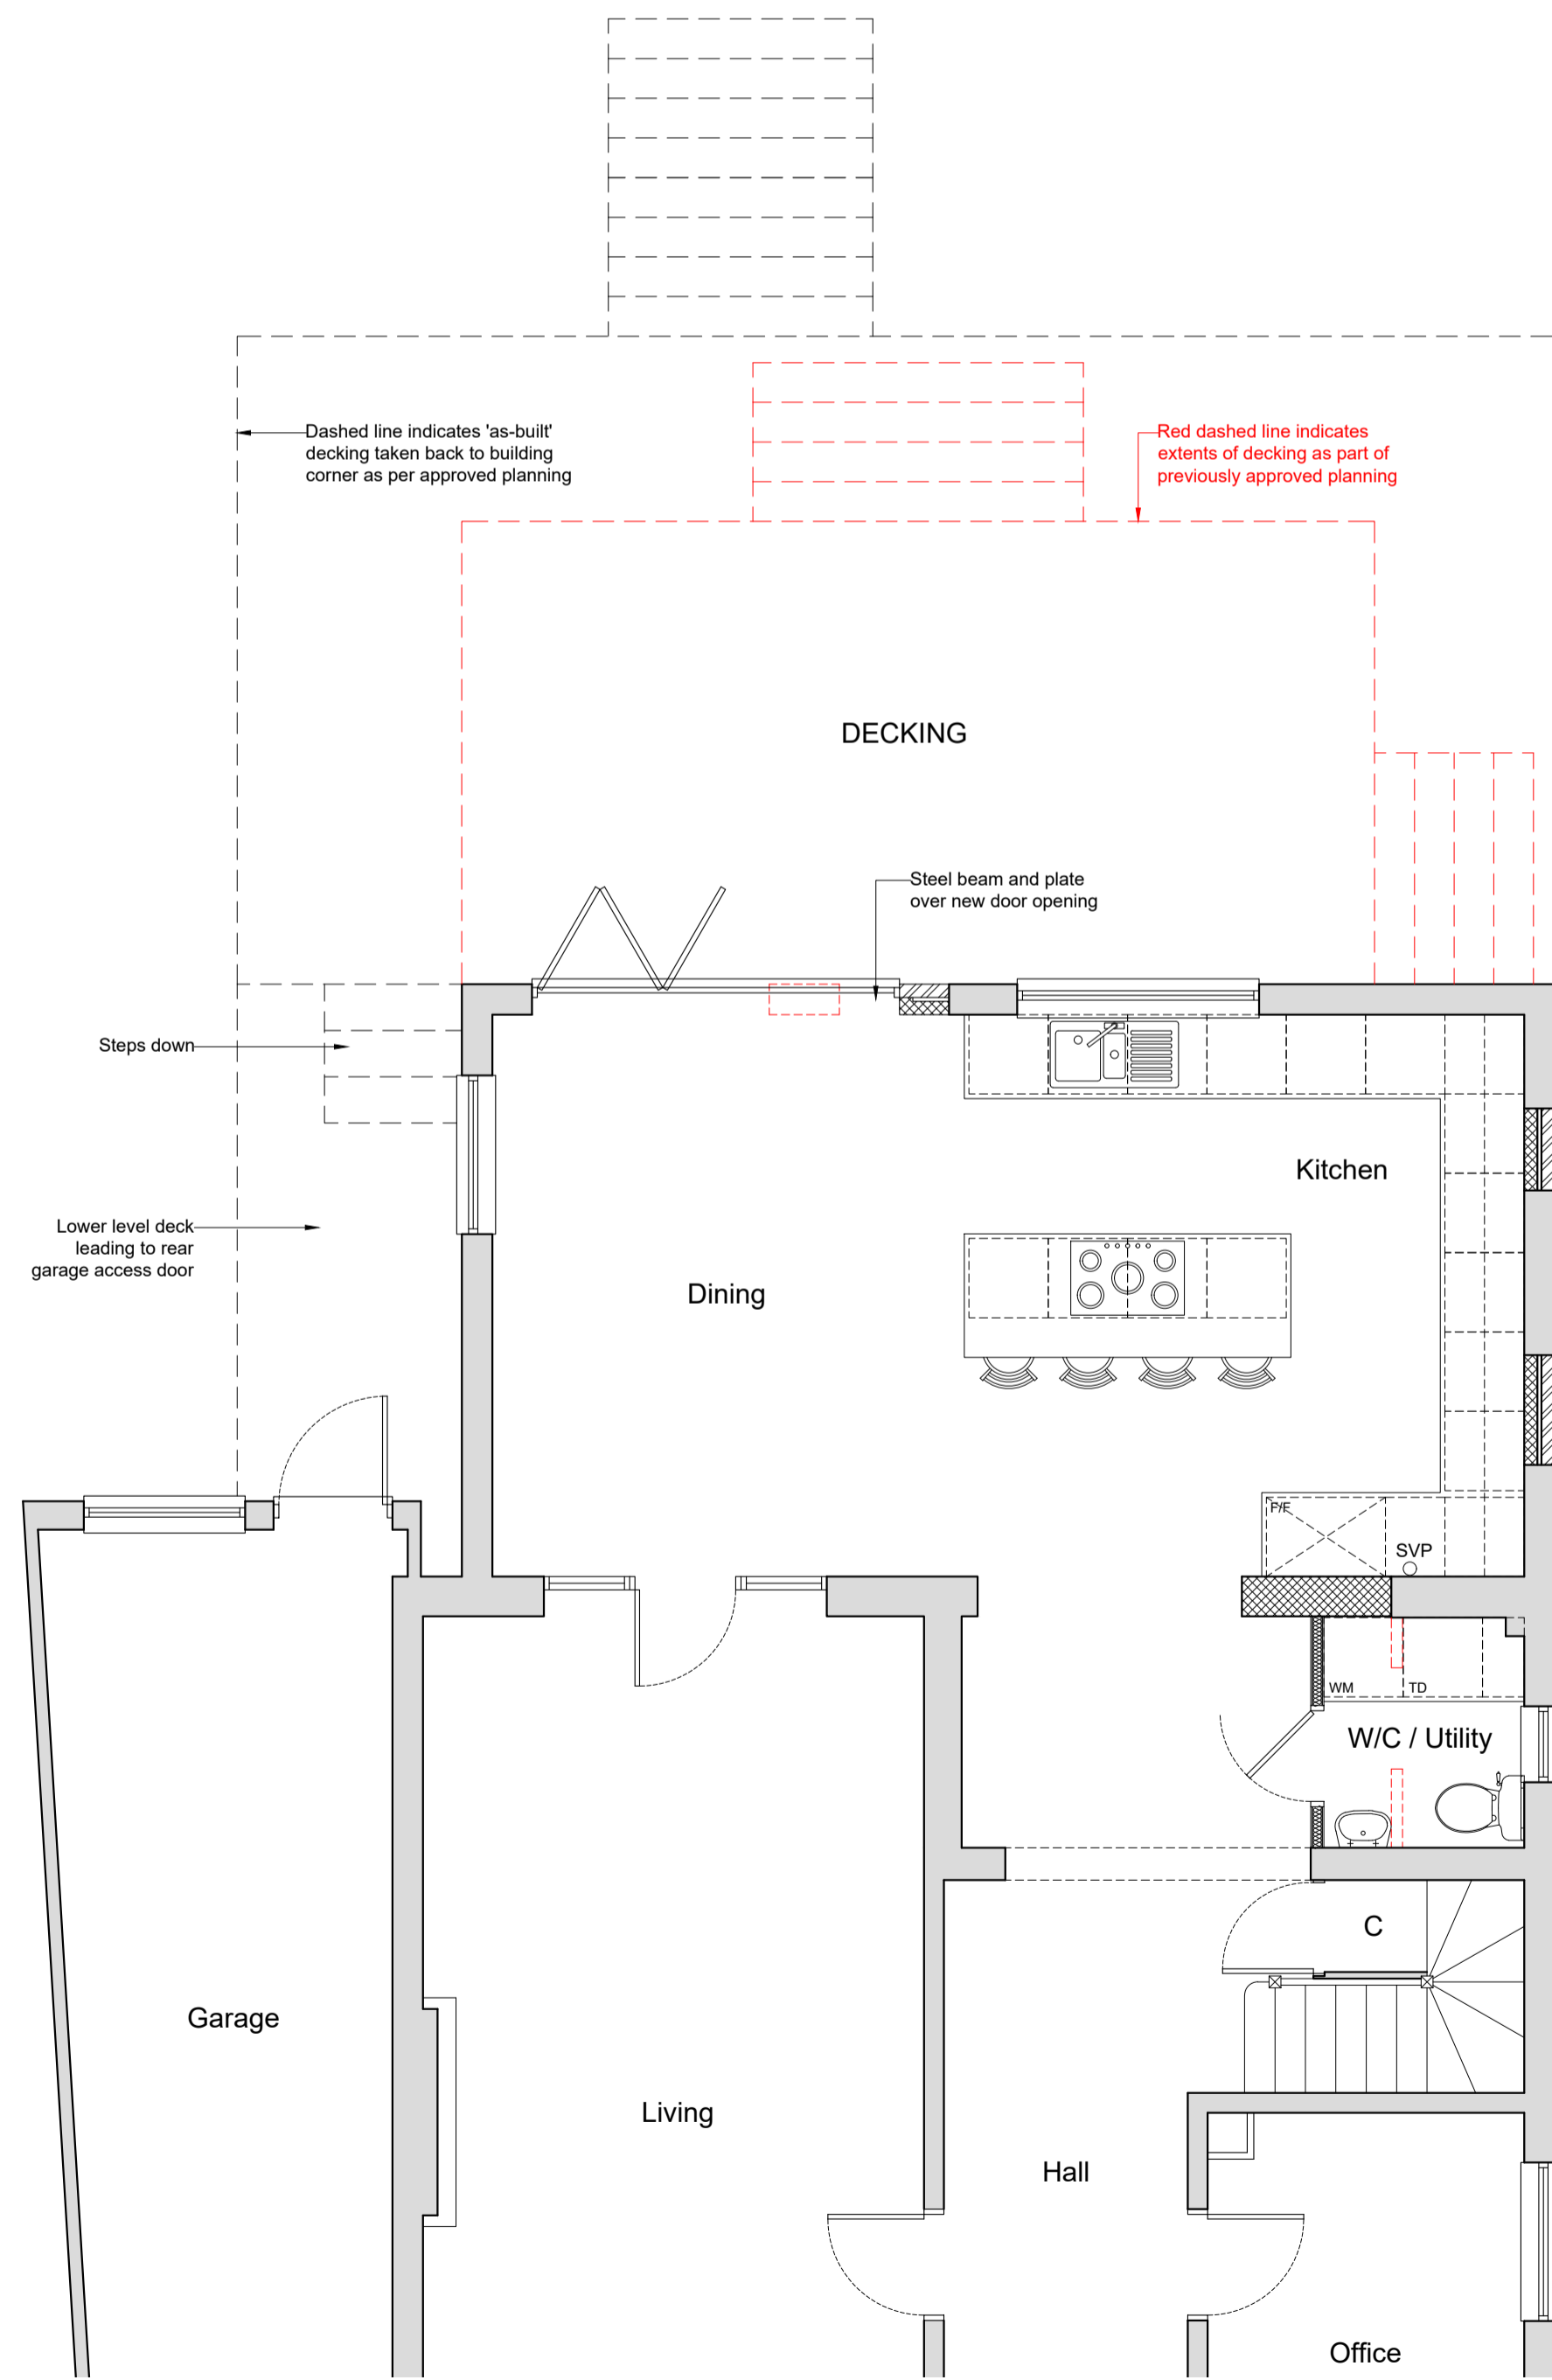

GROUND FLOOR PLAN
(showing full extents of as-built decking)
1:500

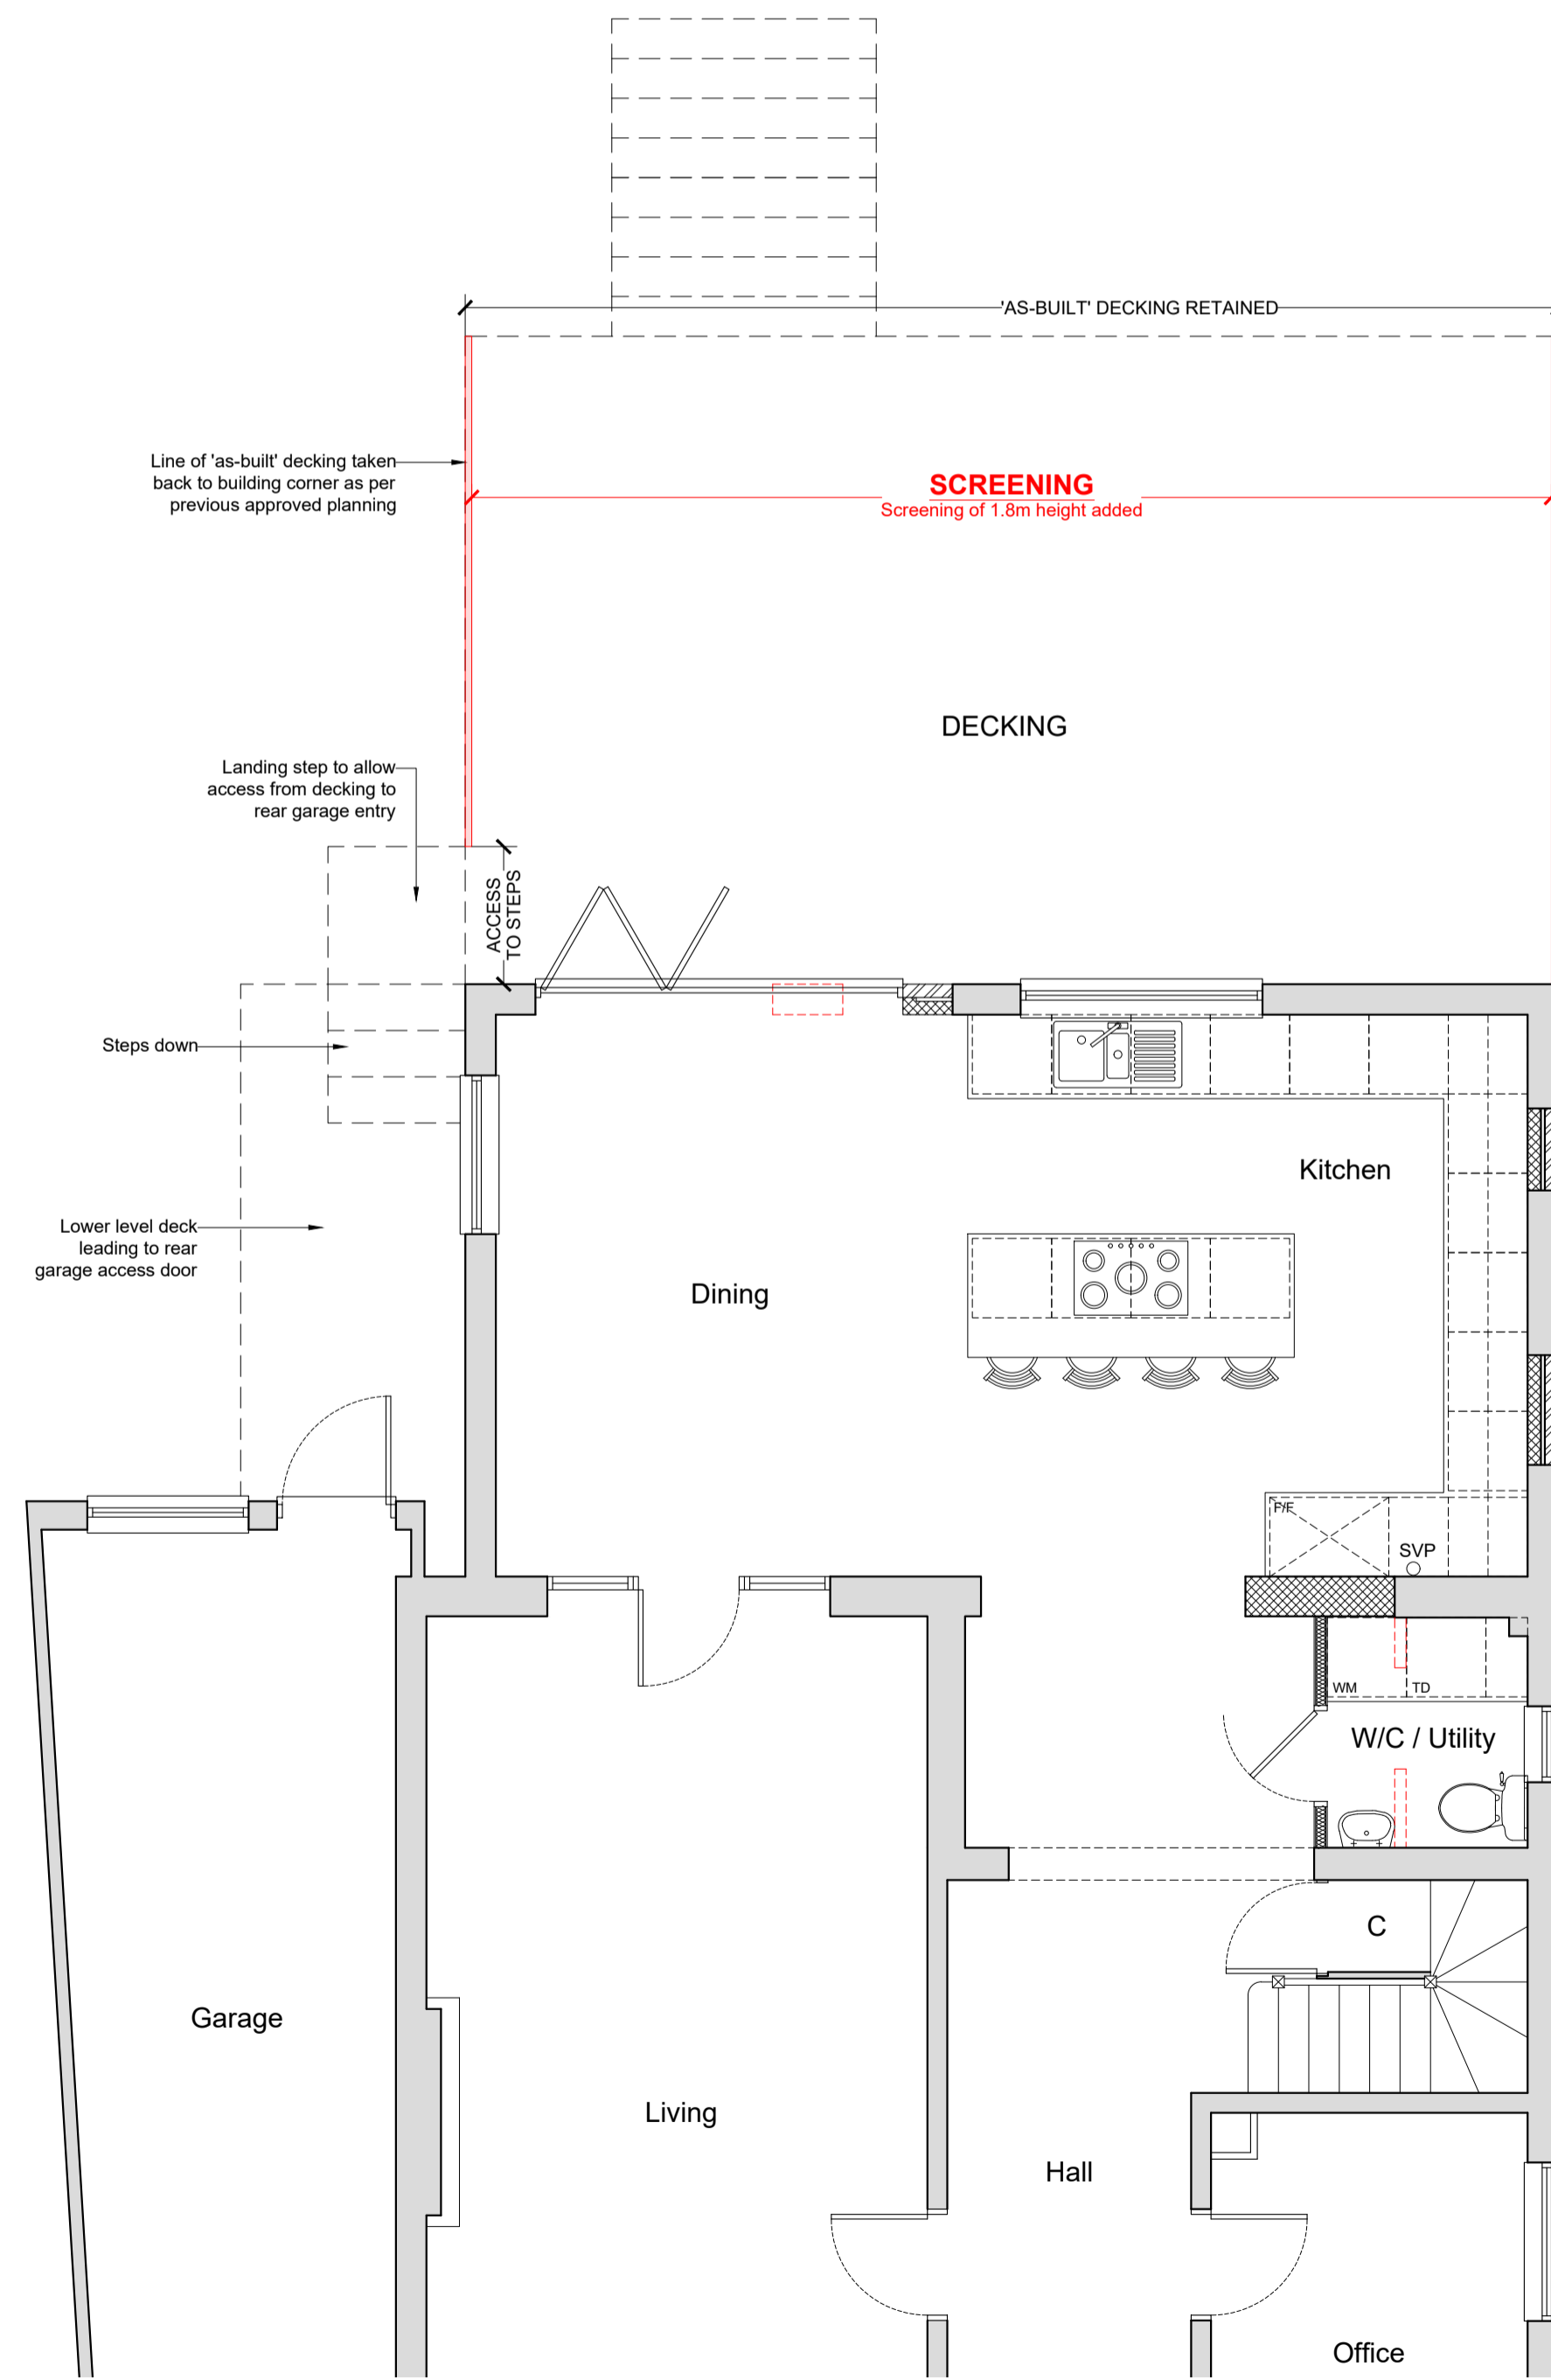



GROUND FLOOR PLAN
(showing proposed decking adaptations for section 73)
1:500

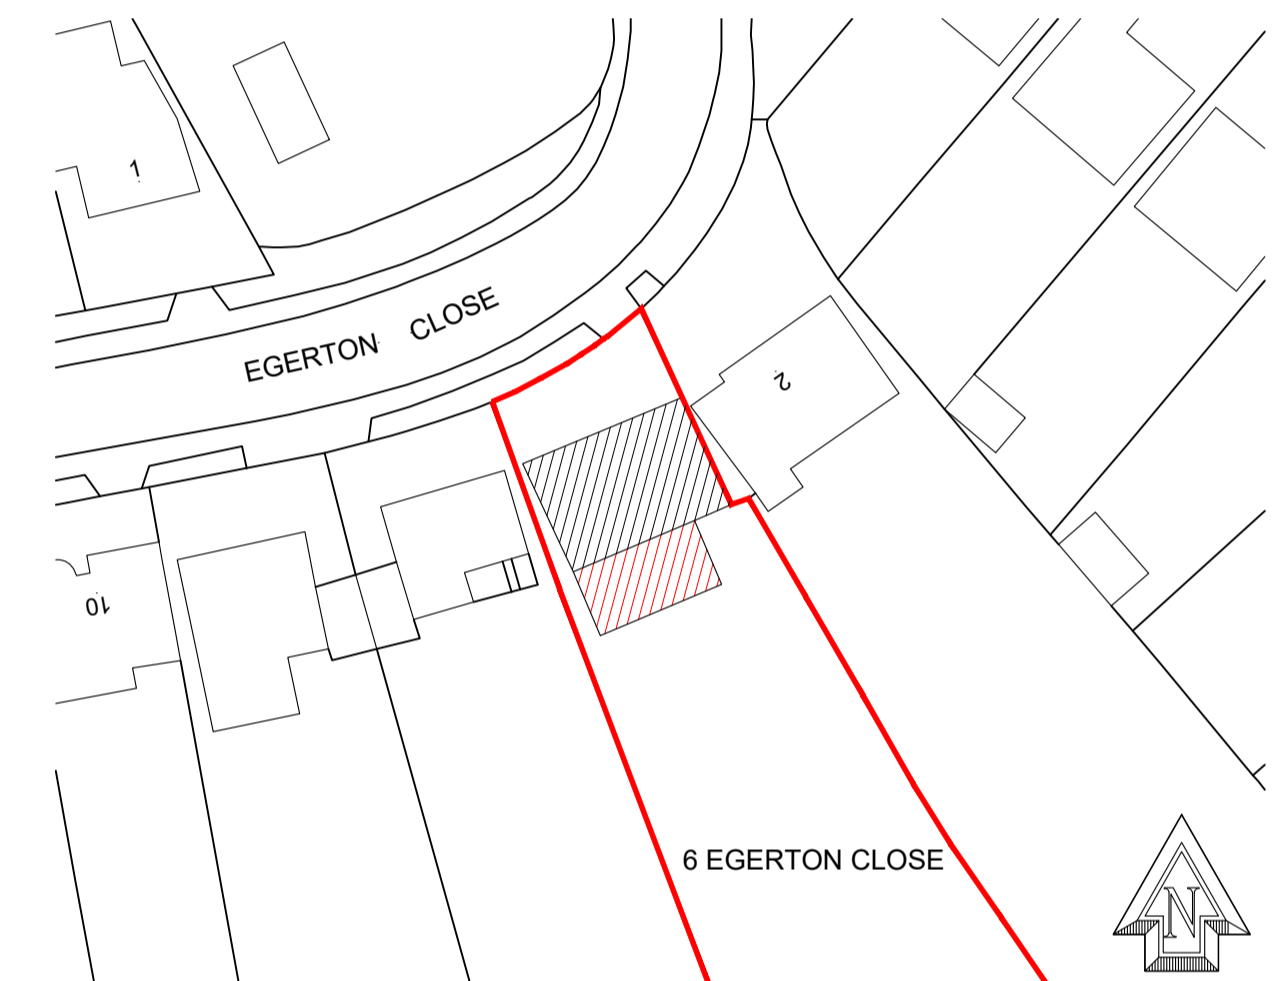

©Crown Copyright. All rights reserved. Licence no. 100019980
BLOCK PLAN
1:500

PLANS/ELEVATIONS KEY

	Existing Masonry
	New Brickwork
	New Blockwork
	New Roof
	Insulation
	Demolition
	Fence

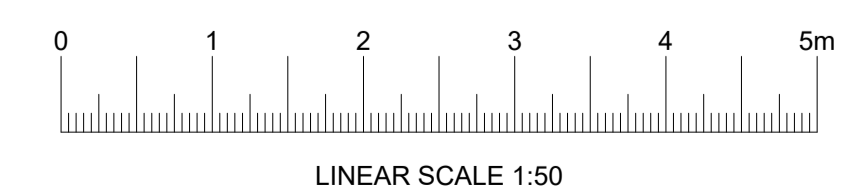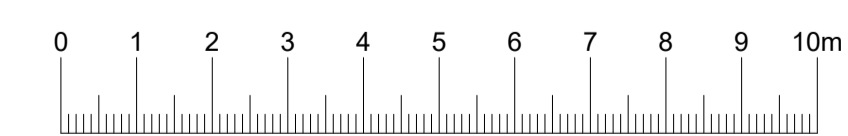

Client:
Mr & Mrs T Murkett

Address:
4 Egerton Close,
Pinner,
HA5 2LP

Drawing Title:
*Section 73: Proposed Decking
Adaptions*

Date: January 2026
Scale @ A1: 1:50 / 1:100 / 1:500

Rev.	Date	Description
#	20.01.26	Plans/Elevs: patio decking amended to show 'as-built' and further revisions for Section 73.
A	25.02.26	Note added to plan at PO's request: 1.8m ht screening to be installed to both sides of deck.
B	04.03.26	1.8m ht screens added to elevations

Drawing No:
PL-003.B

