


PLANS/ELEVATIONS KEY	
Existing Masonry	
New Brickwork	
New Blockwork	
New Roof	
Insulation	
Demolition	
Fence	

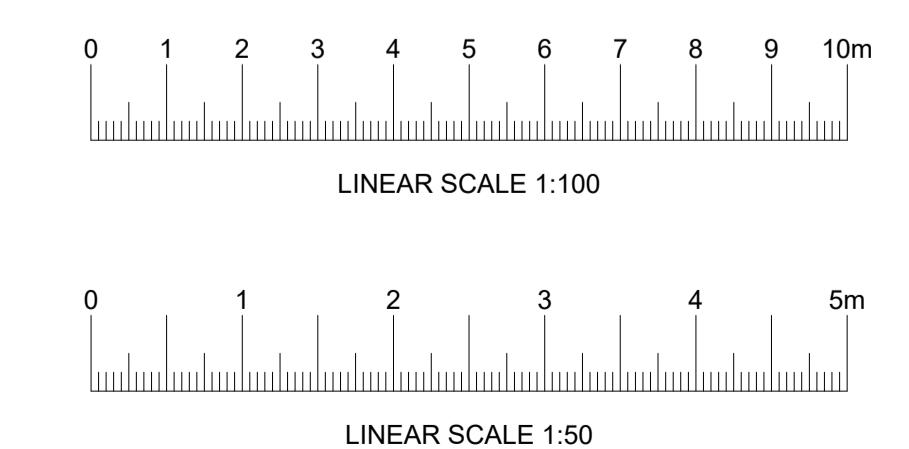

Client:
Mr & Mrs T Murkett

Address:
4 Egerton Close,
Pinner,
HA5 2LP

Drawing Title:
Section 73: Proposed Decking
Adaptions

Date: January 2026

Scale @ A1
1:50 / 1:100 / 1:500

Rev: Date Description
20.01.26 Plans/Elevs: patio amended to show 'as-built' and further revisions for Section 73. Further patio outlines added at PO's request.

Drawing No: PL-003

LMAD
ARCHITECTURAL