


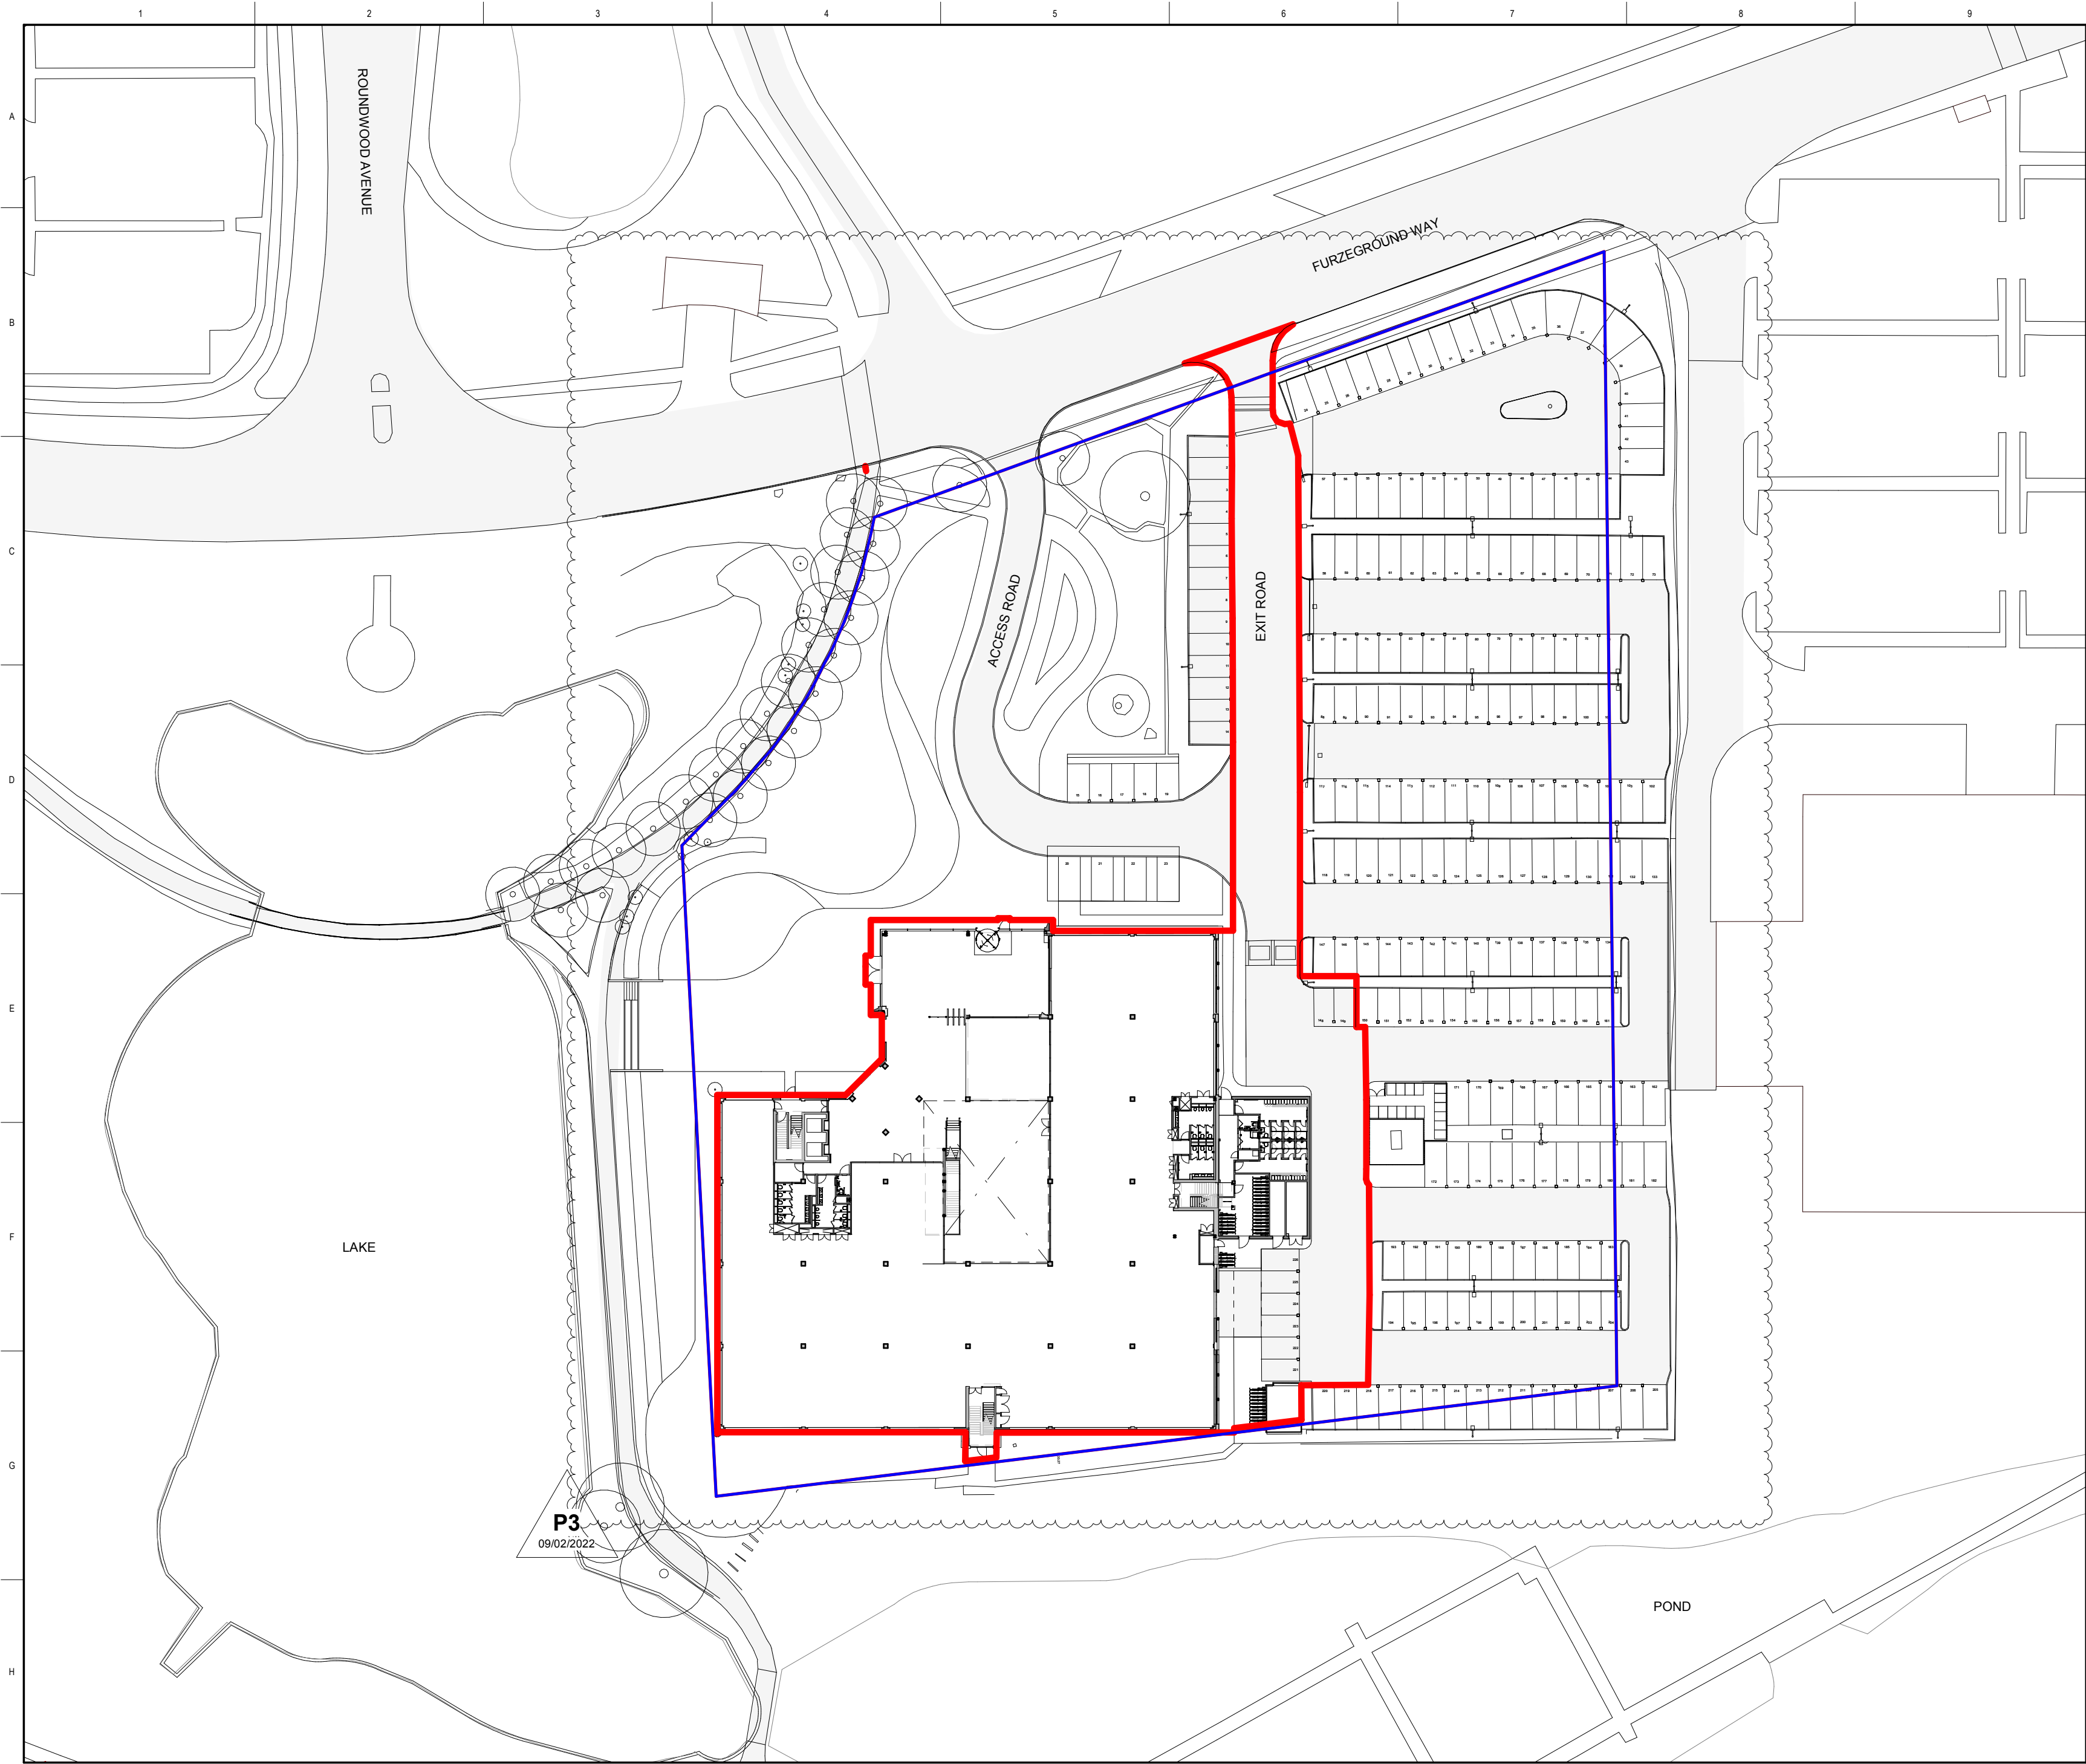

CLIENT

Tritax

NOTES:

DO NOT SCALE. FIGURED DIMENSIONS ONLY TO BE TAKEN FROM THIS DRAWING. CHECK DIMENSIONS ON SITE AND REPORT DISCREPANCIES TO THE ARCHITECT.

THIS DRAWING IS PROTECTED BY COPYRIGHT.

ALL AREAS HAVE BEEN MEASURED FROM CURRENT DRAWINGS. THEY MAY VARY BECAUSE OF INTER ALIA SURVEY, DESIGN DEVELOPMENT, CONSTRUCTION TOLERANCES, STATUTORY REQUIREMENTS OR RE-DEFINITION OF THE AREAS TO BE MEASURED.

NOTES:

ALL EXISTING DIMENSIONS TO BE CONFIRMED ON SITE. INDICATIVE EXISTING COLUMN ENCASEMENTS AND STEELWORK SHOWN, EXACT POSITIONS, SIZES TO BE CONFIRMED ON SITE.

LEGEND:

— SITE BOUNDARY OF PLANNING SUBMISSION

— SITE BOUNDARY OF CLIENT OWNERSHIP

Revisions

No.	Date	Comments	Drawn	Checked
P3	09-02-2022	Redline boundary updated	HG	NS
P2	21-09-2021	Sectional door amended. Minor amendments to landscaping. Redline boundary updated	HG	NS
P1	13-09-2021	Issue for Planning	DK	HG

Issue Status

Planning

tp bennett

architecture
interiors
planning

One America Street London SE1 0NE UK +44 (0) 20 7208 2000 www.tpbenett.com

Project

Lakeside House
Stockley Business Park
Uxbridge UB11 1BD

Drawing Title

Proposed Site Plan

Drawn

DK

Date

10/09/2021

Scale @ A2

1:500

Alt. Ref.

tp bennett Project No.

A11633

Series

D

Zone

2

Drawing Number

051

Rev.

P3

09/02/2022 16:38:23

BIM Model Ref: A11633-TPB-ZZZ-M3-A-0001-S0-P4.1