





NOTES

To be read alongside BCA drawing 1690-16-03 Detailed Planting Plan 02

KEY

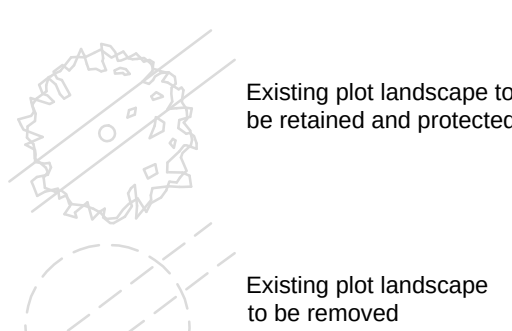

EXISTING HEDGEROW AND TREES TO BE RETAINED

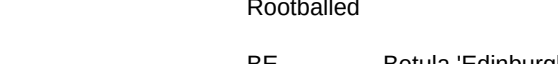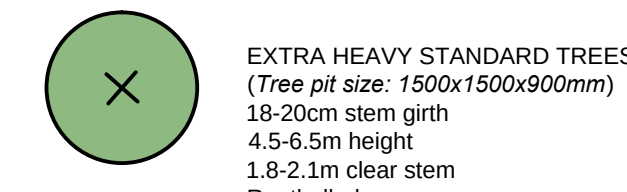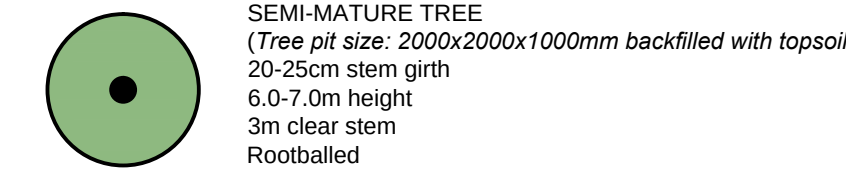

PROPOSED SPECIMEN SHRUBS (450mm depth of topsoil)			Pot Size
Species	Supply Size		
Amelanchier canadensis	900-1200mm		10L

PROPOSED ORNAMENTAL GROUND COVER SHRUB PLANTING
(450mm depth of topsoil)
Ultimate plant height is below 1m.

Species	Supply Size	Size	Spacing
Escallonia 'Apple Blossom'	400-600mm	3L	600mm cts
Escallonia 'Red Dream'	400-600mm	3L	500mm cts
Hebe pinguifolia 'Sutherland'	200-300mm	3L	600mm cts
Lonicera hida 'Maygreen'	300-400mm	2L	500mm cts
Rosa 'Kerr'	300-400mm	3L	450mm cts
Spiraea 'Gold Mound'	300-400mm	3L	500mm cts

PROPOSED INDIGENOUS HEDGEROW (300mm depth of topsoil) Planted at 450mm centres in a double staggered row. Rows to be 500mm apart					
%	Species	Common Name	Size	Age	Root
50%	Acer campestre +	Field maple	400-600mm 1+1	OG	
10%	Carpinus betulus +	Hornbeam	400-600mm 1+1	OG	
30%	Corylus avellana #	Hazel	400-600mm 1+1	OG	
5%	Crataegus monogyna #	Hawthorn	400-600mm 1+1	OG "B"	
5%	Salix caprea +	Goat willow	400-600mm 1+1	OG	

PROPOSED GRASS SEEDED AREAS
(150mm depth topsoil)
DLF Trifolium Premaster 120 Slowgrowth
Sown at a rate of 35-50 g/m²

PROPOSED WILDFLOWER SEEDED AREAS
(Cultivated subsoil to a depth of 300mm)
Combination of -
ESG2 - Fine Grassland Mixture sown at 2g/m²
ESPF - Wild Pollen and Nectar Flowers sown at 0.2g/m²
Supplied by Emagga Seeds

PROPOSED SECURITY FENCE
All to Architects details

EXISTING TIMBER POST AND 3 RAIL FENCE

EXISTING PLANTING FROM PREVIOUS APPLICATION

SITE BOUNDARY

REV G - Minor adjustment to planting shown along road.
REV F - Amended to updated layout.
REV E - Amended to suit full scheme.
REV D - Removed note relating to steel wire panels used.
REV C - Updated MSA layout.
REV B - Updated MSA layout.
REV A - Amended to suit MSA layout.

JP 09-09-20
JP 08-09-20
JP 07-05-19
JP 18-04-18
JP 17-08-17
JP 14-08-17
JP 14-08-17

BCA BARRY CHINN
associates
Landscape Architects

CLIENT

PROJECT
PROLOGIS PARK,
WEST LONDON - PHASE 2

DRAWING
DETAILED PLANTING PLAN
1 of 2

CONTRACT 169016			DRG NO.	
DATE	August 2017	JP	02	
ISSUE	As built	CHECKED MB		
SCALE	1:200	ORIG SHEET A0	REV G	
CAD FILE 1690-16-02 03 Detailed Planting Plan				