

Rev:	Date:	Description:	By:	Chk:
------	-------	--------------	-----	------

Foundation Notes.

Minimum height of foundation bases above ground level to be 50mm.

All bases to finish on same level (float finish of + or - 3mm)

The minimum base area required is 600mm x 600mm (for siting purposes)

Foundations designed and constructed by others to suit site conditions and accept the loads shown. All to be subject to building control approval.

Load per leg = 36kN (76kN for two storey)

The loads are based on a building with 3kN/m2 floor loading, 0.75kN/m2 imposed roof loading and a basic wind speed of 50 m/s.

Double stacked jackleg units must be bolted to the foundations.

All *Lodastrut* legs should be fully retracted onto the safety stops with the leg pins fitted through the outer legs and secured by pulling the chain tight and locating it on the hook on the side of the leg.

Standard Colours.

External Walls - Silk Grey nearest BS ref 10 A 05

Doors - Golden Amber nearest BS ref 08 E 51

Roof fascia and trims - Blue Grey nearest BS ref 18 B 29

Legs - Blue Grey - BS 4800 18 B 29


Key.

O Opening window


F Fixed window

rwp Rain water pipe

10377 overall length

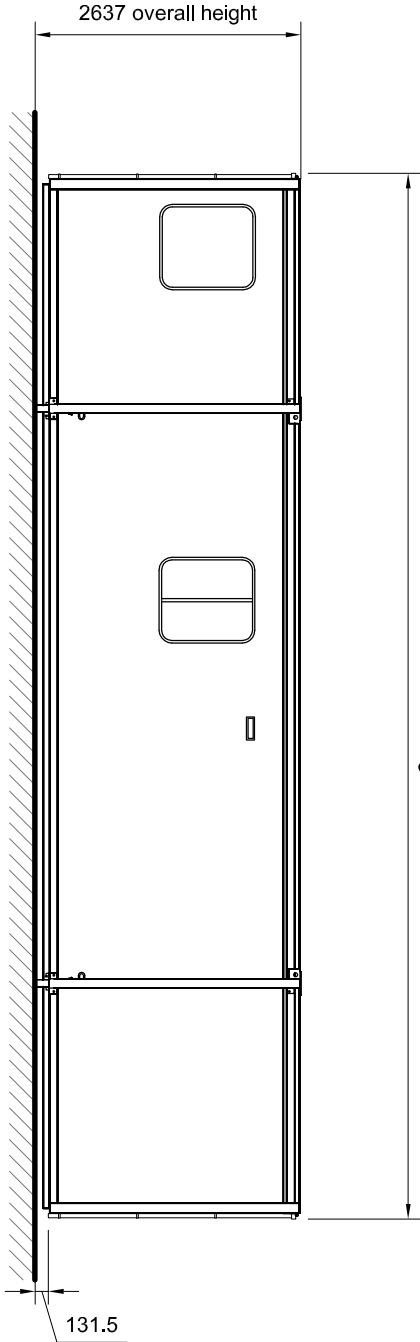


Side Elevation

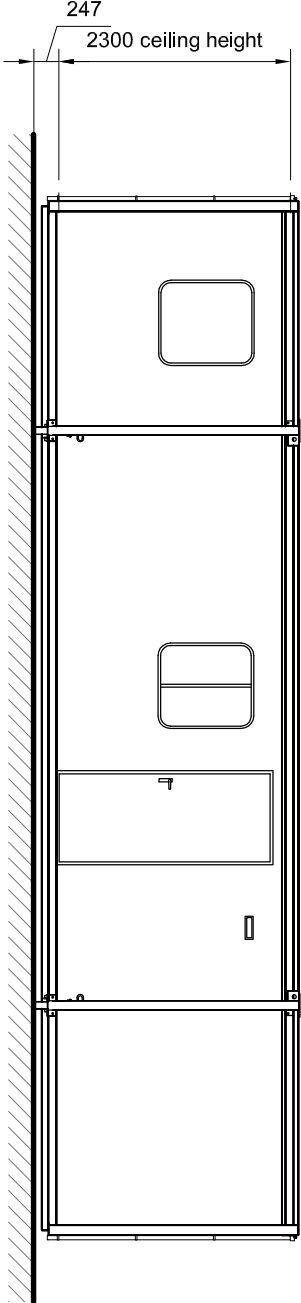


Side Elevation

2899 overall width

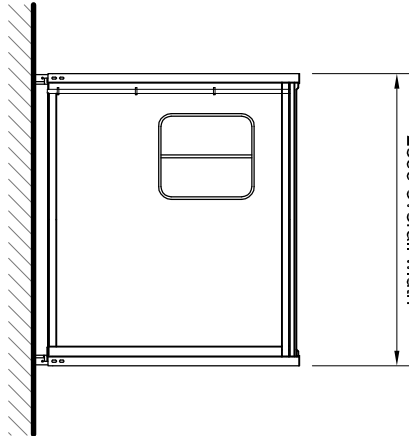


End Elevations

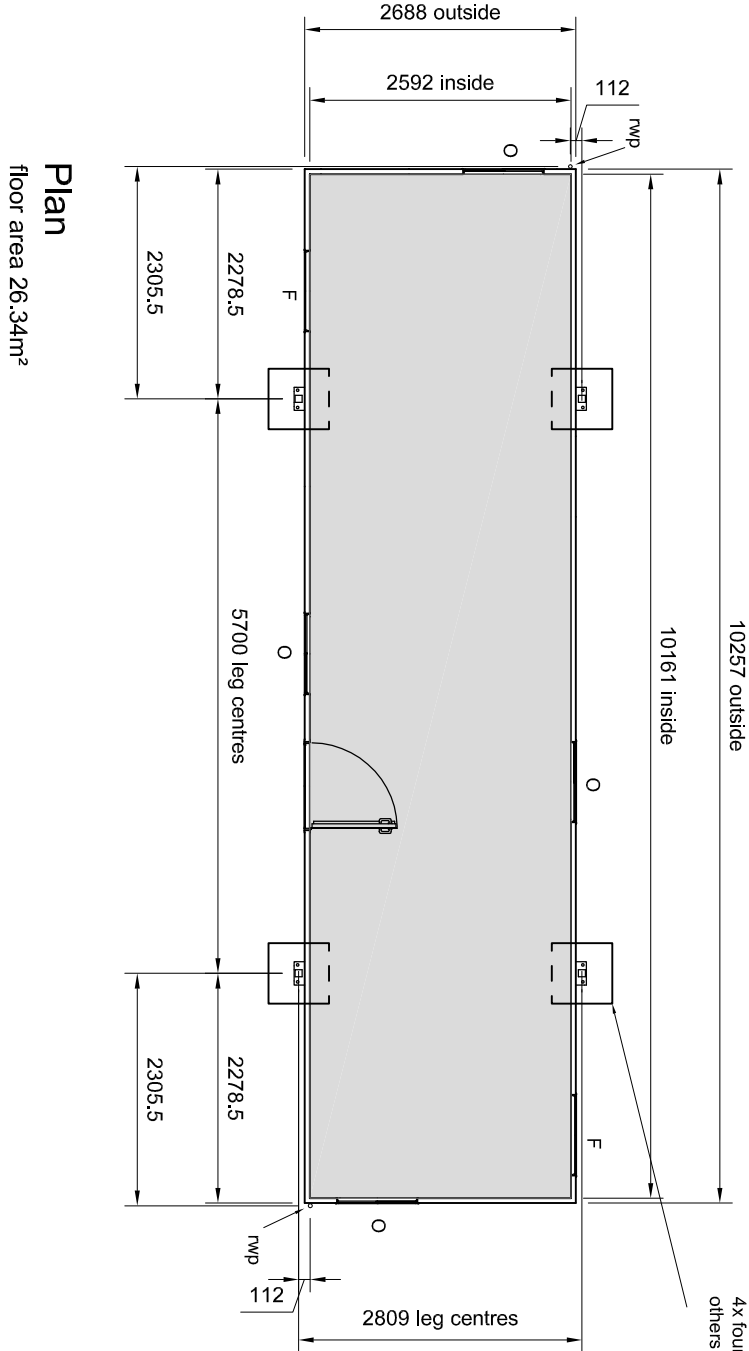

Plan

floor area 26.34m²

4x foundation pads by others at leg base plates

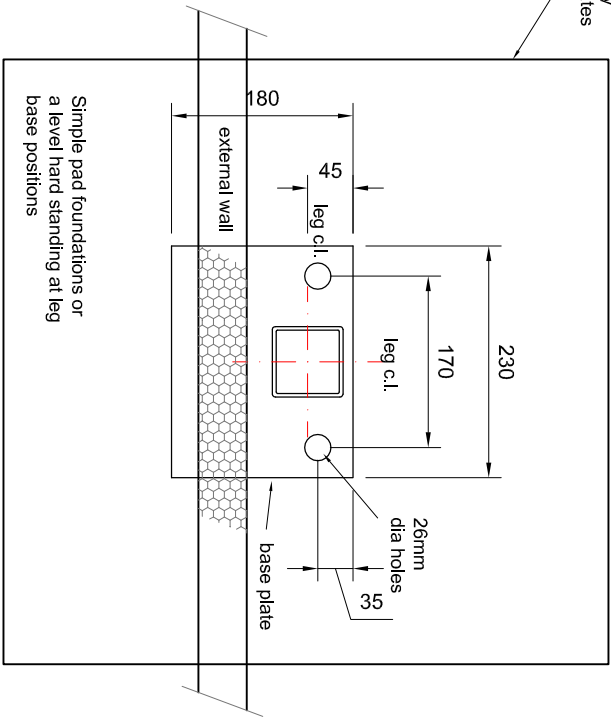

Leg Baseplate Detail

Plan view

Pacemaker 7 PK341

Status:	AB	Purpose Of Issue:	As Built
Client:	Portakabin Refurbished Ltd		
Project:	Portakabin Building Pacemaker Series 7		
Title:	Specification Drawing PK341		
Scale @ A3:	1 to 75	Date:	2017
Drawn By:	PG	Checked By:	SN
Project Number:	PK341 Series 7		
Originator:	Zone:	Level:	Type:
PKR	00	GF	DR
			A
			01
			0