



This drawing is the property of Portakabin Limited.
It must not be copied or reproduced or divulged to anyone without written permission.
Do not scale off this drawing.
All discrepancies to be reported to Portakabin Limited.


Rev:	Date:	Description:	By:	Chk:
------	-------	--------------	-----	------

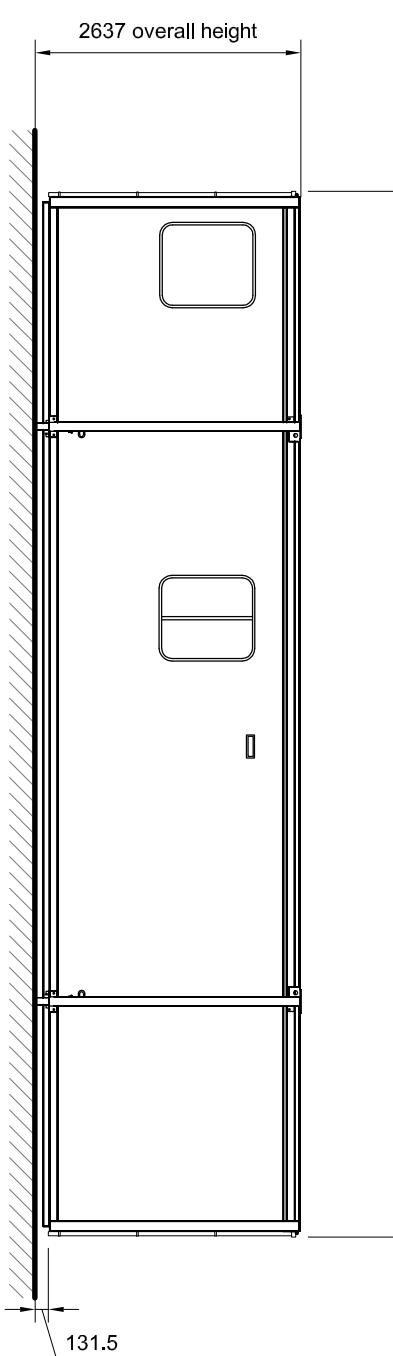


Side Elevation

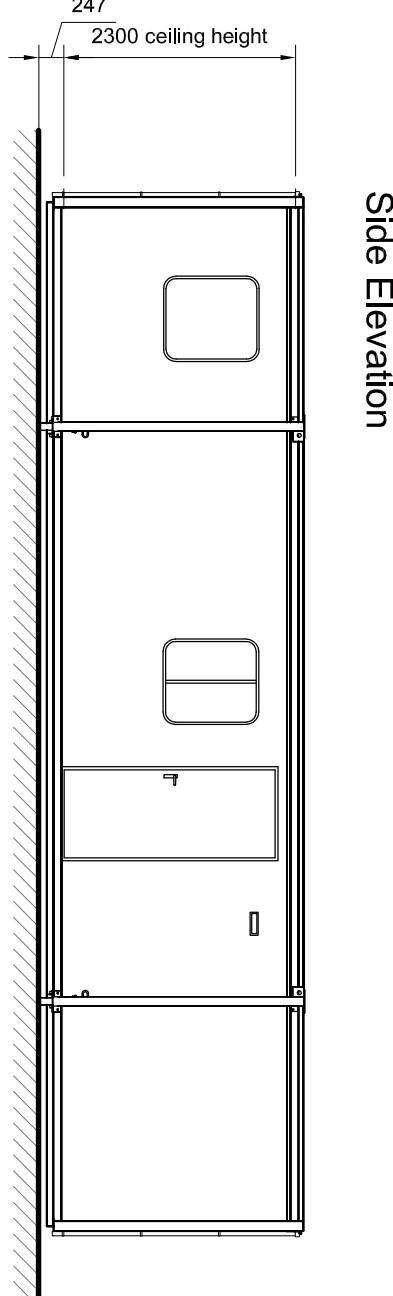

End Elevations

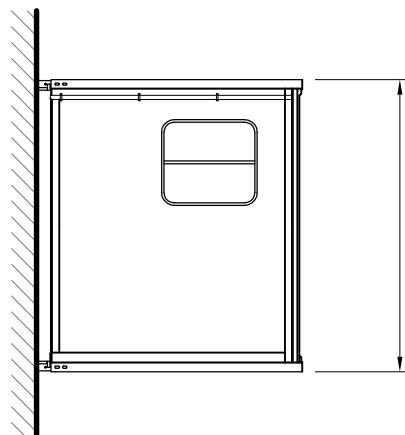


End Elevation

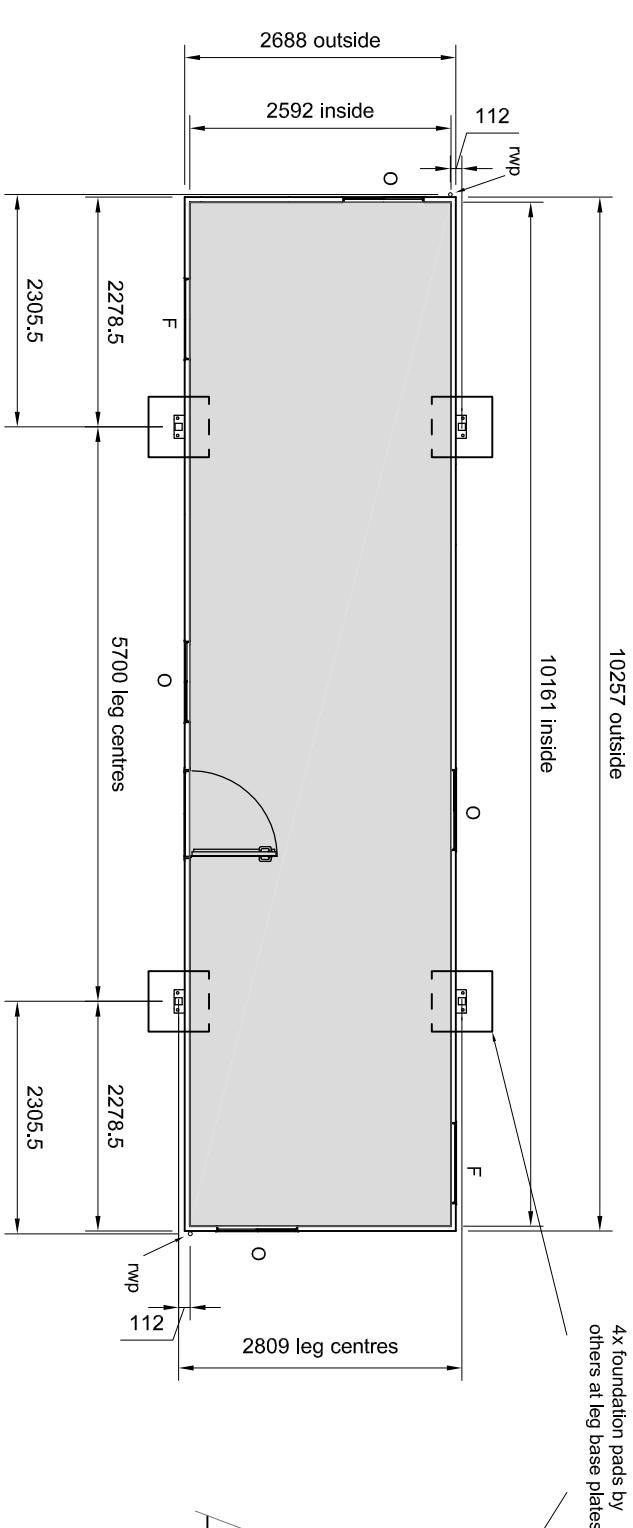

Leg Baseplate Detail

Plan view

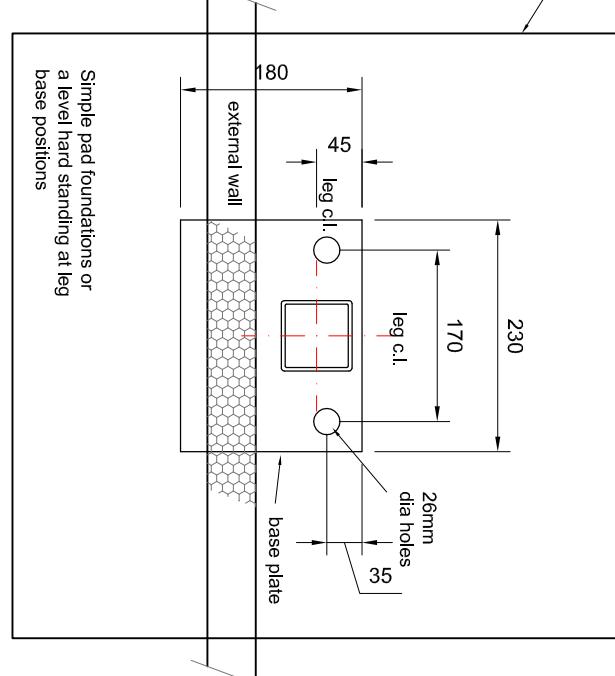

Simple pad foundations or
a level hard standing at leg
base positions

Plan
floor area 26.34m²

Pacemaker 7 PK341

Status:		Purpose Of Issue:	
AB	As Built		
Client:			
Portakabin (Refurbished) Limited			
Cattfoss Lane, Brandesburton			
Driffield YO25 8ES			
+44 (0)1845 287 5962			
portakabin.co.uk			
Title:			
Specification Drawing			
PK341 Series 7			
Definition:			
PKR	00	GF	DR
Level:	Type:	Discipline:	Number:
1 to 75	2017	PG	SN
Date:	Drawn By:	Checked By:	
Project:	Portakabin Building		
Project Number:	Pacemaker Series 7		