



Side Elevation

End Elevation

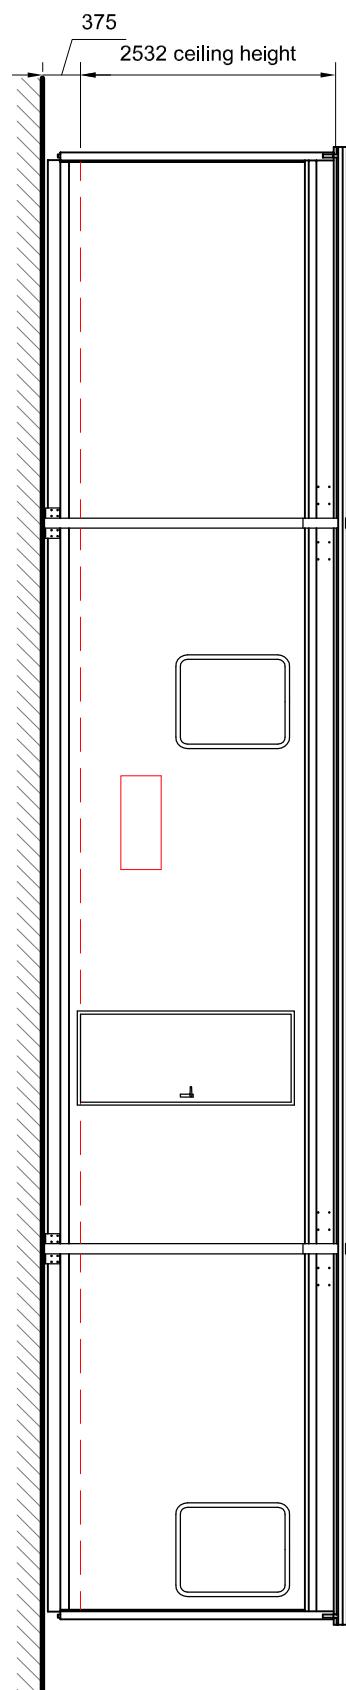


Side Elevation

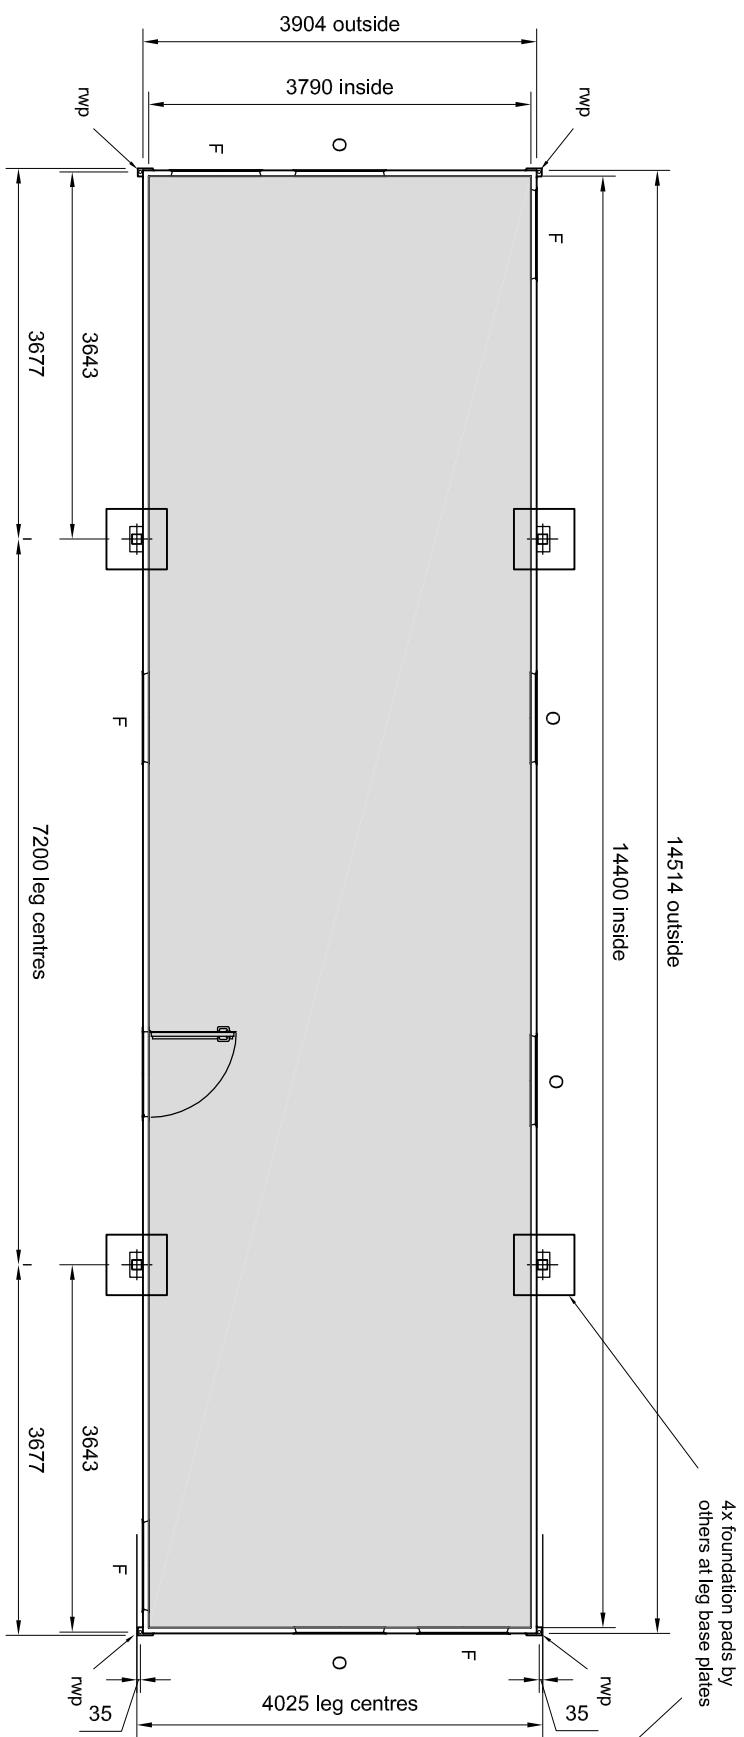

Plan

floor area 54.58m²

Key:
 O Opening window
 F Fixed window
 rwp Rain water pipe

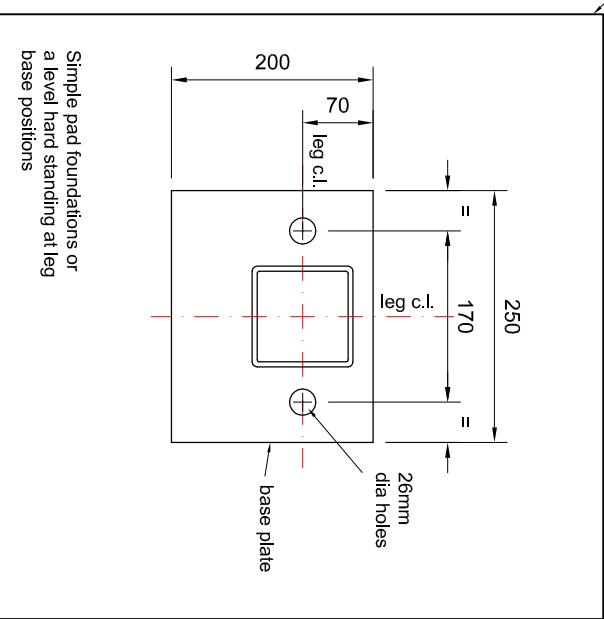Simple pad foundations or
a level hard standing at leg
base positions

Leg Baseplate Detail

Pullman PM484

Definition:	Zone:	Level:	Type:	Discipline:	Number:	Rev:
PKR	00	GF	DR	A	01	0

Portakabin®

PM484

Specification Drawing

PM484

Status: AB Purpose Of Issue: As Built
 Client: Portakabin (Refurbished) Limited
 Cattfoss Lane, Brandesburton
 Driffield YO25 8ES
 +44 (0)845 287 5962
portakabin.co.uk

Title: Specification Drawing

PM484

Scale @ A3: 1 to 75

Date: 2017

Drawn By: PG

Checked By: SN

Project Number: PM484