


PROPOSED FIRST FLOOR PLAN

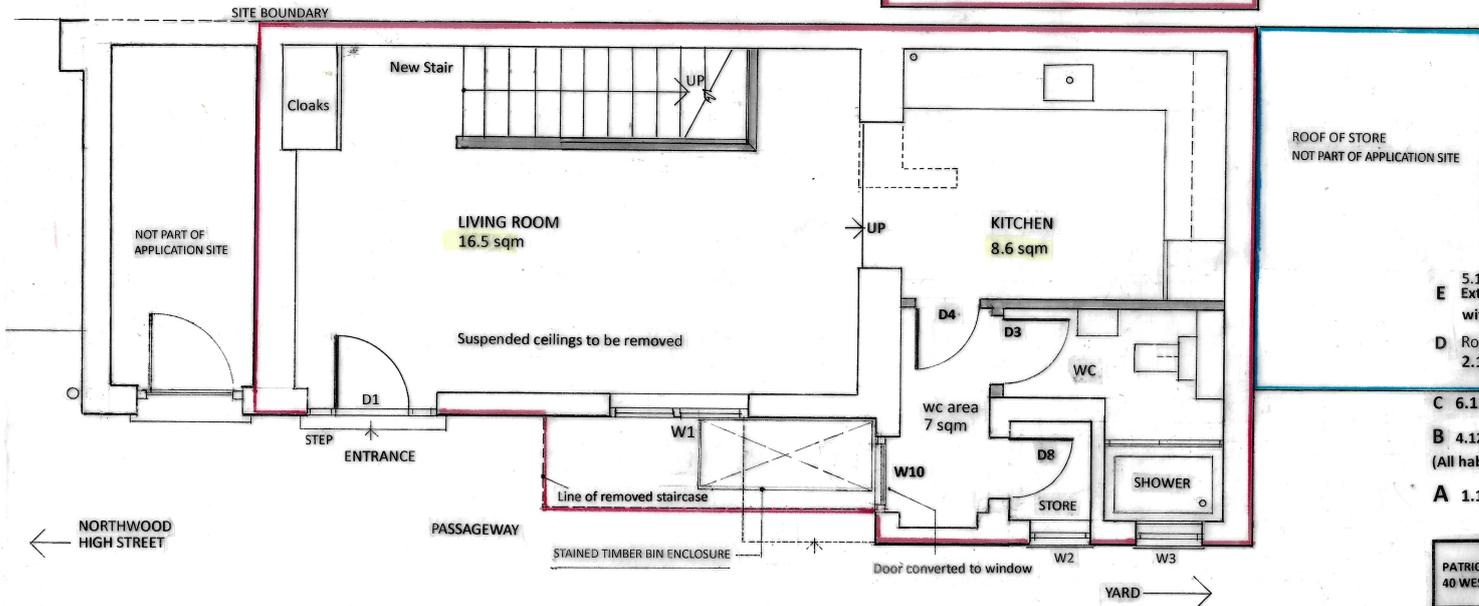

PROPOSED GROUND FLOOR PLAN

- E 5.1 External staircase shown within red line boundary
- D Room floor areas added 2.1.2026
- C 6.12.2025 Store room indicated 'NOT PART OF APPLICATION SITE'
- B 4.12.2025 Additional SQM. floor areas added to proposed plans (All habitable rooms and other spaces)
- A 1.11.2025 Room areas and total internal floor area added (including balcony)

TOTAL INTERNAL SQM = 75.6 sqm

PATRICK ETTWEIN DipArch RIBA FRSA 07957 370435 020 8455 8953 40 WESTHOLM LONDON NW 11 6LH ettweinp@gmail.com	CODE	DWG NO.
		NW 02
20B HIGH STREET NORTHWOOD HA6 1BN PROPOSED CHANGE OF USE & ALTERATIONS.	REV	
PROPOSED GROUND FLOOR PLAN PROPOSED FIRST FLOOR PLAN	SCALE	1:50 @A3
	DATE	SEPT 2024
PLANNING APPLICATION	STATUS	PLANNING
Do not scale from this drawing. This drawing is the copyright of Patrick Ettwein.		
NOT FOR CONSTRUCTION		