



EXISTING FIRST FLOOR PLAN

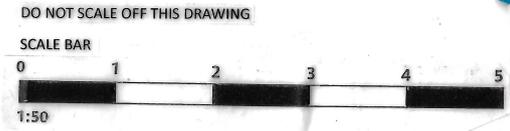


REVISIONS	
C	2.12 2025 Public access way to the site shown by BLUE LINE on Location plan
D	2.1.2026 Room floor areas added Red line added showing site boundary
E	External staircase shown within redline boundary

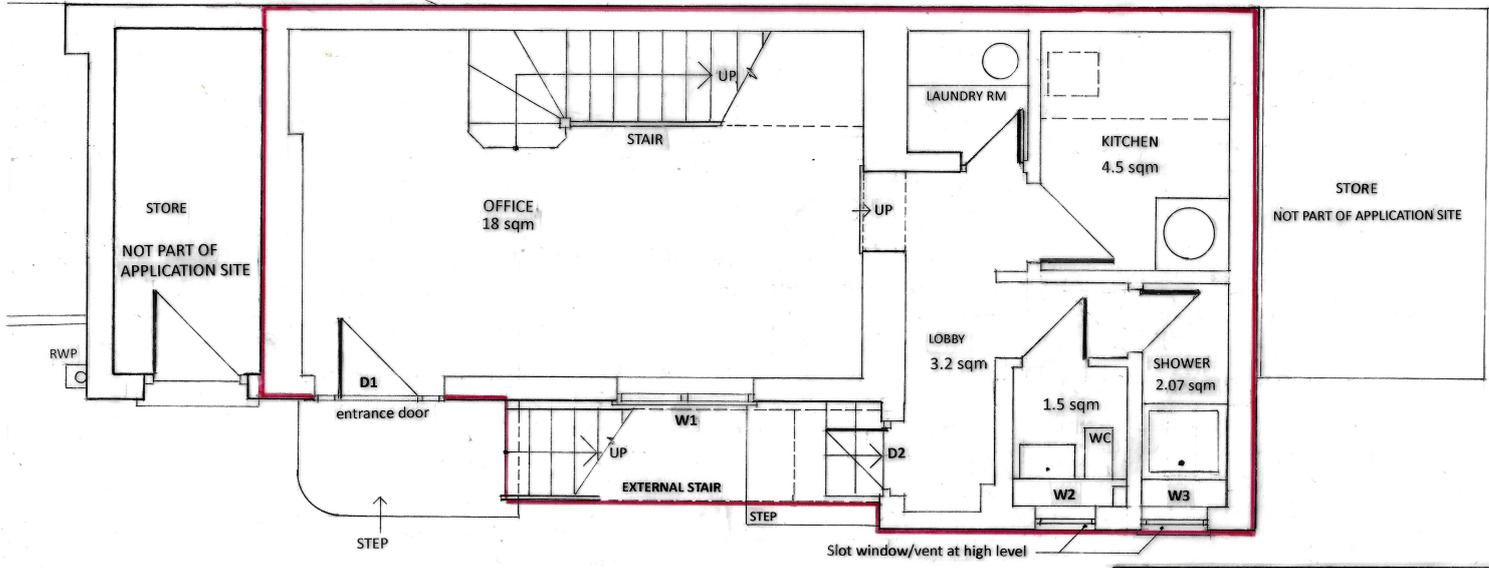

EXISTING GROUND FLOOR PLAN
1:50 @A3

location plan 1:500 @A3

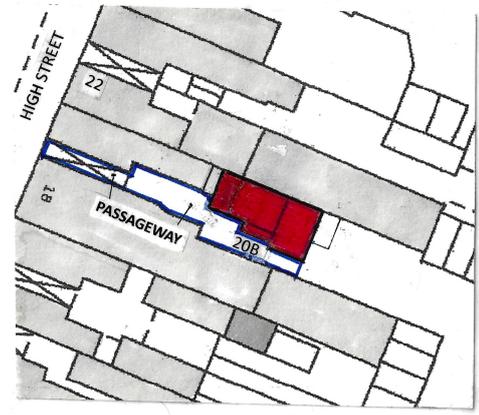

PROPOSED CHANGE OF USE & ALTERATIONS TO 20B HIGH STREET NORTHWOOD HA6 1BN	Patrick Ettwein DipArch RIBA FRSA 07957 370435 020 8455 8953 40 Westholm, London, NW11 6LH ettwein@gmail.com	DRAWING	NW 01 E
title EXISTING GROUND FLOOR PLAN EXISTING FIRST FLOOR PLAN LOCATION PLAN	PLANNING APPLICATION	revision	
SCALE 1:50 @A3	date	SEPT 2024	
	status	PLANNING	