

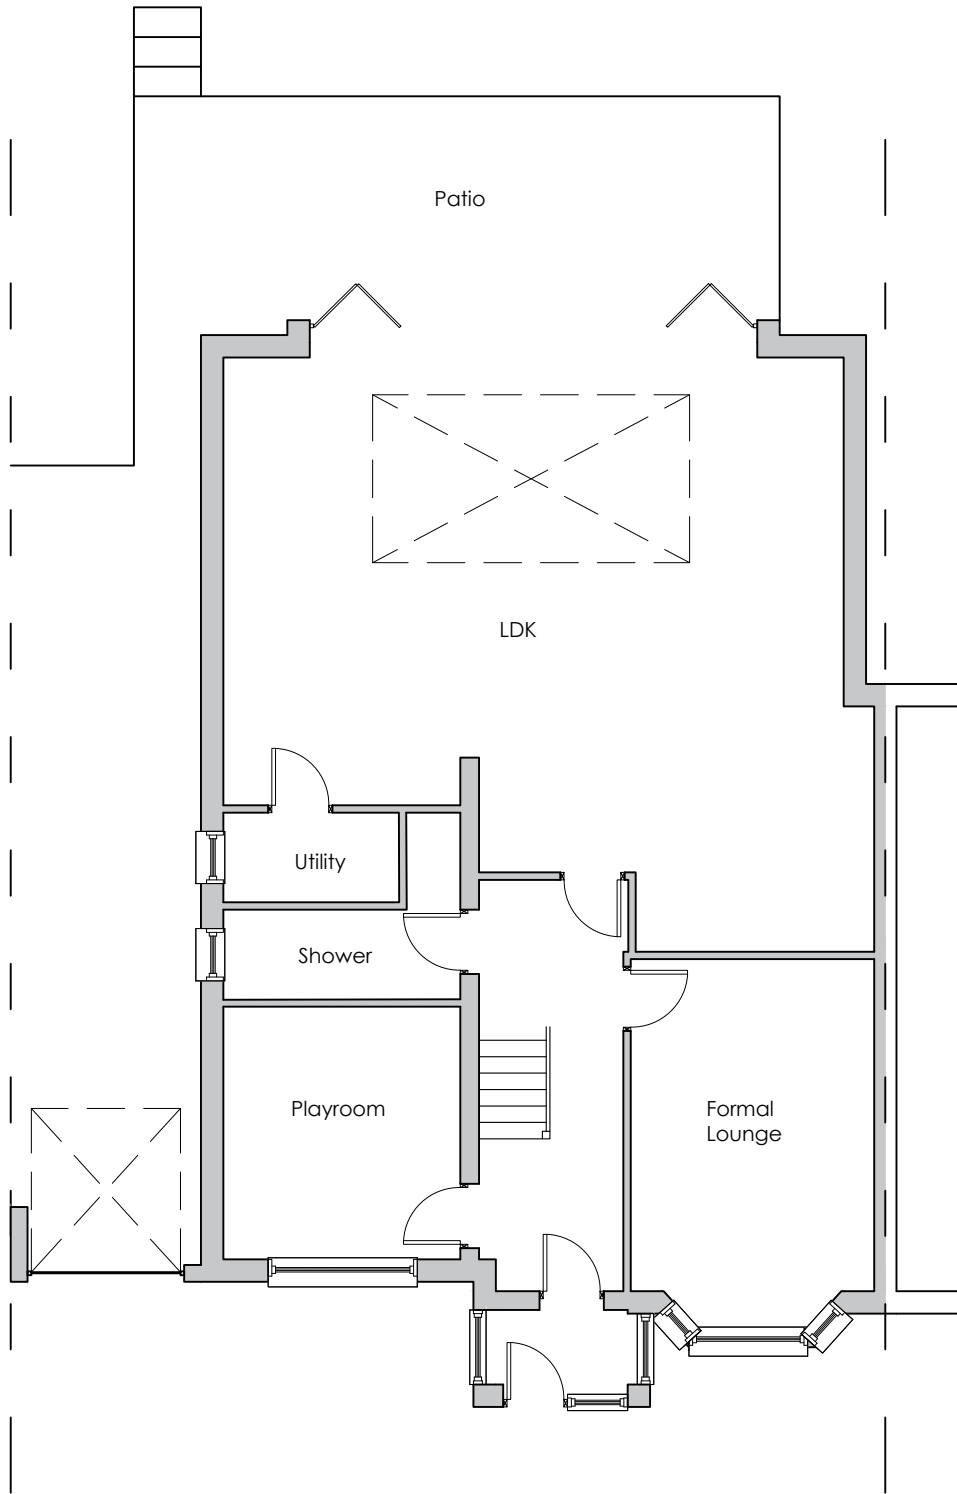


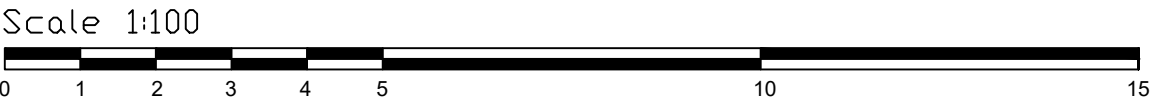

1 As Built Ground Floor Plan

SCALE: 1:100

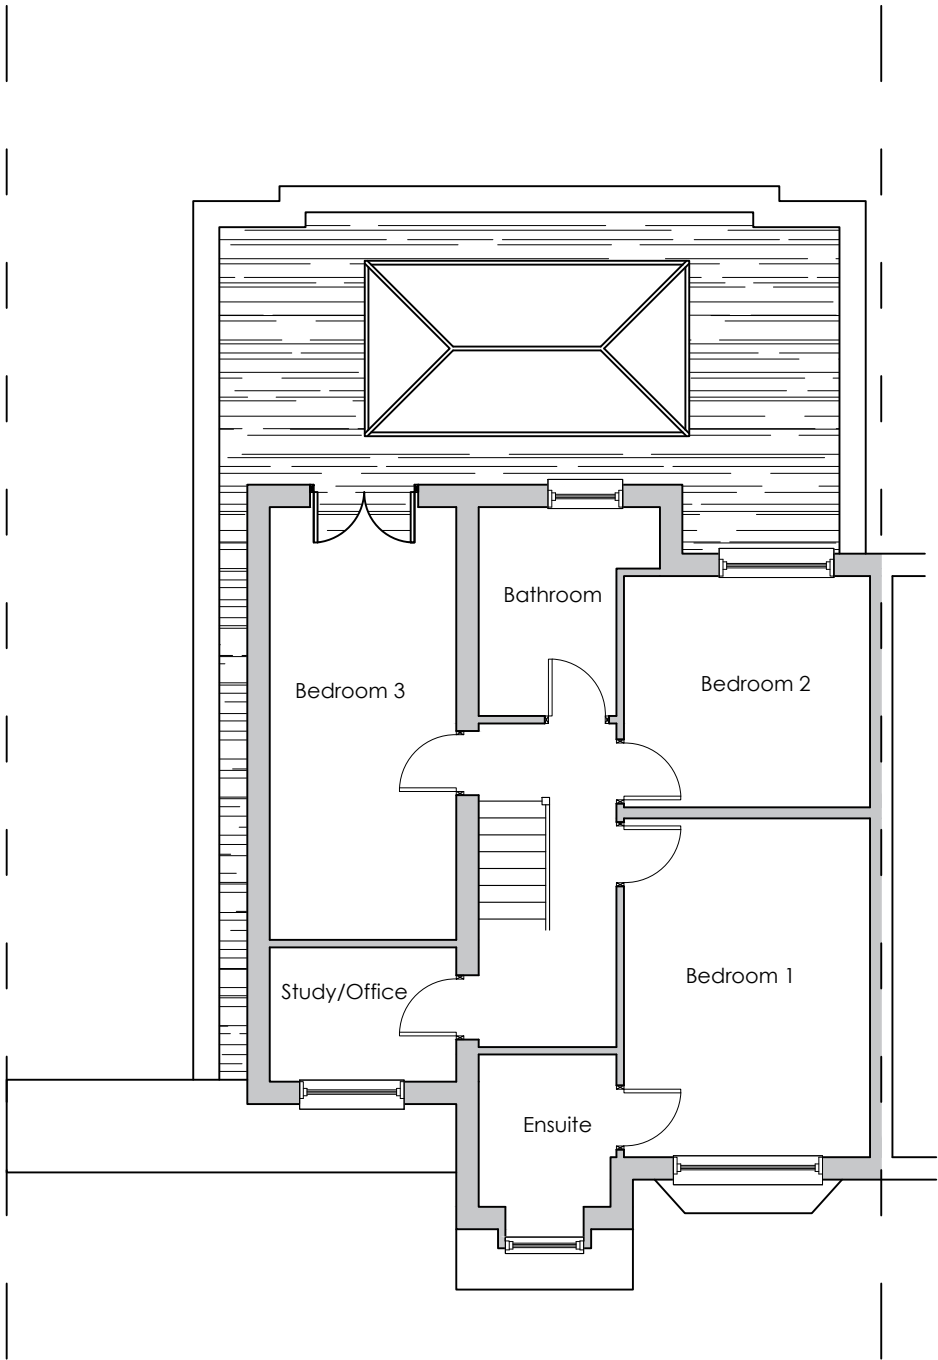

2 As Built First Floor Plan

SCALE: 1:100

Notes:

1. THIS DRAWING IS COPYRIGHTED AND IT MAY NOT BE REPRODUCED IN WHOLE OR PART OR USED FOR THE MANUFACTURE OF ANY ARTICLE WITHOUT THE EXPRESS PERMISSION OF THE COPYRIGHT HOLDERS.
2. WORK TO FIGURED DIMENSIONS ONLY.
3. THIS DRAWING IS TO BE READ IN CONJUNCTION WITH ALL RELEVANT ARCHITECTS AND ENGINEER'S DRAWINGS AND SPECIFICATIONS.
4. ALL PROPOSED MATERIALS ARE TO MATCH THE EXISTING. BRICKWORK TO MATCH AS CLOSELY TO THE EXISTING, ROOF TILES TO MATCH EXISTING, GLAZING TO MATCH EXISTING.
5. GLAZING SHOWN ON THE BOUNDARY IS TO CONTAIN OBSCURED GLASS

REV: DESCRIPTION: BY: DATE:

STATUS: Planning



CLIENT: Mr Sandeep Lal
80 Copthall Road West
Ickenham
UB10 8HT

ARCHITECT: MSD Design & Build
E: msdbuilddesign@gmail.com
T: 07849966744

SITE: 80 Copthall Road West
Ickenham

TITLE: As Built Floor Plans

SCALE AT A3: 1:100 DATE: Jul 2023 DRAWN: HD CHECKED: HD

PROJECT NO: 80CRW DRAWING NO: 80CRW/002/PL REVISION: A