


AS-INSTALLED FRONT ELEVATION

Scale 1:50

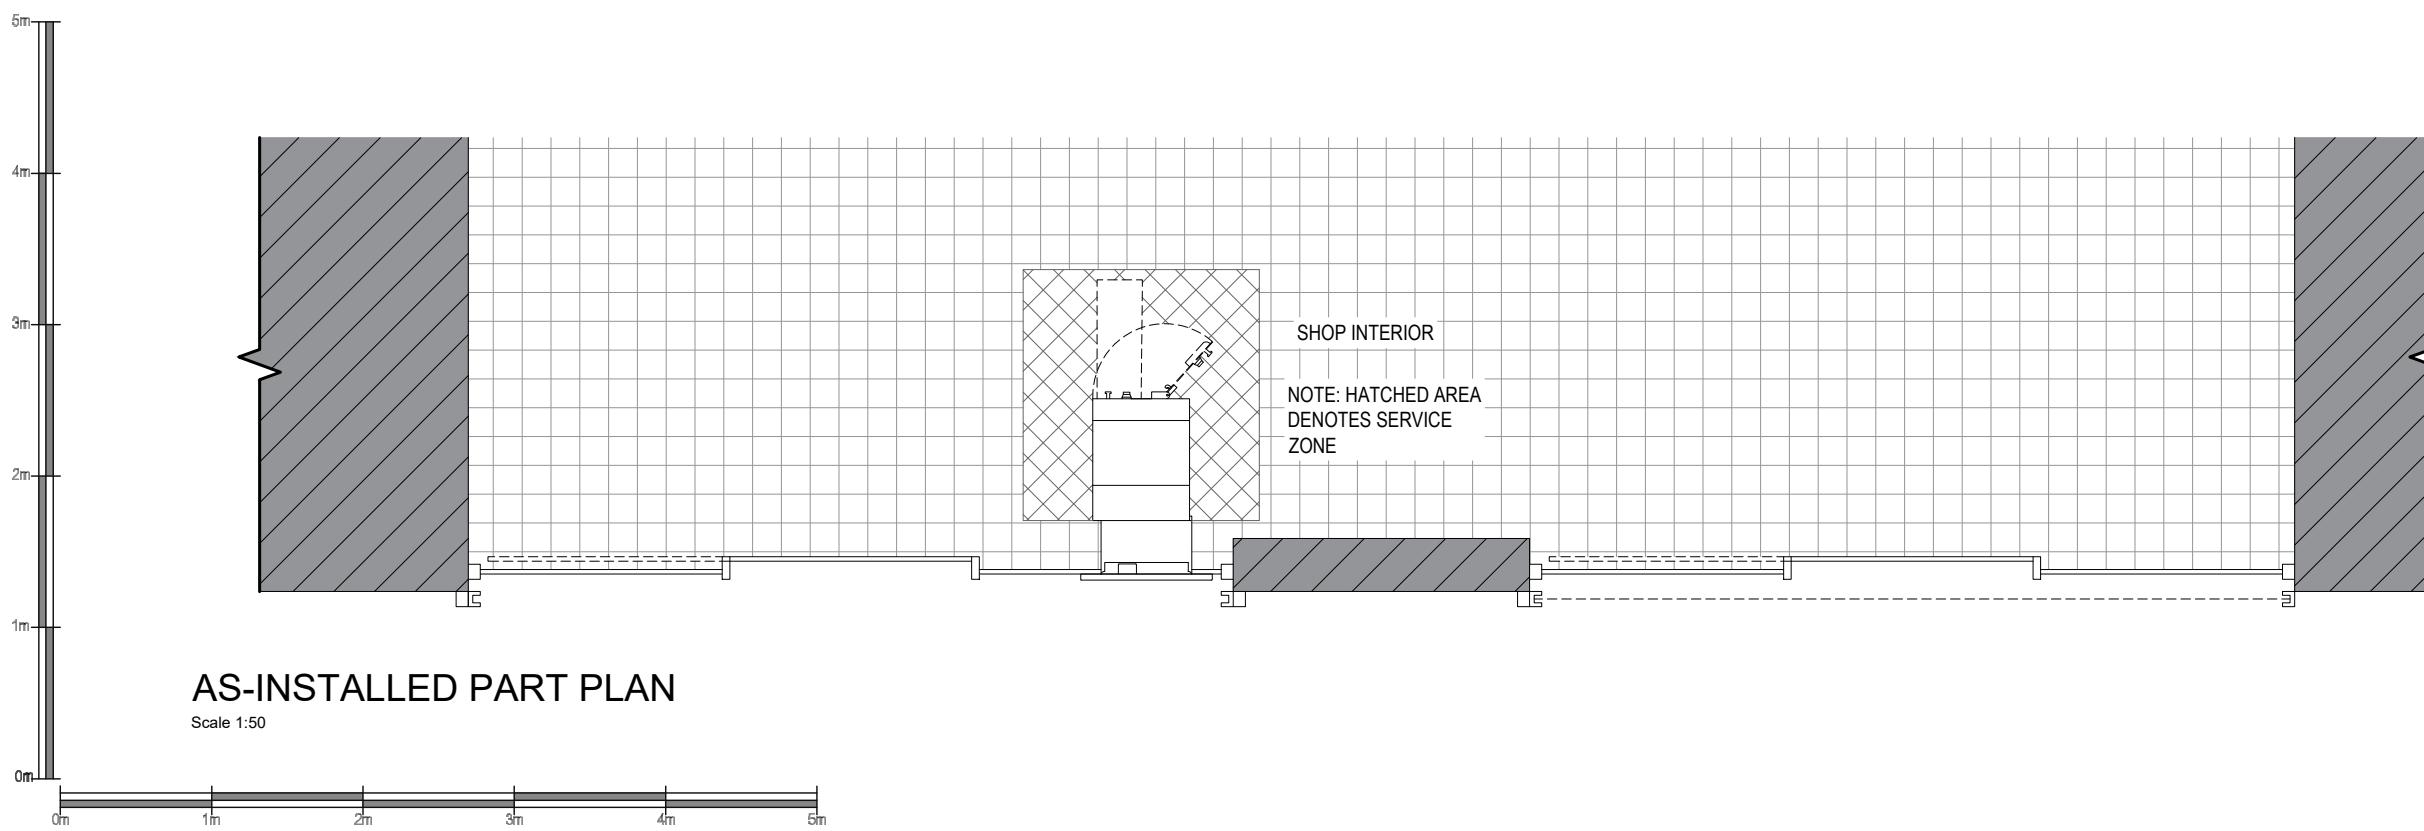

Date:	Comments:	By:
GENERAL NOTES:		
1) All dimensions in millimeters unless otherwise stated.		
Site: Aylsham Food & Wine Ltd, 114-116 Aylsham Drive, Ickenham, Uxbridge, UB10 8UD		
Drawing Title: As-Installed Plan and Elevation		
Ref: T019533_AI	Date: 18/12/2019	Rev:
Scale: 1:50	Paper: A3	Date Rev: