



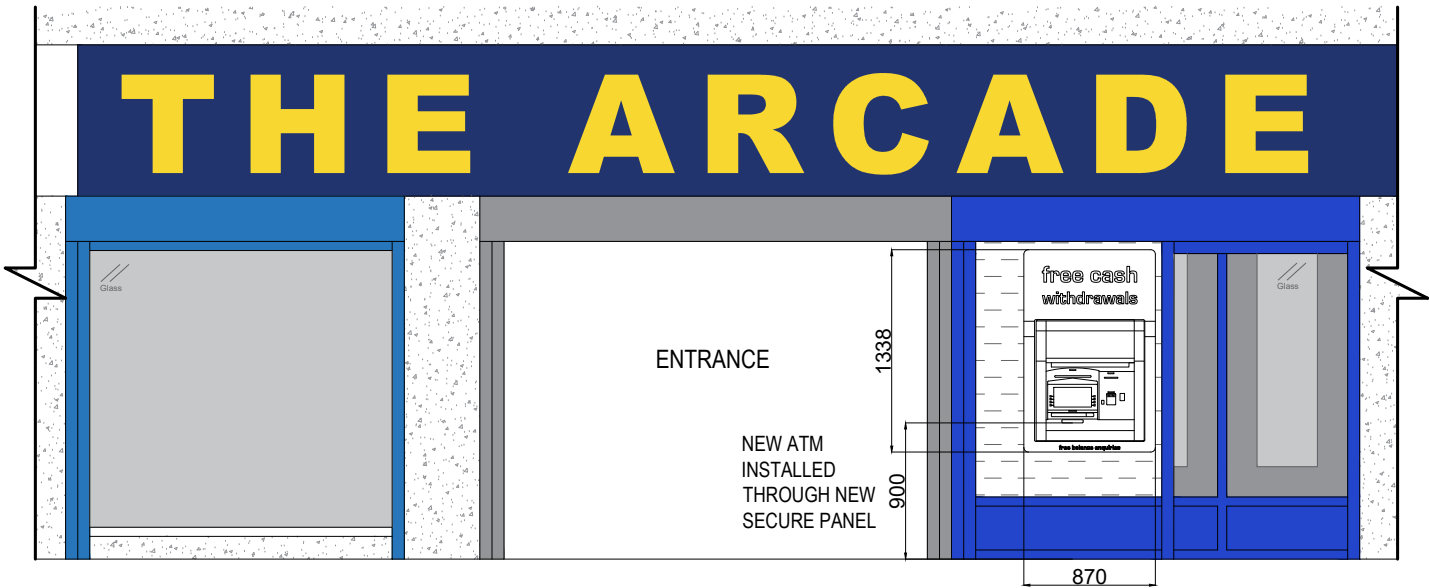


AS-INSTALLED SIDE ELEVATION

Scale 1:50

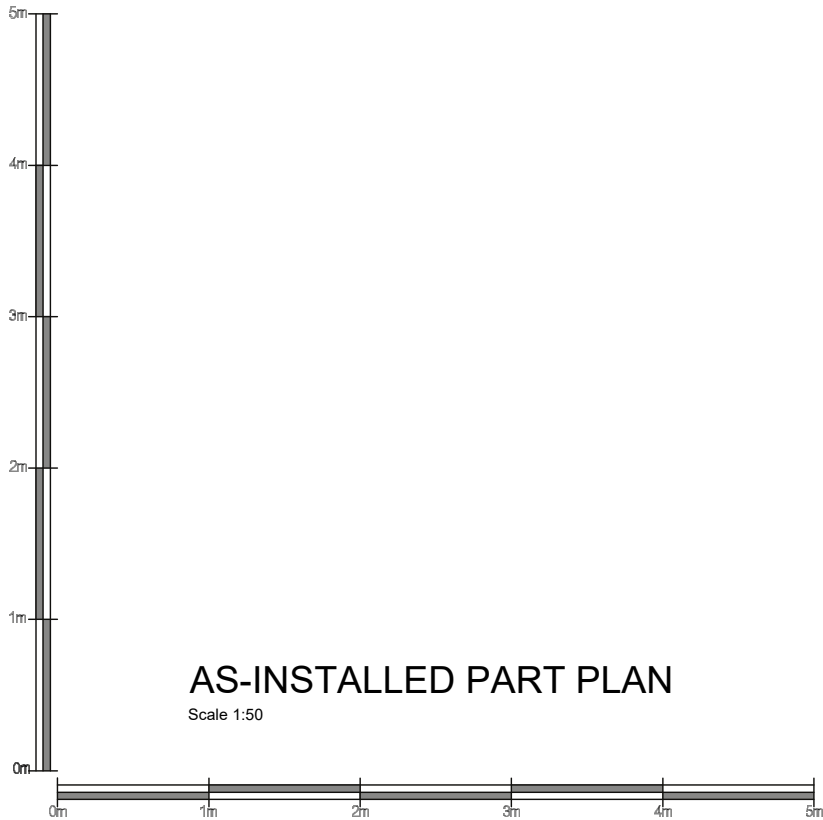

AS-INSTALLED PART PLAN

Scale 1:50

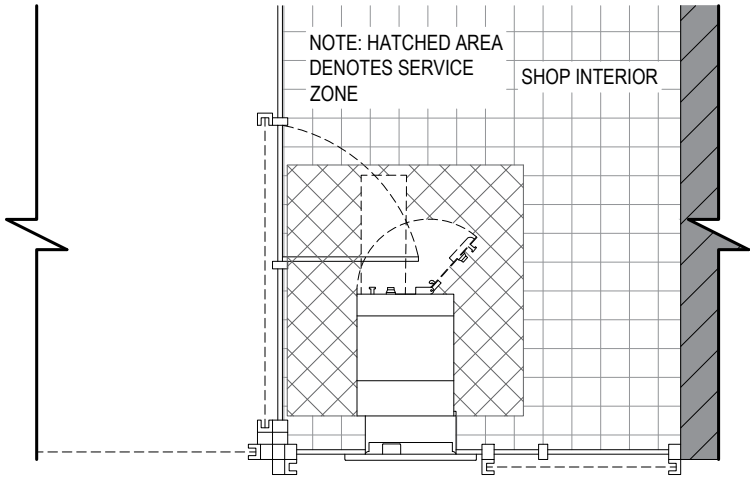

Date: Comments: By:

GENERAL NOTES:
1) All dimensions in millimeters unless otherwise stated.

Site:
The Arcade - Baydee Traders Ltd,
277 High Street,
Uxbridge

Drawing Title:
As-Installed Plan and Elevation

Ref:	Date: 18/07/2018	Rev:
Scale: 1:50	Paper: A3	Date Rev: