




As built ground floor plan

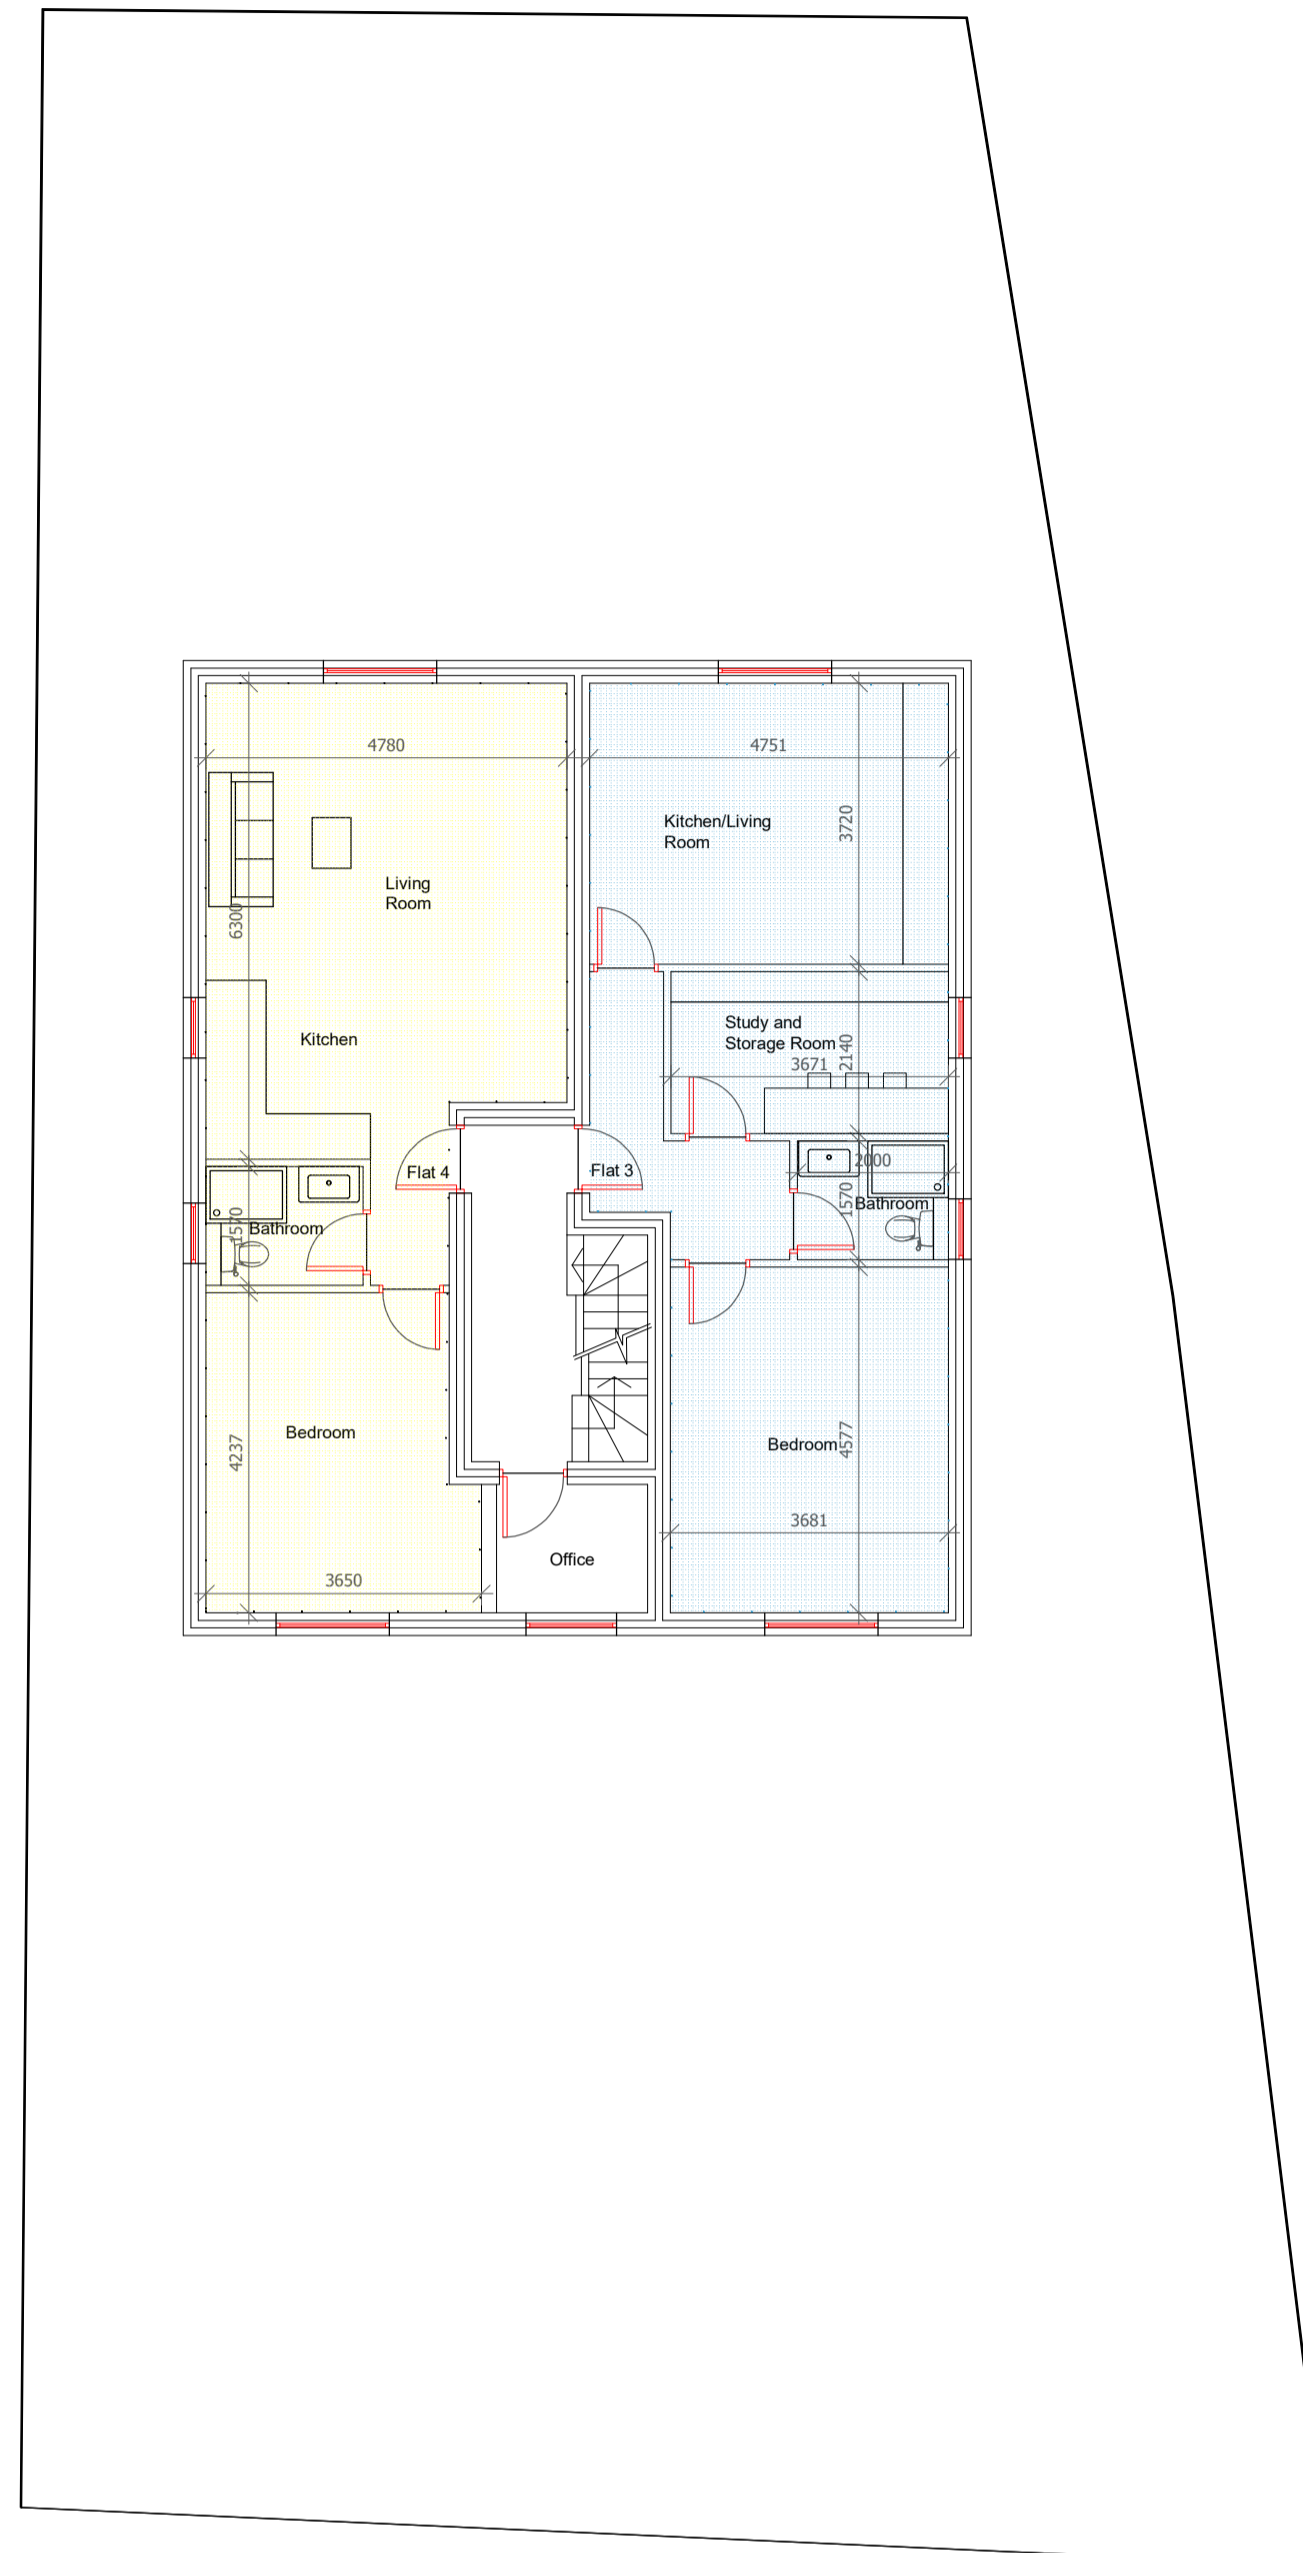

As built first floor plan

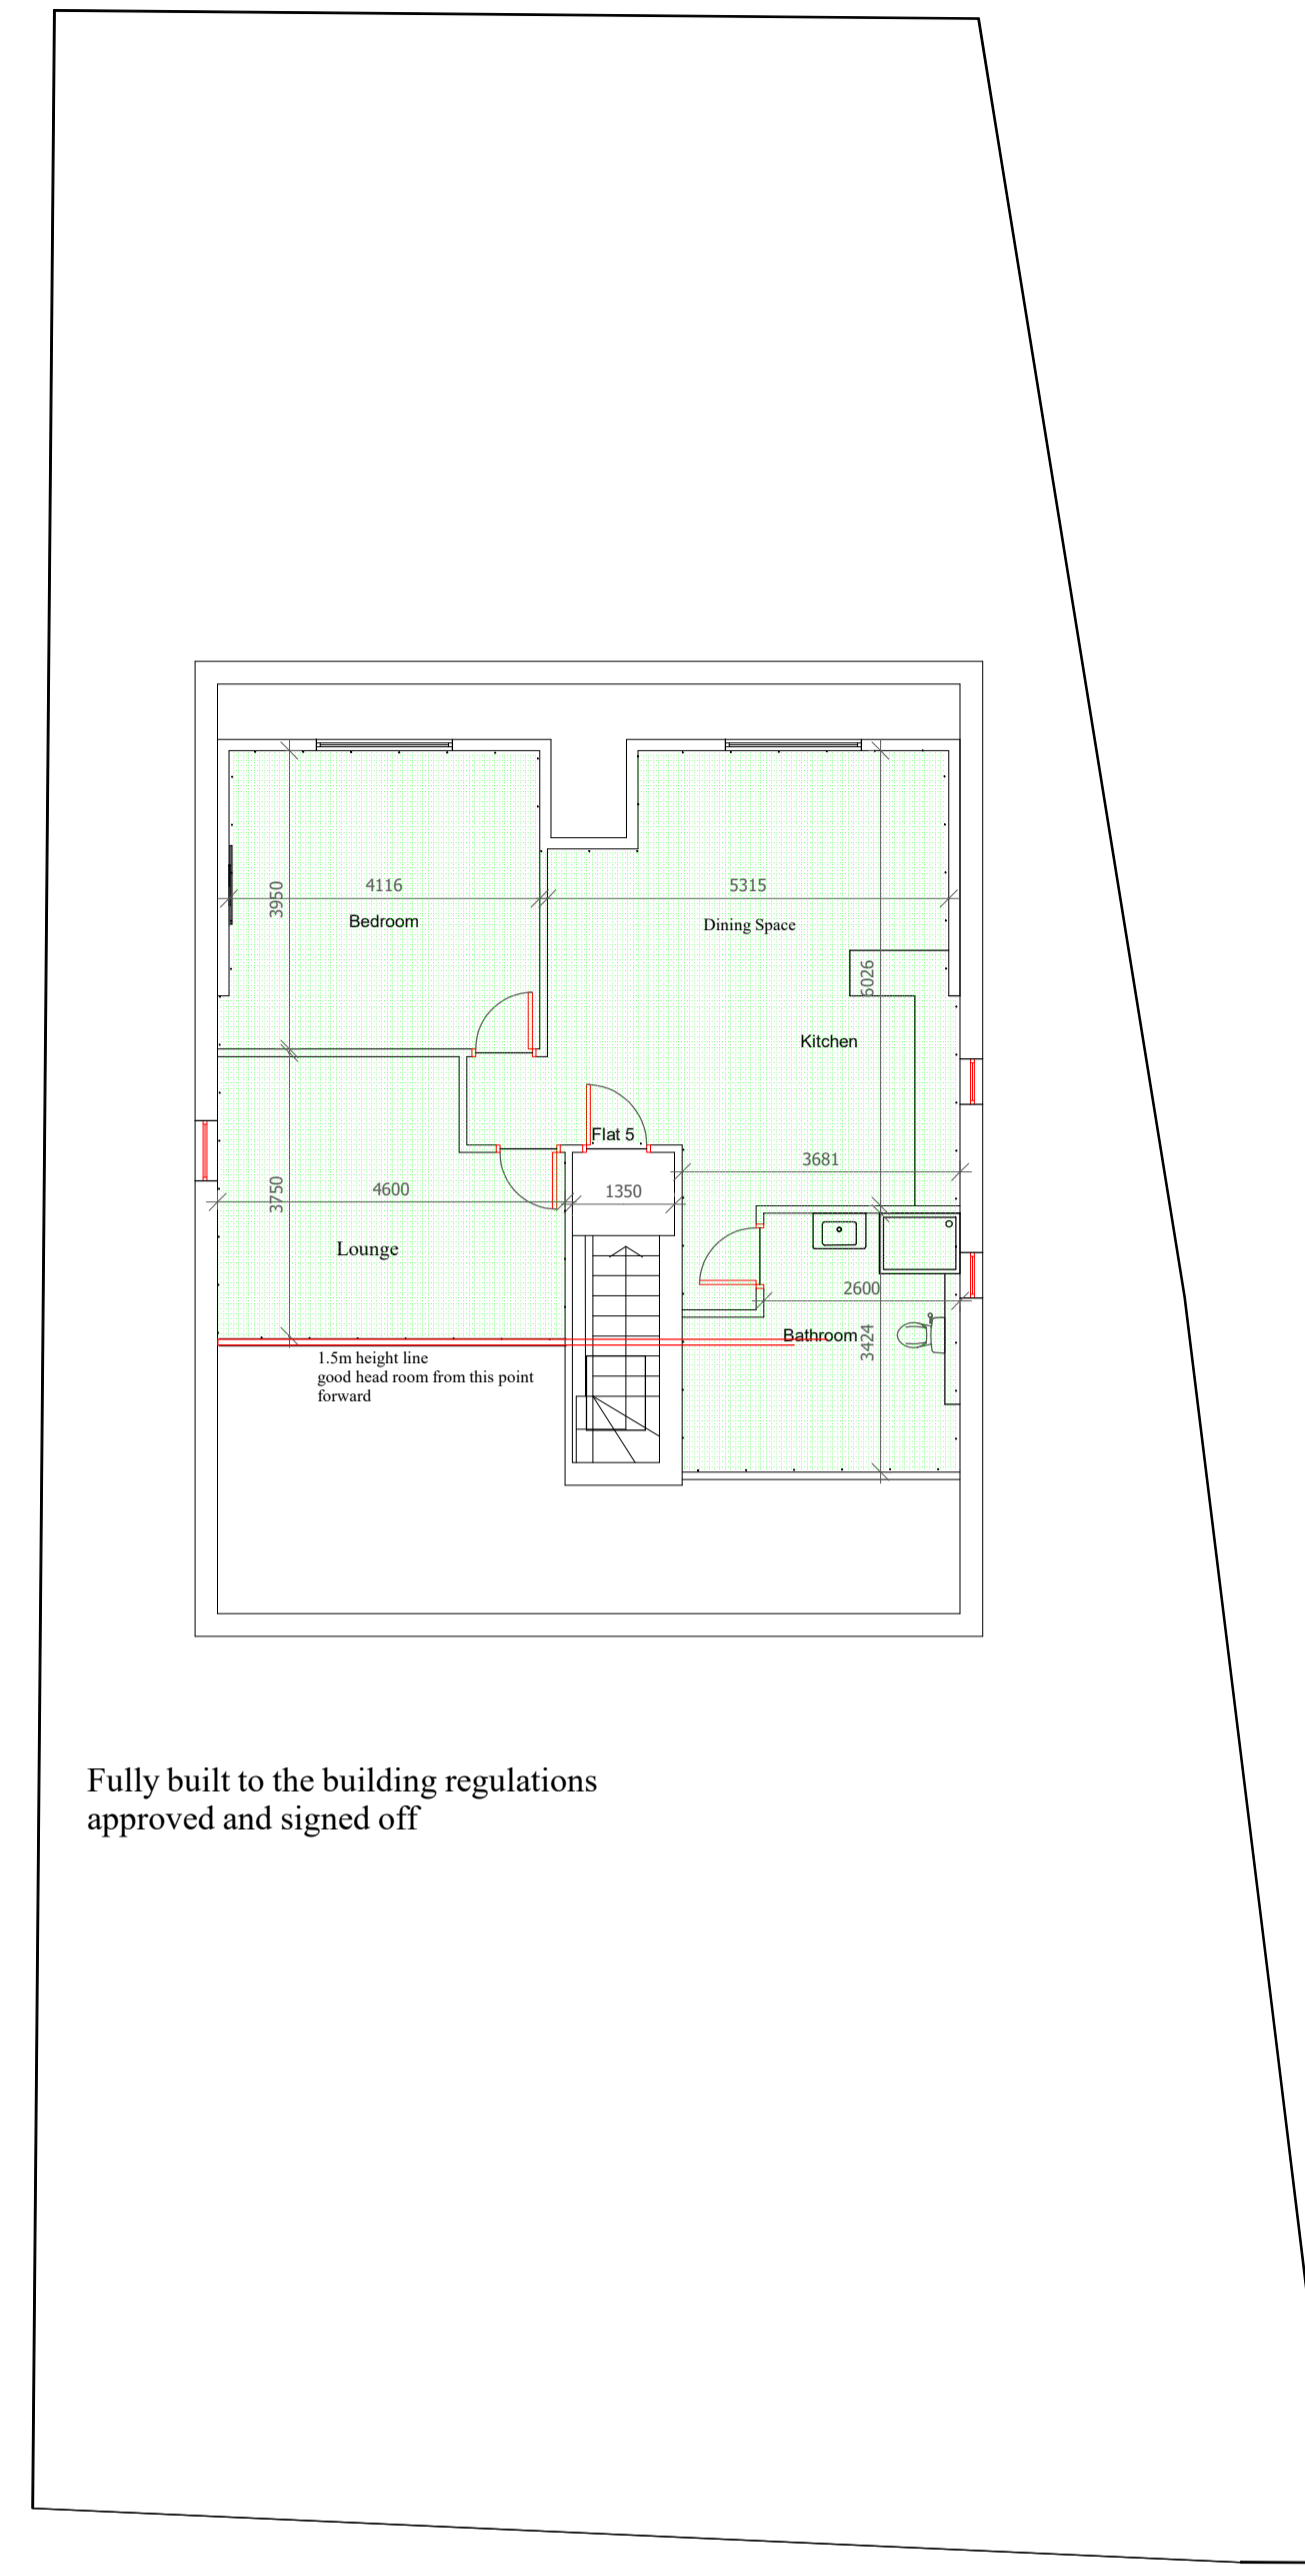

As built loft floor plan

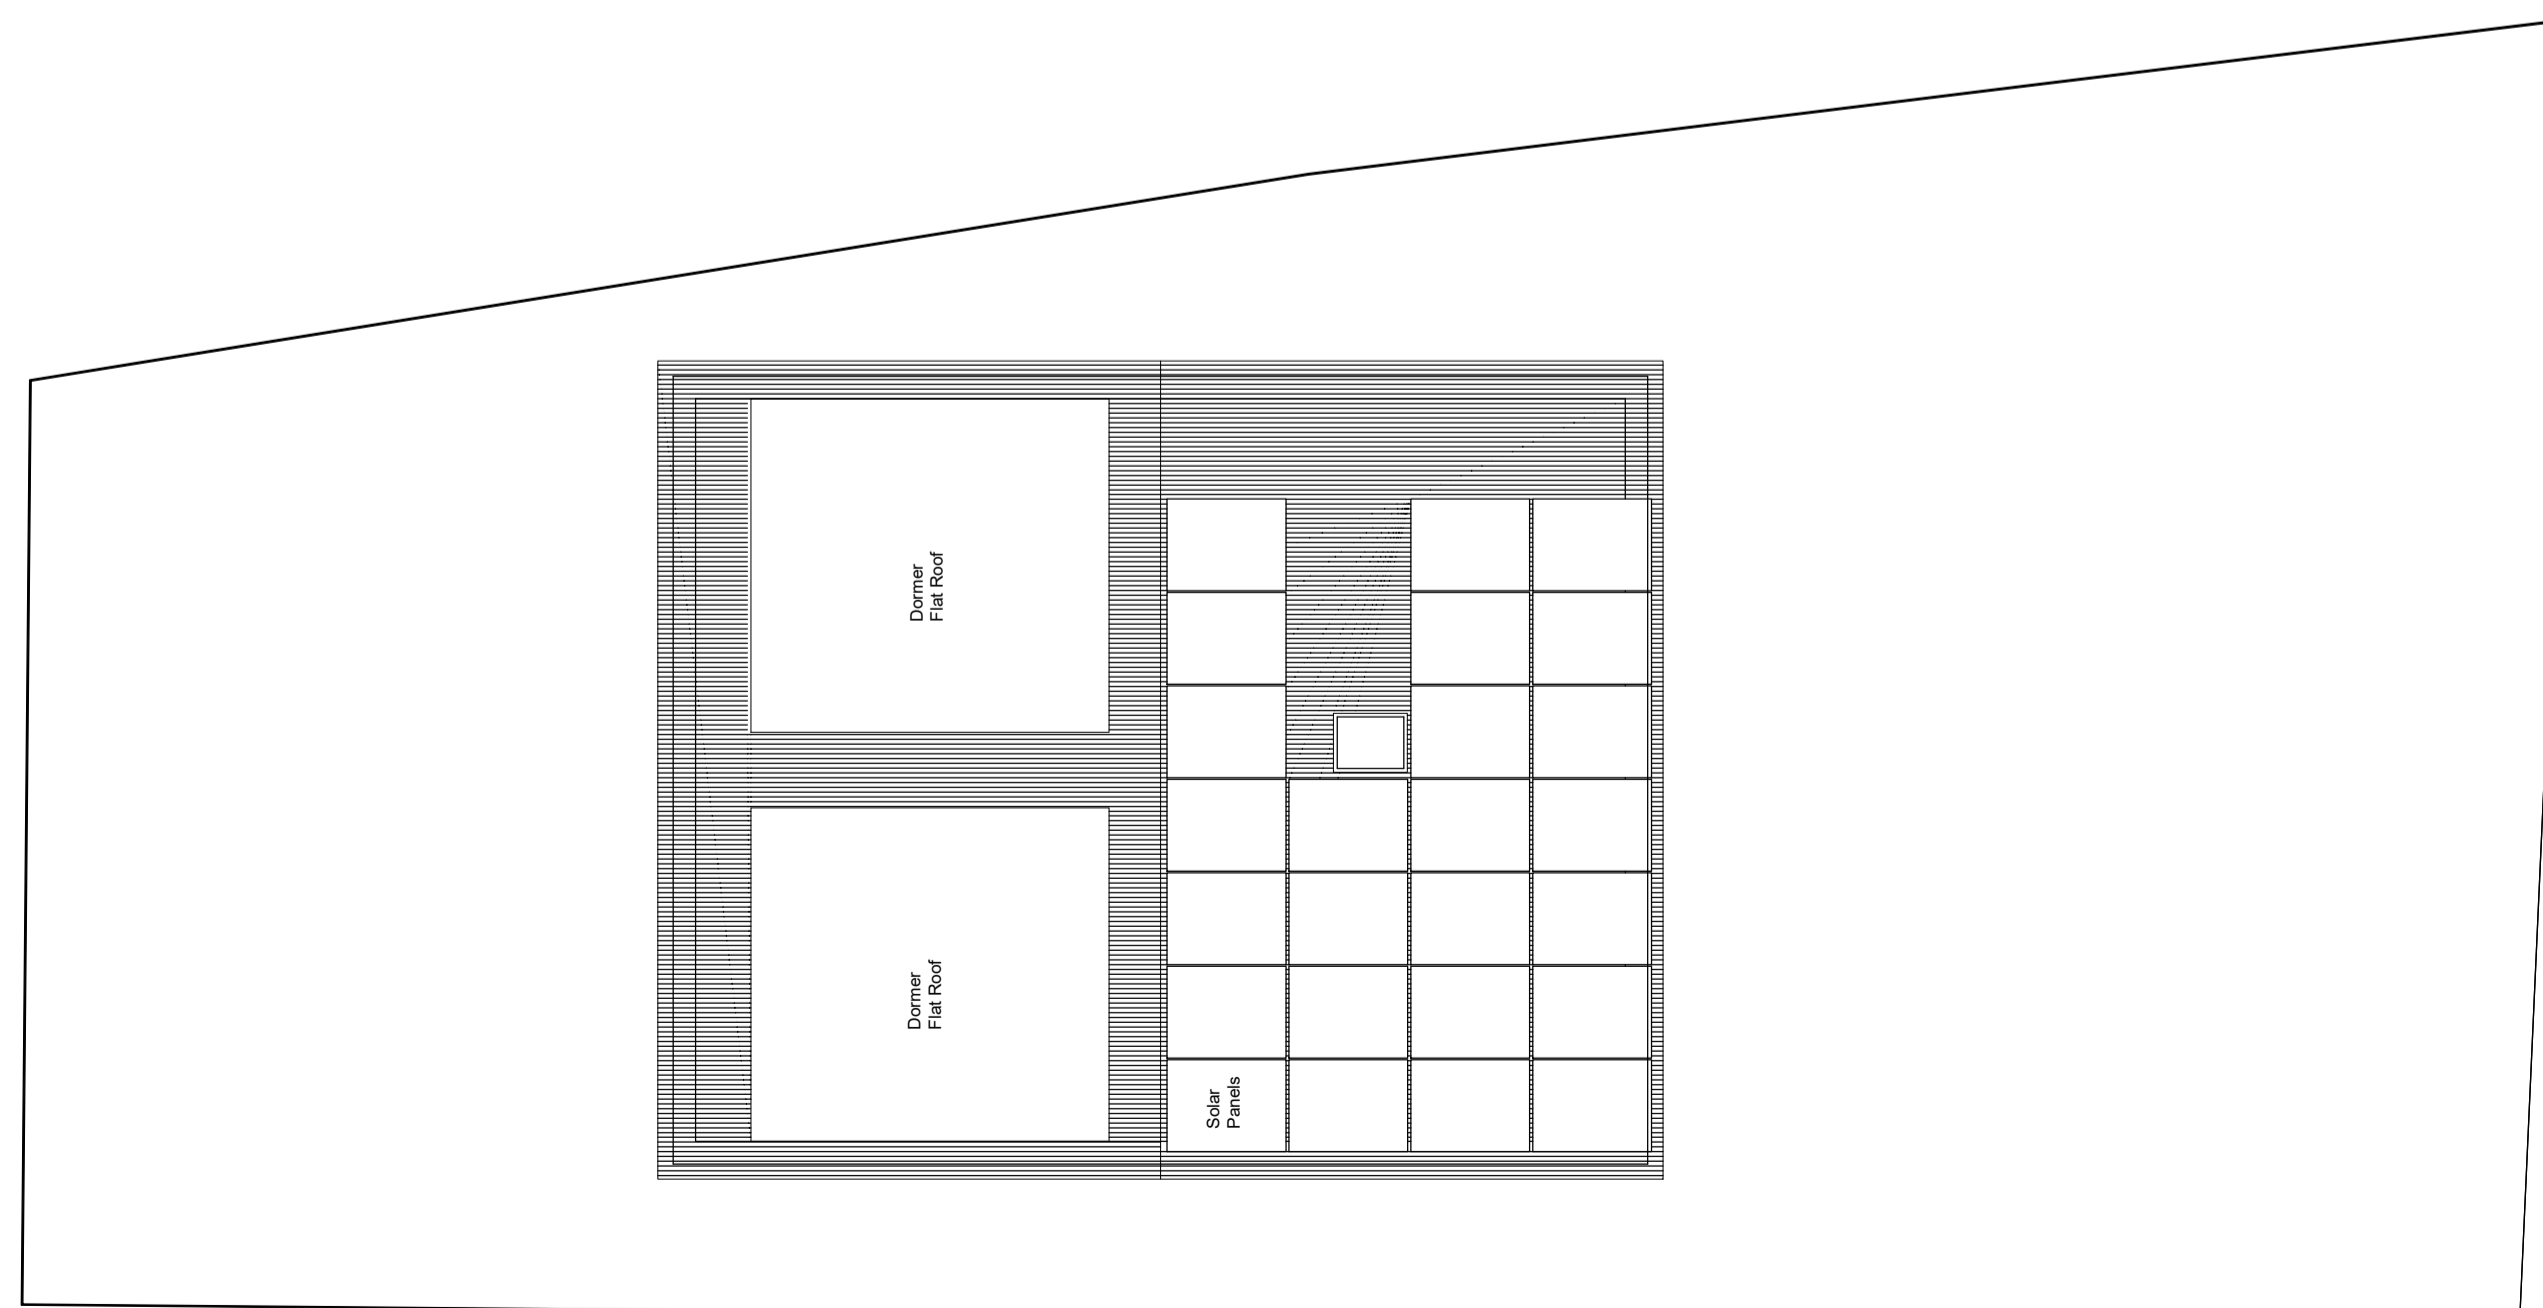


As built roof plan

Notes

- 1 All concrete to be 1:2:4 mix by volume
- 2 All dimensions are in millimeters
- 3 All materials used to be half hour fire resistance and used to manufacturers instructions
- 4 All new gullies to be roddable and back inlet type.
- 5 New walls bonded to existing using 'Furfix' or similar profiles.
- 6 The contractor to check all dimensions before commencement of works and inform the Client of any discrepancies.
- 7 All works to be carried out in accordance with Building regulations and British Standards, all in approval of the LA engineer.
- 8 All new glazing below 1000 from floor level to be toughened safety glass to BS6206.
- 9 All structural timber to be tannalised VERMIN
- 10 Any proposed works likely to be affected by landfill gas to have 0.25 ZEDCOR polymer thermoplastic with ZEDCOR DPM jointing system across the cavity at DPC level with cavity trays over, the floor slab to be vented using herringbone land drains out to air bricks.
- 11 All dimensions to be double checked on site
- 12 All steels to be measure on site with built dimensions
- 13 Steels to have 30 min fire protection
- 14 All drawings to be approved prior to Build works, any works carried out without approval is at own risk.
- 15 Any discrepancies to be discussed with our team prior to works, any changes made on site to be submitted to and approved by us in writing

Scale 1/100

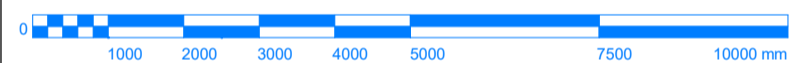

Title / Description :

As Built Plans

Project Address :

Oxenev Cottage  
Thorney Mill Road West Drayton

Scale of Drawing

1/100 @ A1

Drawing No

Ox 001

Drawn By

Sunny Bahia

Date of Proj

Feb 26

**AsB Architecture Ltd**

PLANNING - ENGINEERING - MANAGEMENT

[Asbarchitectureltd@gmail.com](mailto:Asbarchitectureltd@gmail.com)

Office / Mobile - 07960 417 920



Flat 1 - 1 bedroom 2 person - 57sqm

Flat 2 - 1 bedroom 2 person - 59sqm

Flat 3 - 1 bedroom 2 person - 52sqm

Flat 4 - 1 bedroom 2 person - 52sqm

Flat 5 - 1 bedroom 2 person - 72sqm