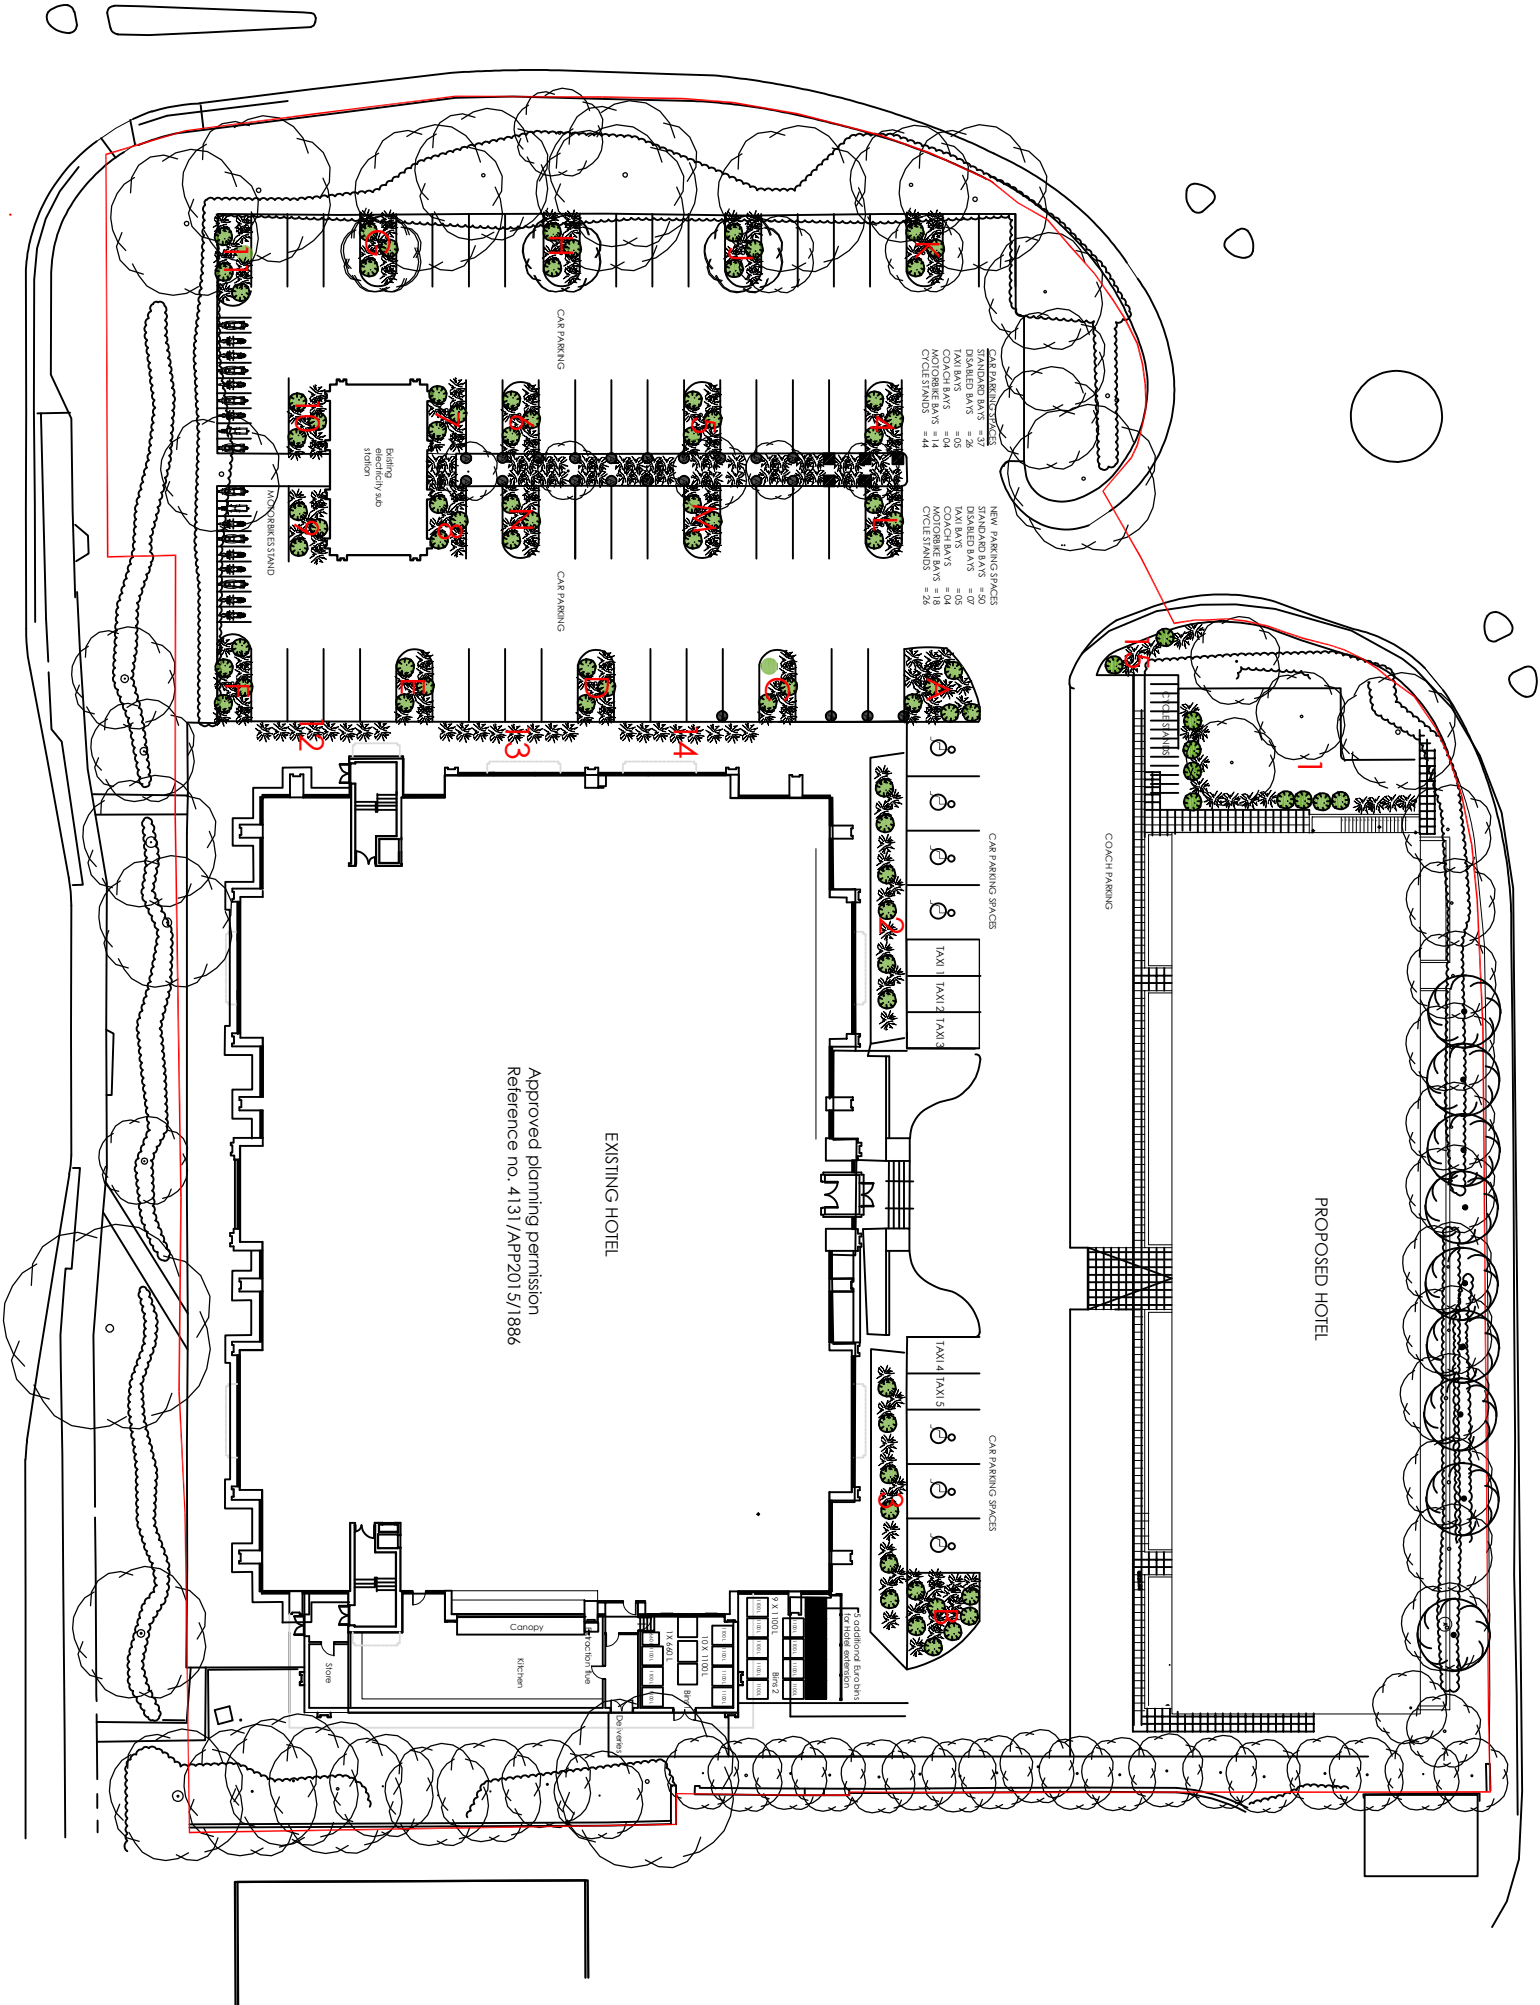


Notes:
1. All dimensions are given in meters.
2. All dimensions are given to the center of the line.
3. All dimensions are given to the center of the line.
4. All dimensions are given to the center of the line.
5. All dimensions are given to the center of the line.
6. All dimensions are given to the center of the line.
7. All dimensions are given to the center of the line.
8. All dimensions are given to the center of the line.
9. All dimensions are given to the center of the line.
10. All dimensions are given to the center of the line.

Rev.	Description	Initial	Date

Rev.	Description	Initial	Date

DENNER ELLIS BODDINGTON
CHARTERED ARCHITECTS
Phoenix Yard, 65 King's Cross Road, London WC1X 9LW
Telephone: 020 7239 4803 Fax: 020 78412 7482
E-Mail: architect@dennerellis.co.uk

Client
NINE GROUP LTD

Project
PROPOSED APART HOTEL
BATH ROAD HEATHROW

Drawn: NIT
Checked: NIT
Status: DMC-STATUS
Title
RED LINE SITE PLAN

Date: DATE
Scale: 1:1000@A1 1:500@A3
Drawing no: **23/445 PA.015**
Revision
Anglo Overseas Consultants Limited. This drawing is copyright.