




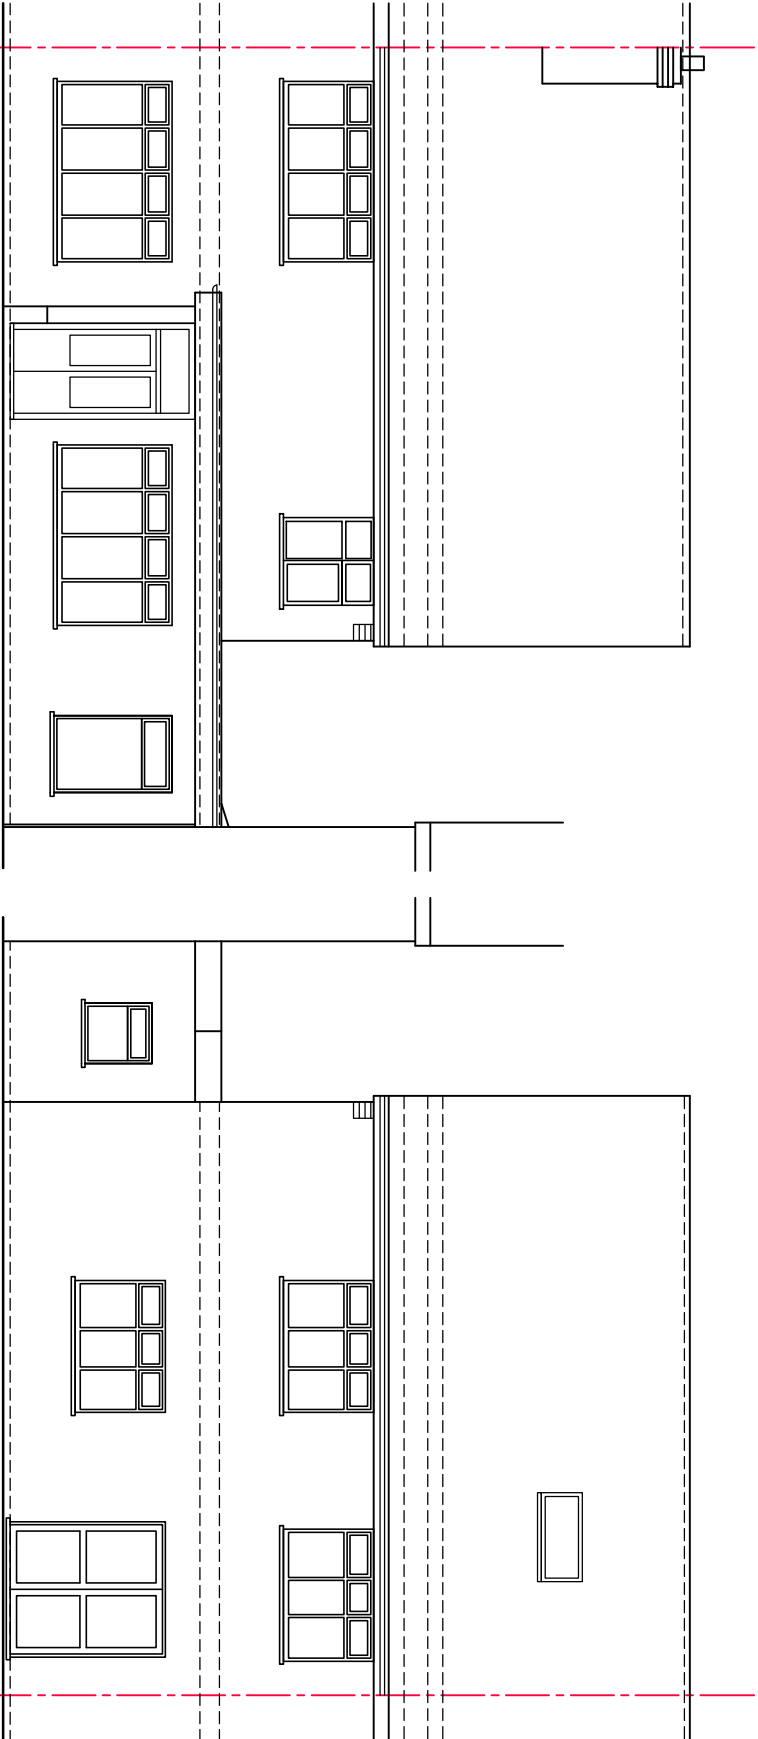


Front Elevation
As Existing

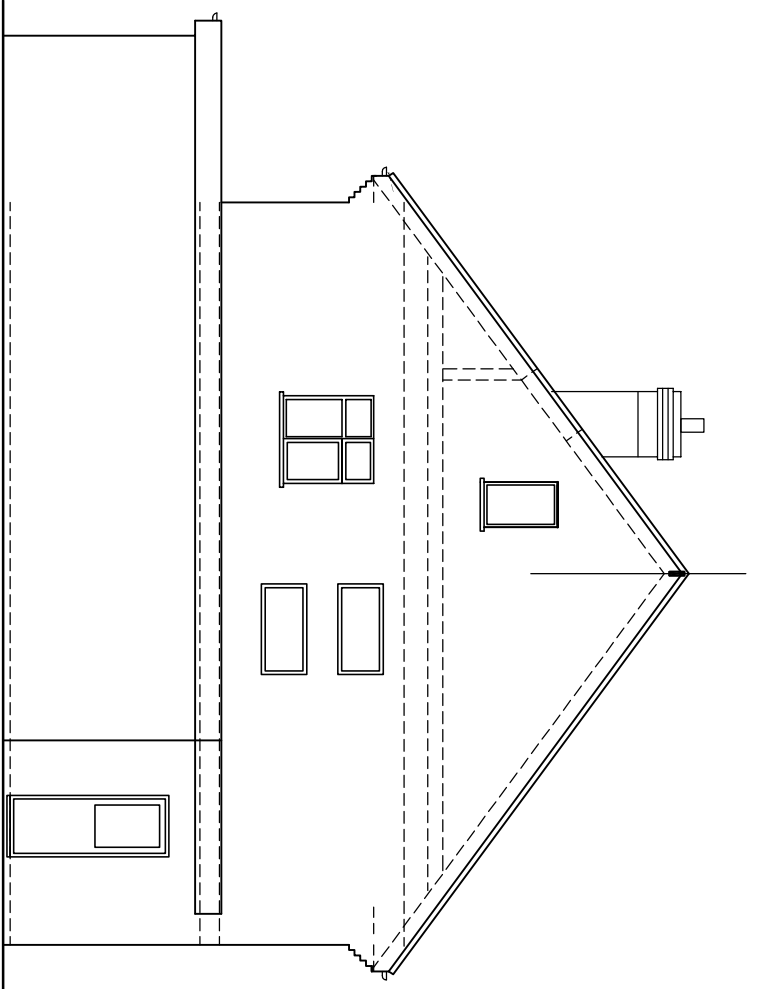


Side Elevation A

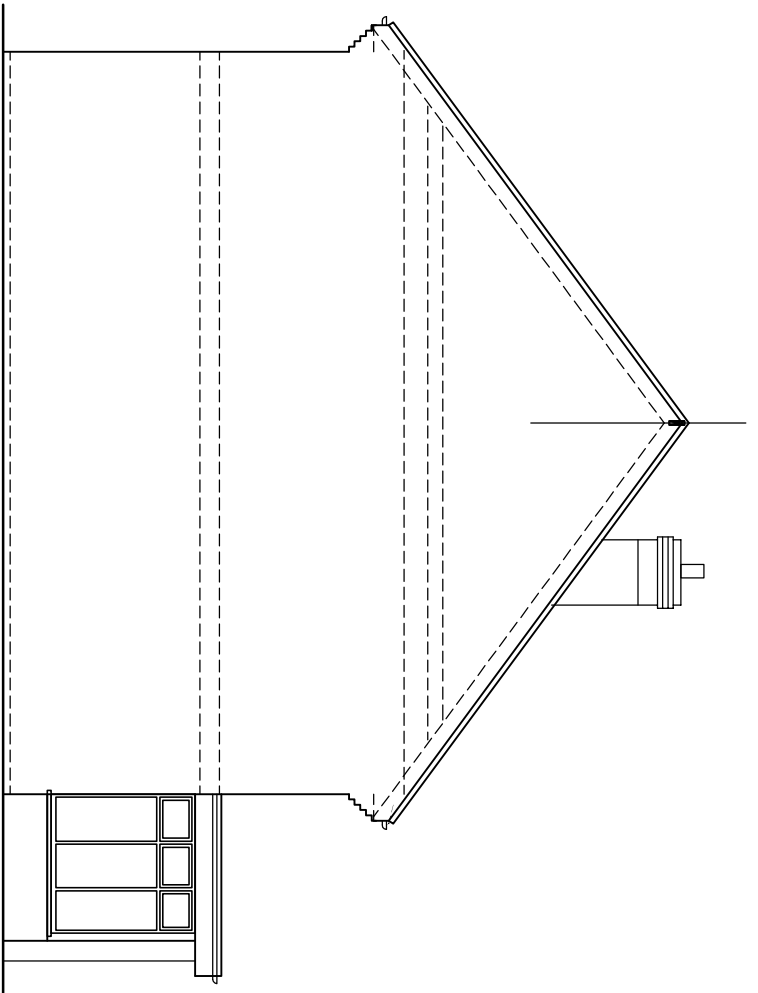


Side Elevation B

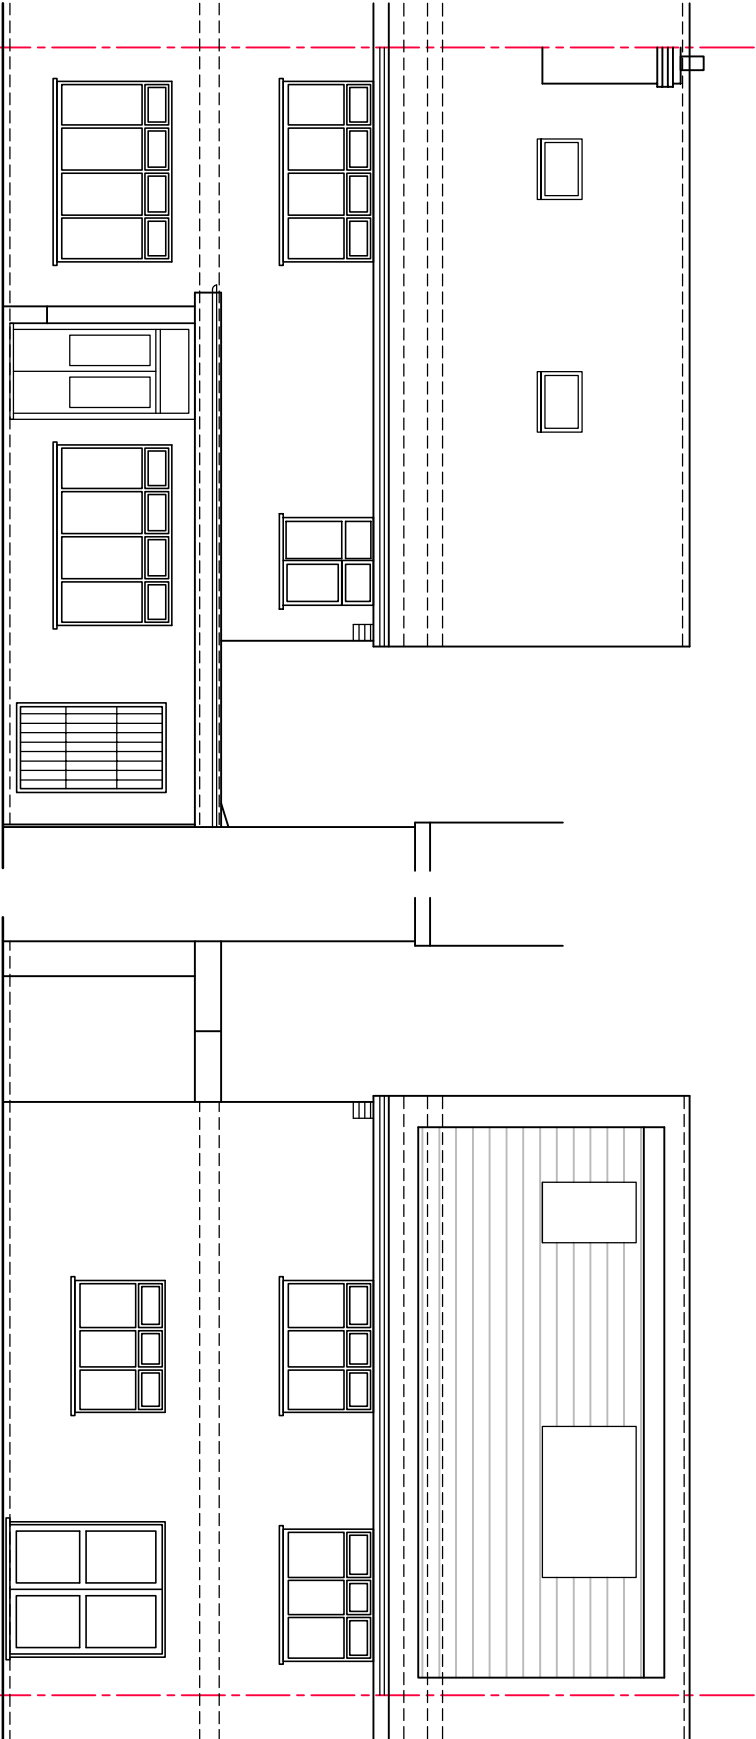


Front Elevation
As Built

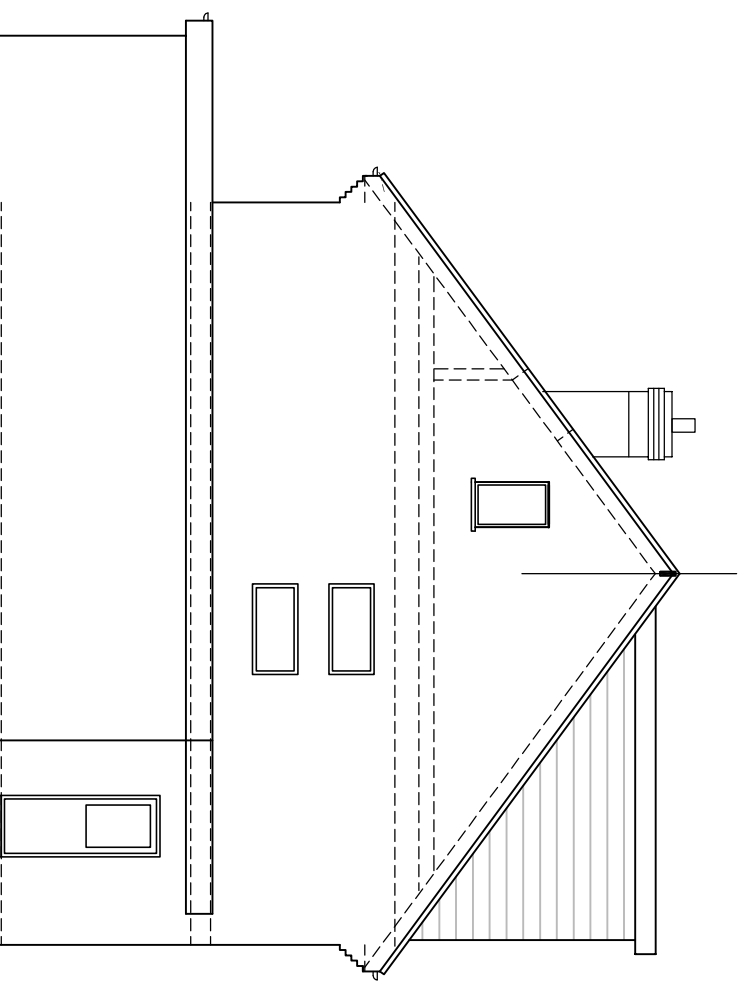


Side Elevation A

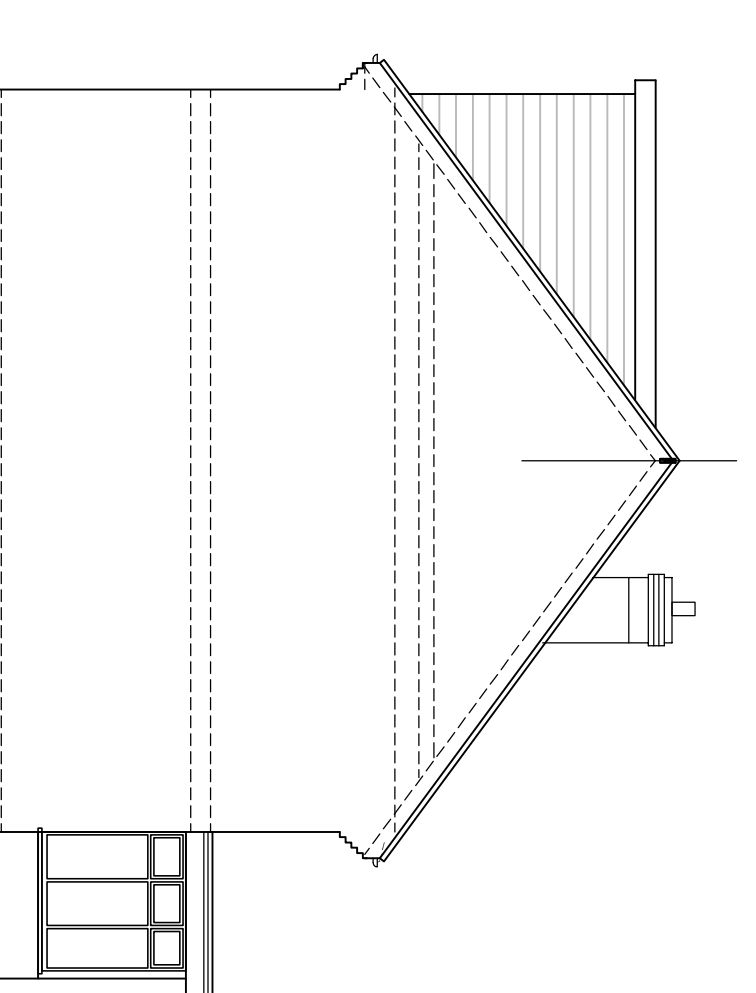


Side Elevation B

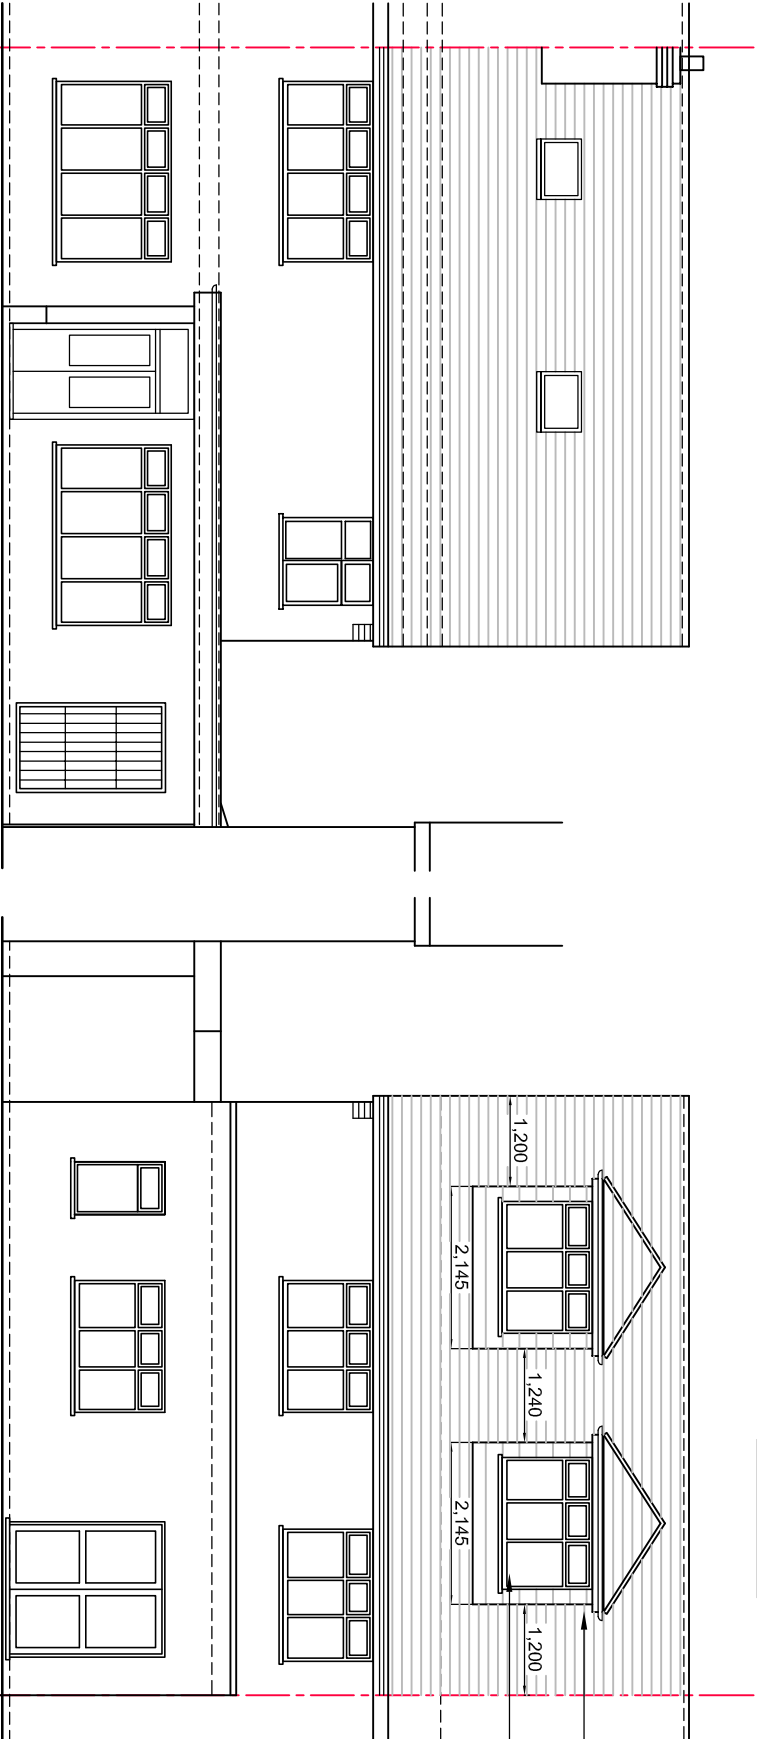

Rear Elevation

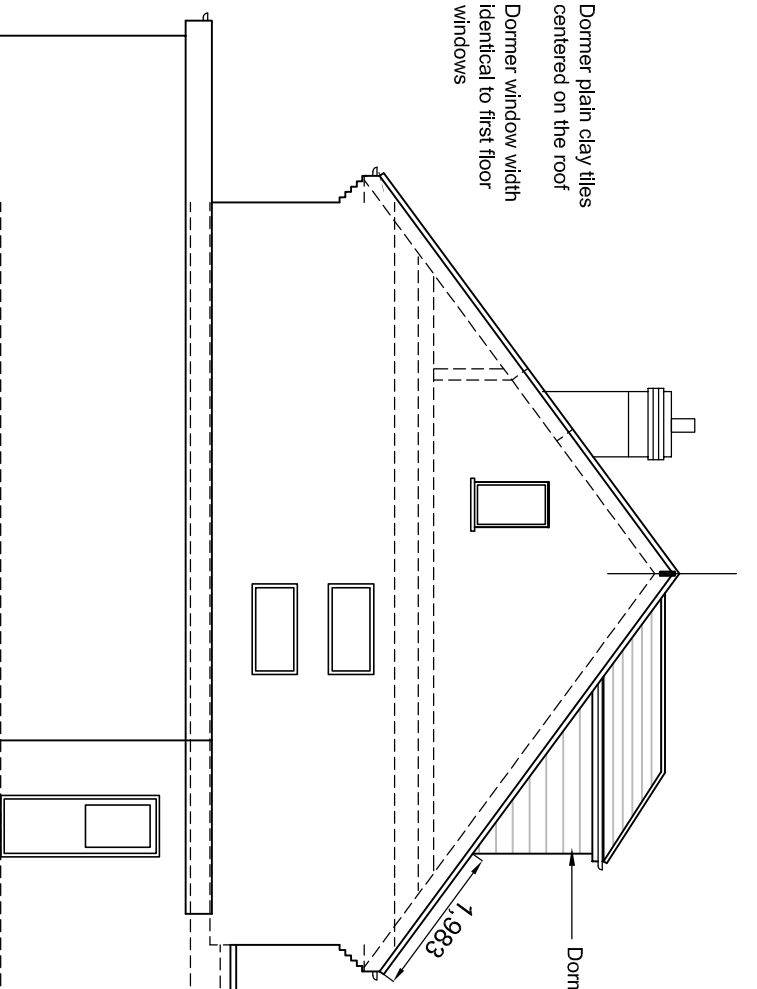

Side Elevation A

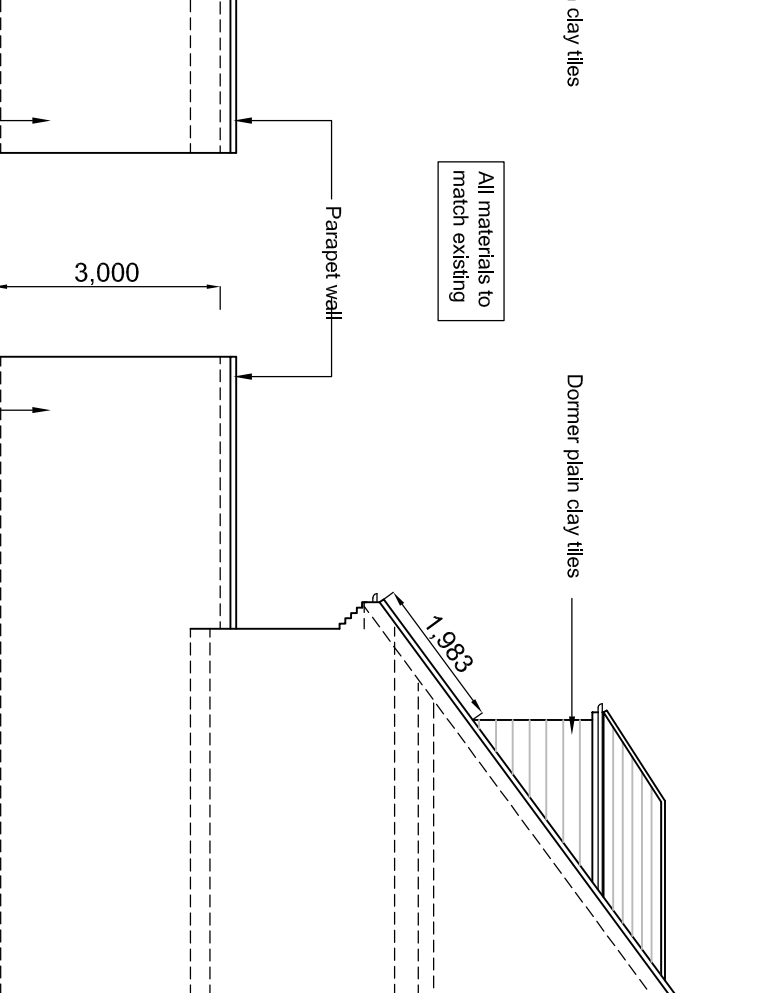

Side Elevation B

Front Elevation
As Proposed

All materials to
match existing

Dormer plain clay tiles
centered on the roof
Dormer window width
identical to first floor
windows

All materials to
match existing

Dormer plain clay tiles

Parapet wall

3,000

Brickwork to
match existing

0m 1m 2m 3m 4m 5m
SCALE BAR IN METERS

Rev A-08-11-2020 Dormer & rear extension reduced

R P Designs 7 Elmhurst Close, Bushey, WD23 2QB Tel: 07346 200924		Client Mr S Ahluwalia	Sheet Title As Existing, As Built & As Proposed Elevations	Project Title 180 Church Road Hayes, UB3 2LS	Page No. PL/180CR/02	Revision A
Scale: 1:100 @ A2		Drawn: RPP	30th Jul 2020			