

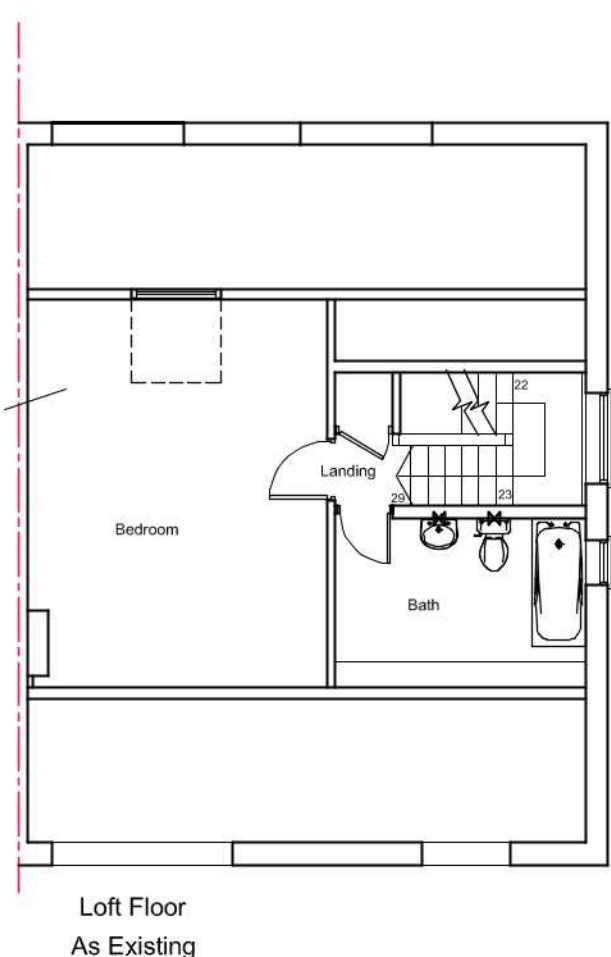
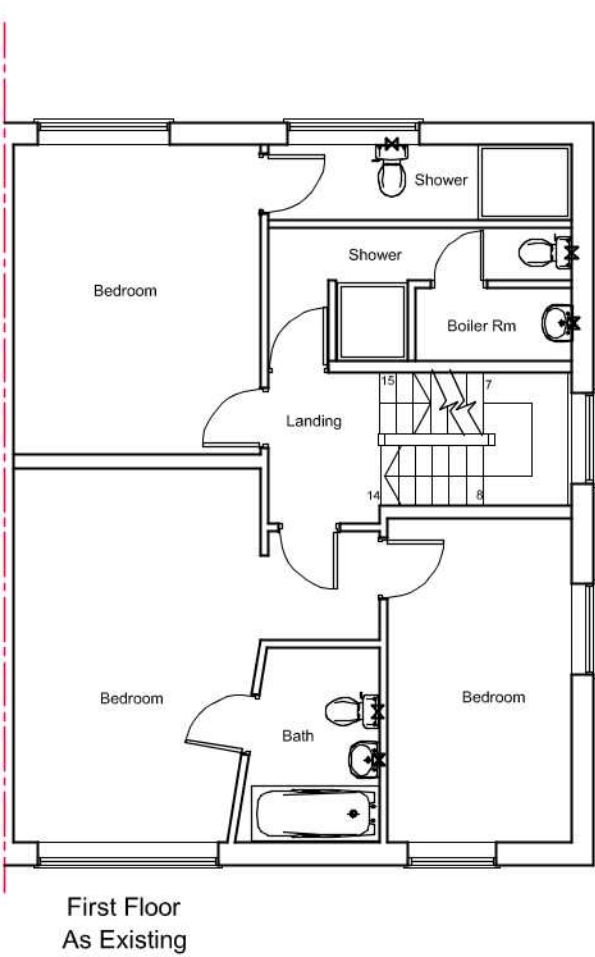
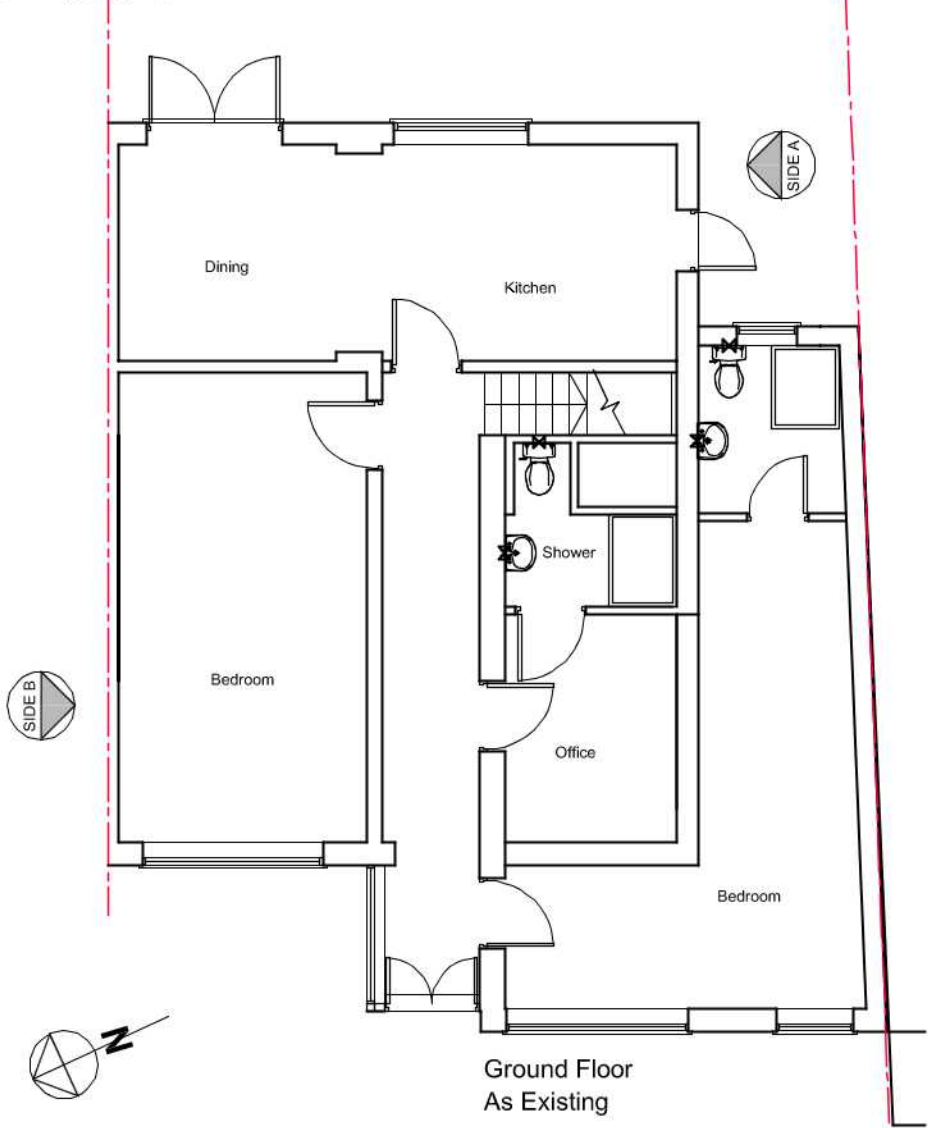
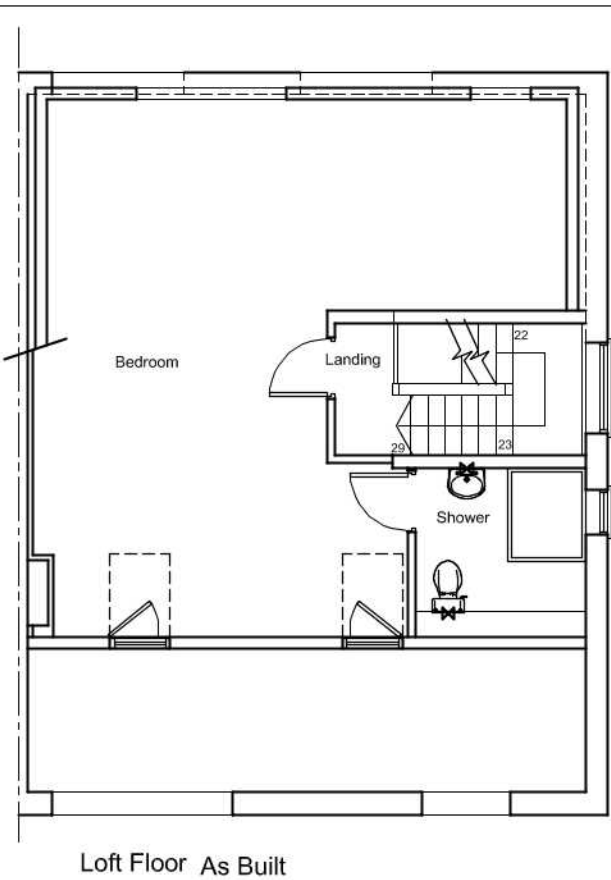


AS EXISTING

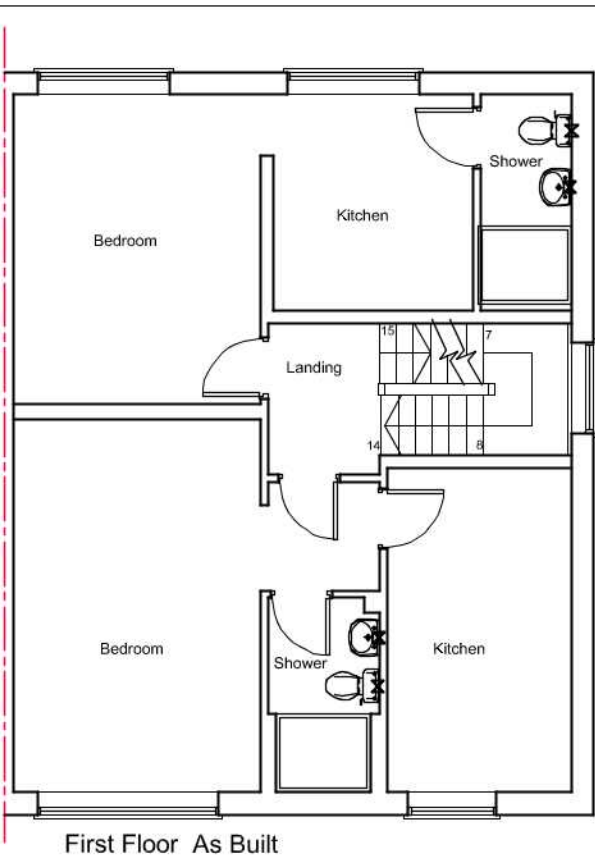




As Existing Front View

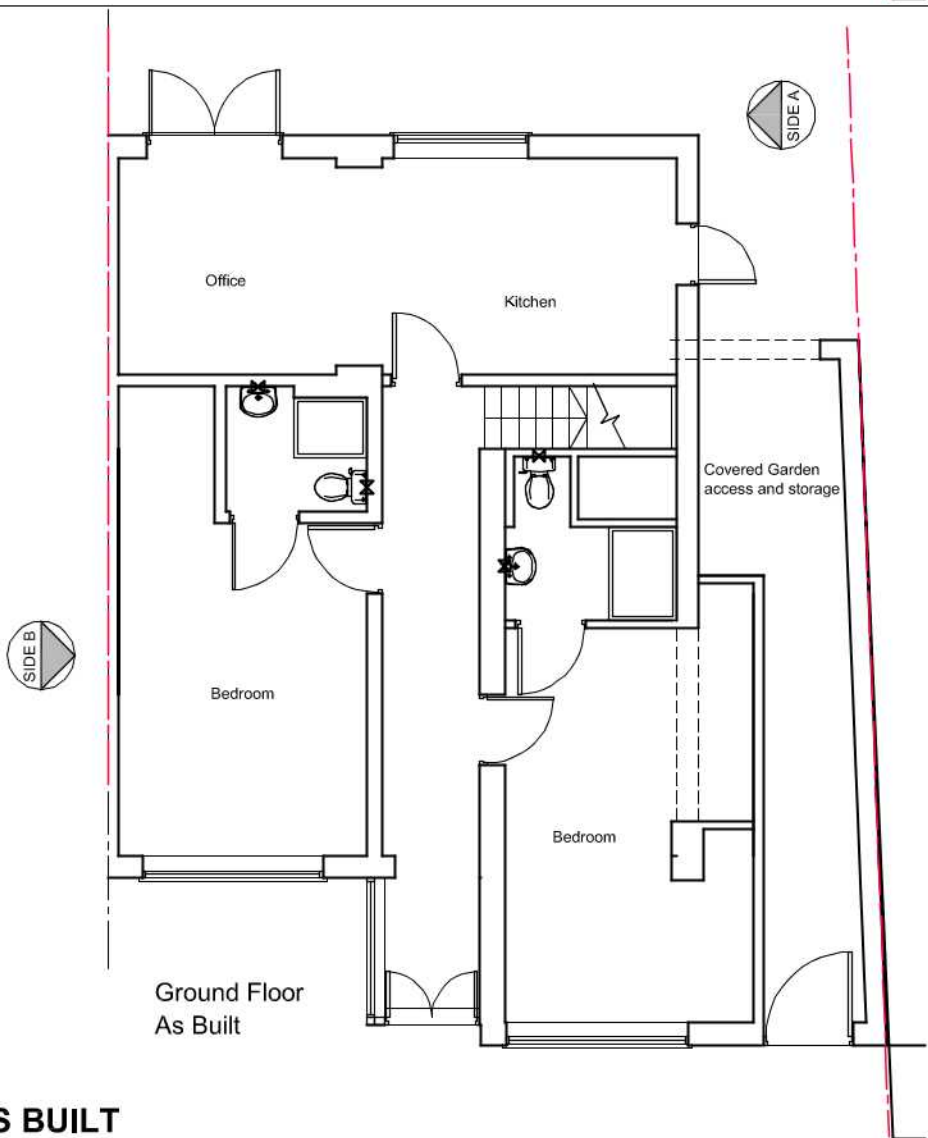

As Built Rear View

AS BUILT

PROPOSALS

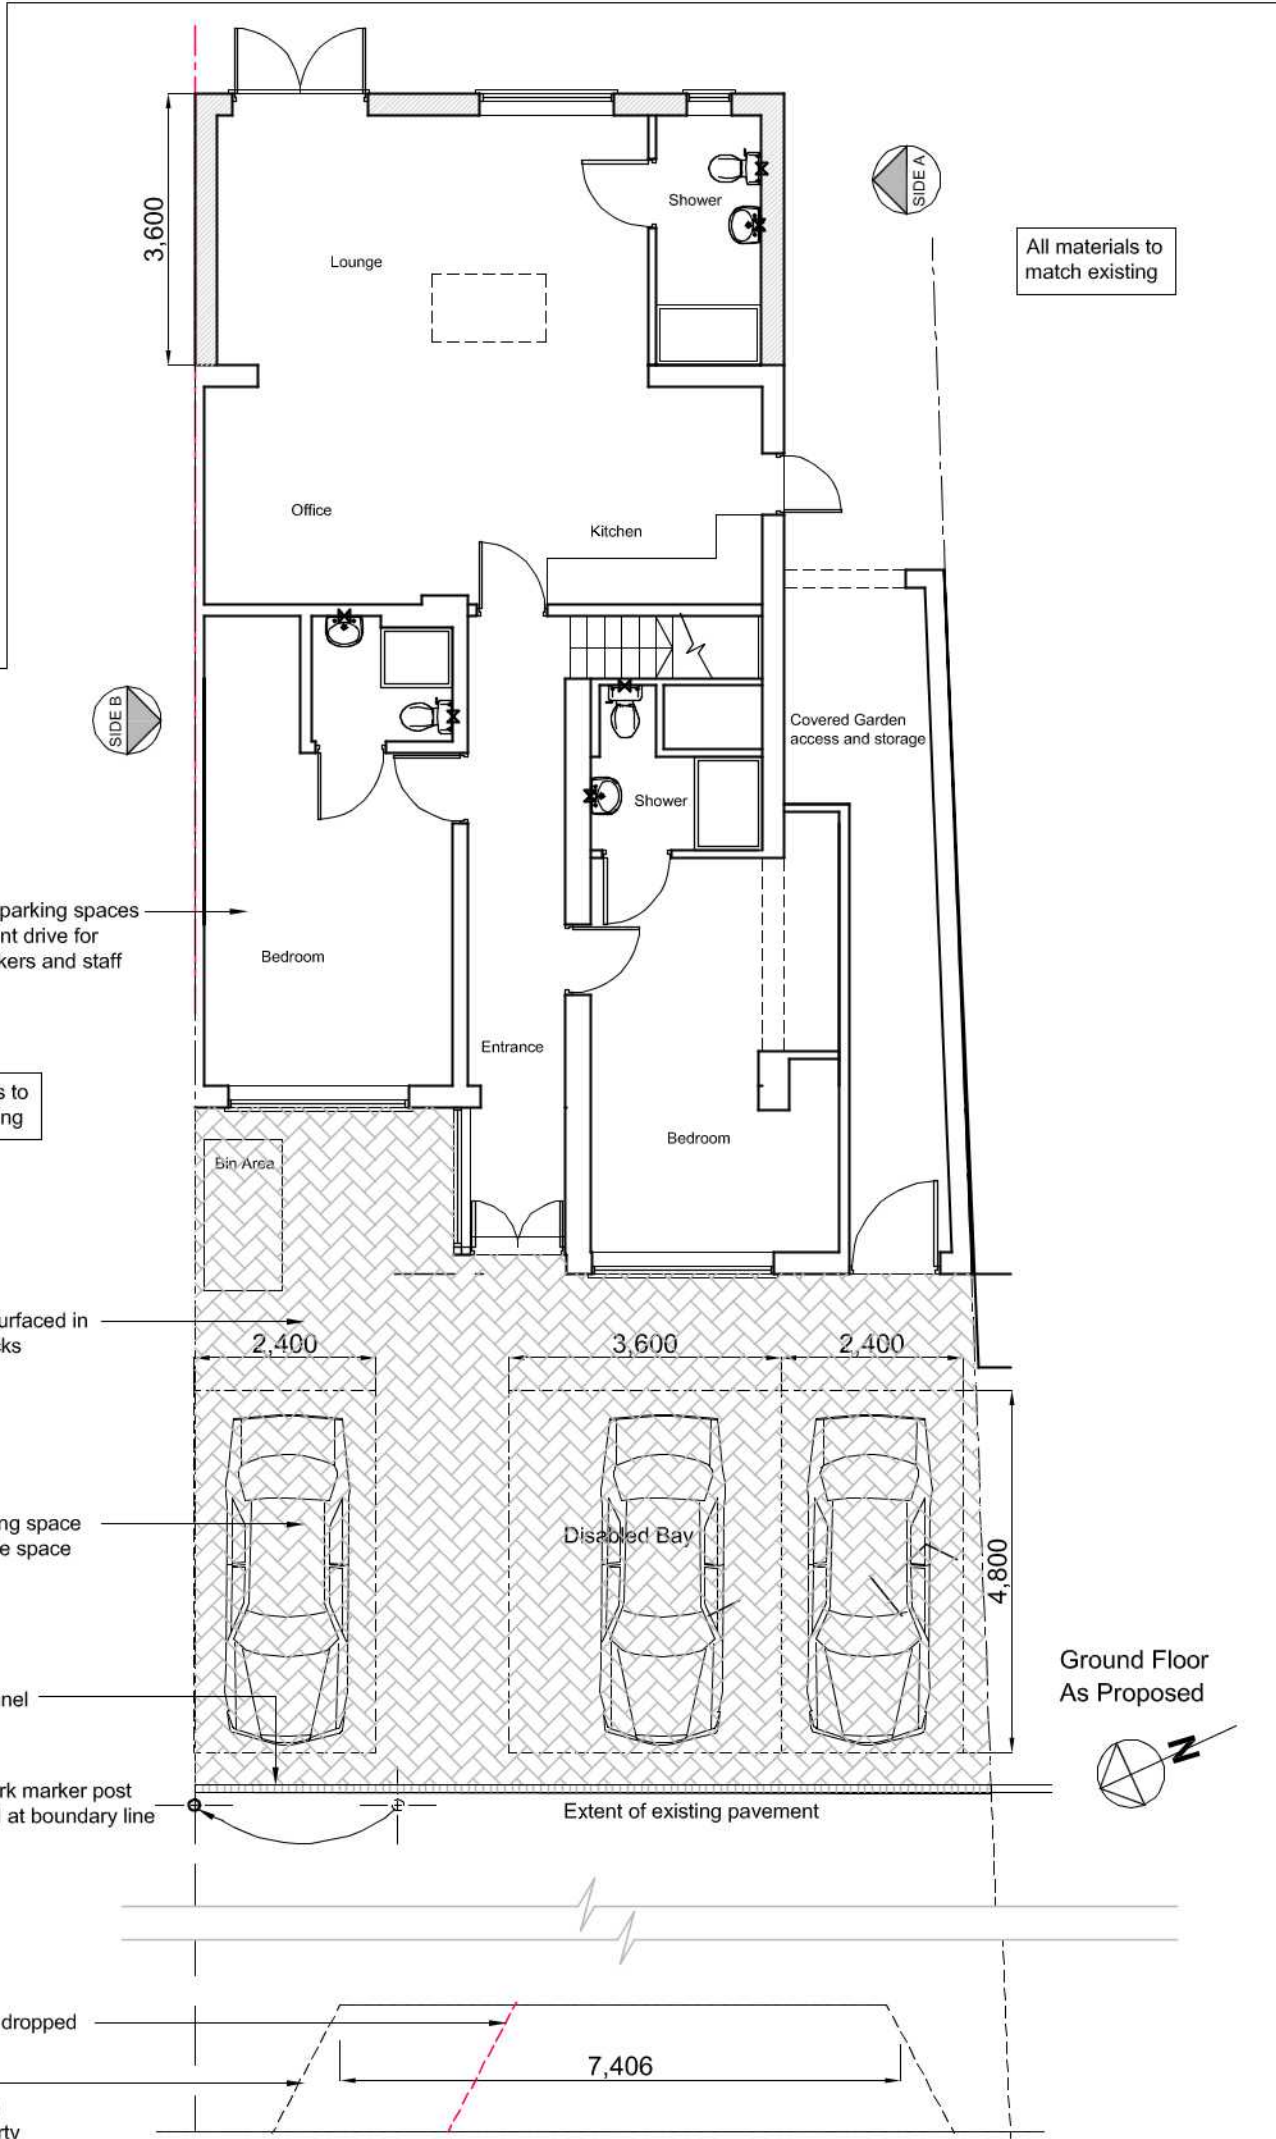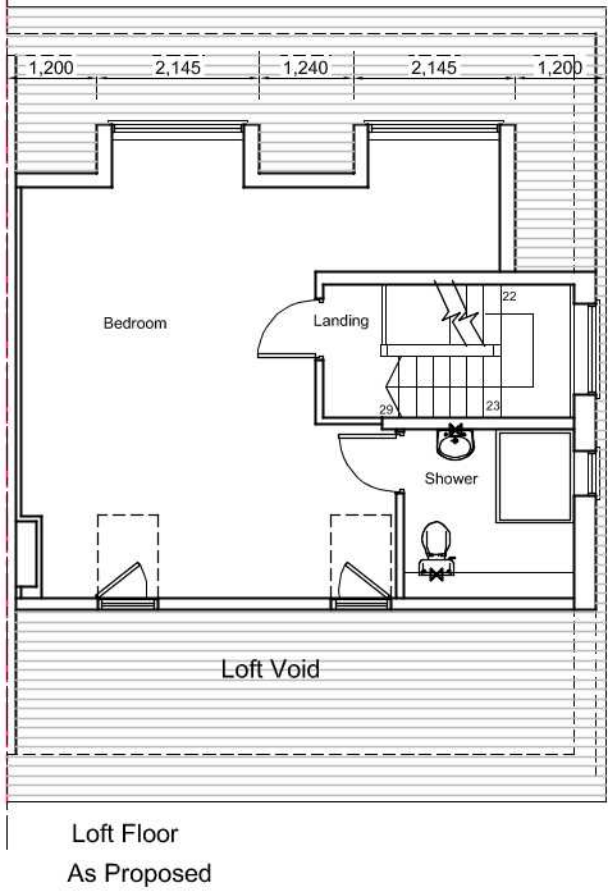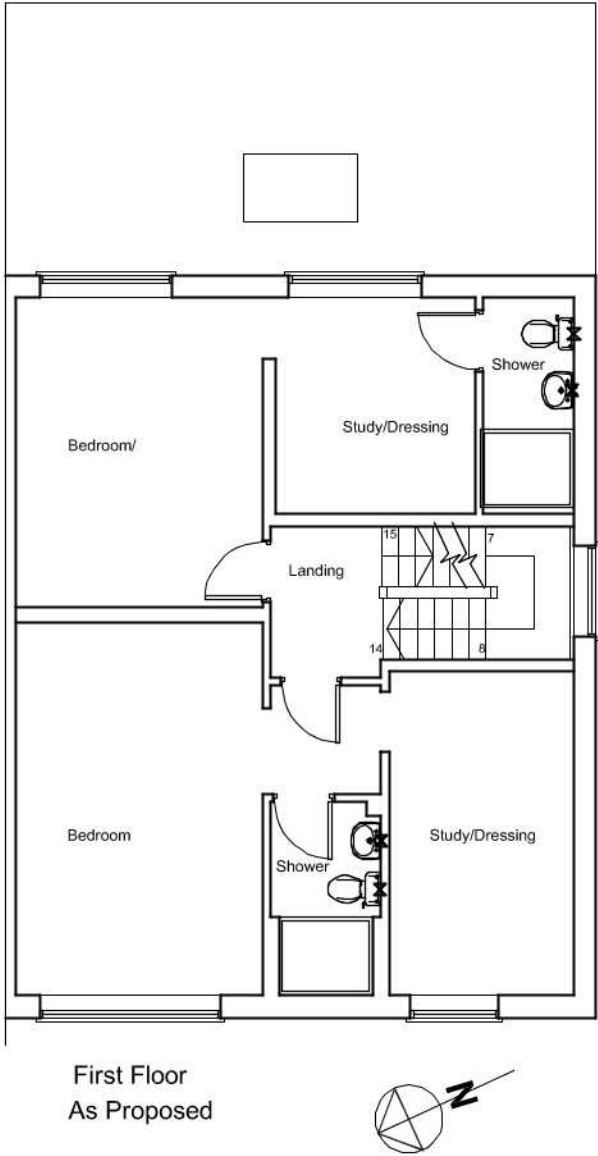

Rev B- 09-11-2020 Dormer & rear extension reduced.
Kitchen and kerb extension relocated. Car park reduced

Copyright © R.P. Designs.
This drawing which is the property of R.P. Designs
is the subject of Intellectual Property Rights including
copyright and design right and shall not be reproduced,
copied, loaned, or submitted to any other party without the
written consent of R.P. Designs.
This drawing is not to be scaled. Only figured dimensions
to be taken. Any discrepancies to be reported to R.P. Designs
prior to setting out or ordering any materials.

R P Designs
7 Elmhurst Close Bushey WD23 2QB
Tel: 07946 206924

Client
Mr S Ahluwalia

Sheet Title
**As Existing, As Built &
As Proposed Plans**

Scale 1:100 @ A2 Drawn: RP Date: Jul 2020

Project Title
**180 Church Road
Hayes, UB3 2LS**

Dwg No.
PL/180CR/03

Revisions
C