



1 GROUND
Scale 1:100

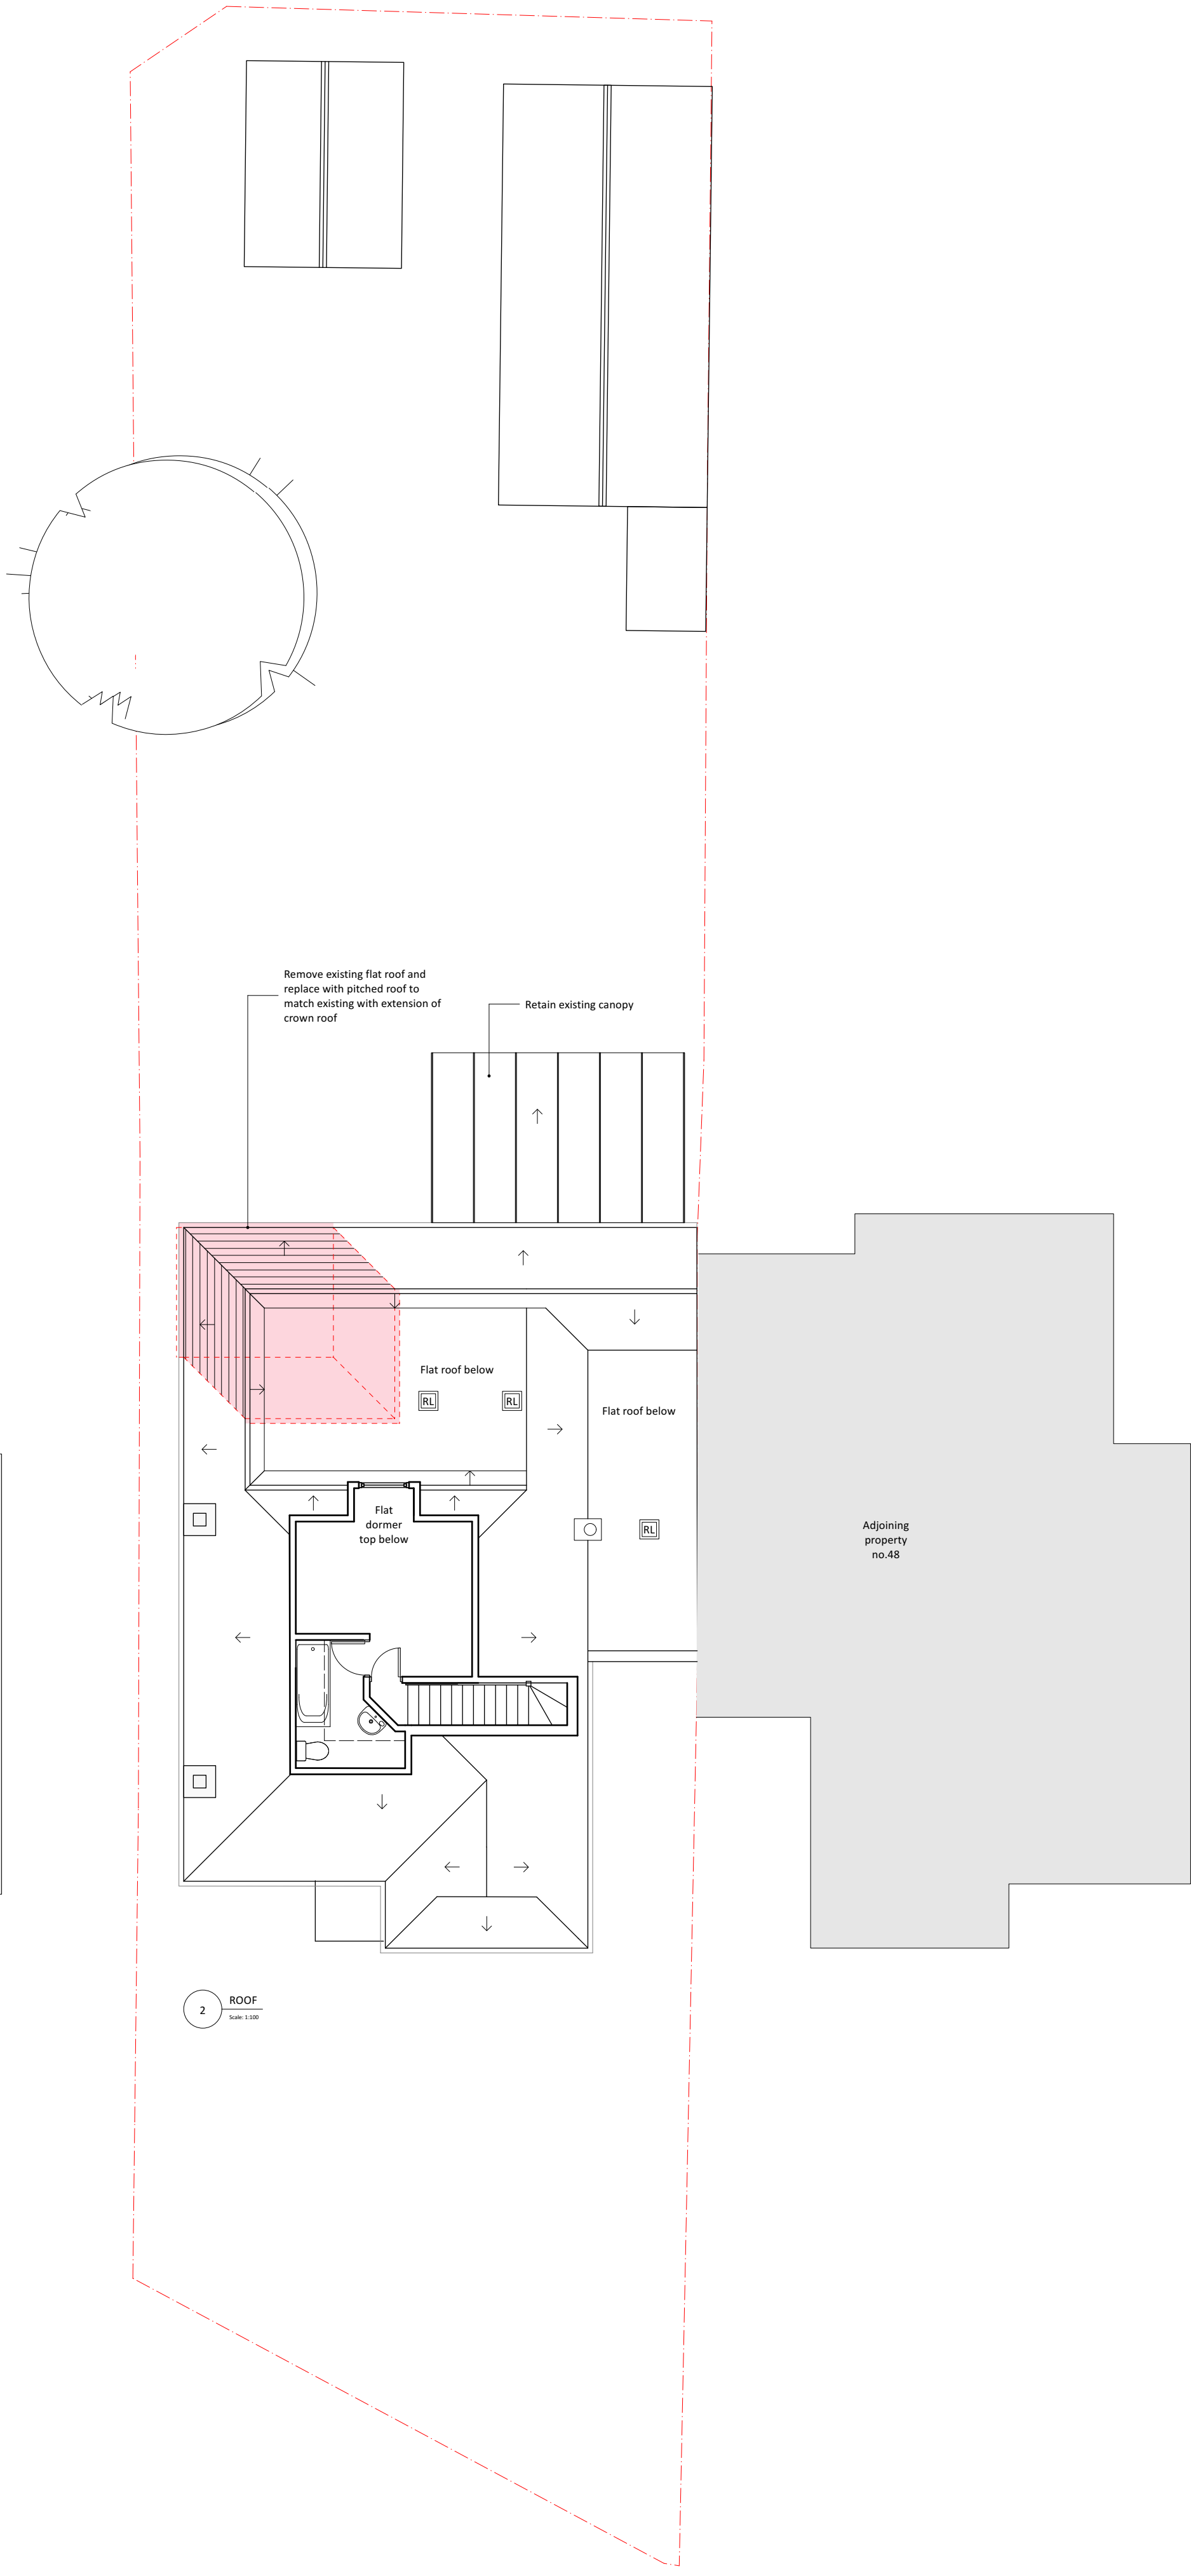

2 ROOF
Scale 1:100

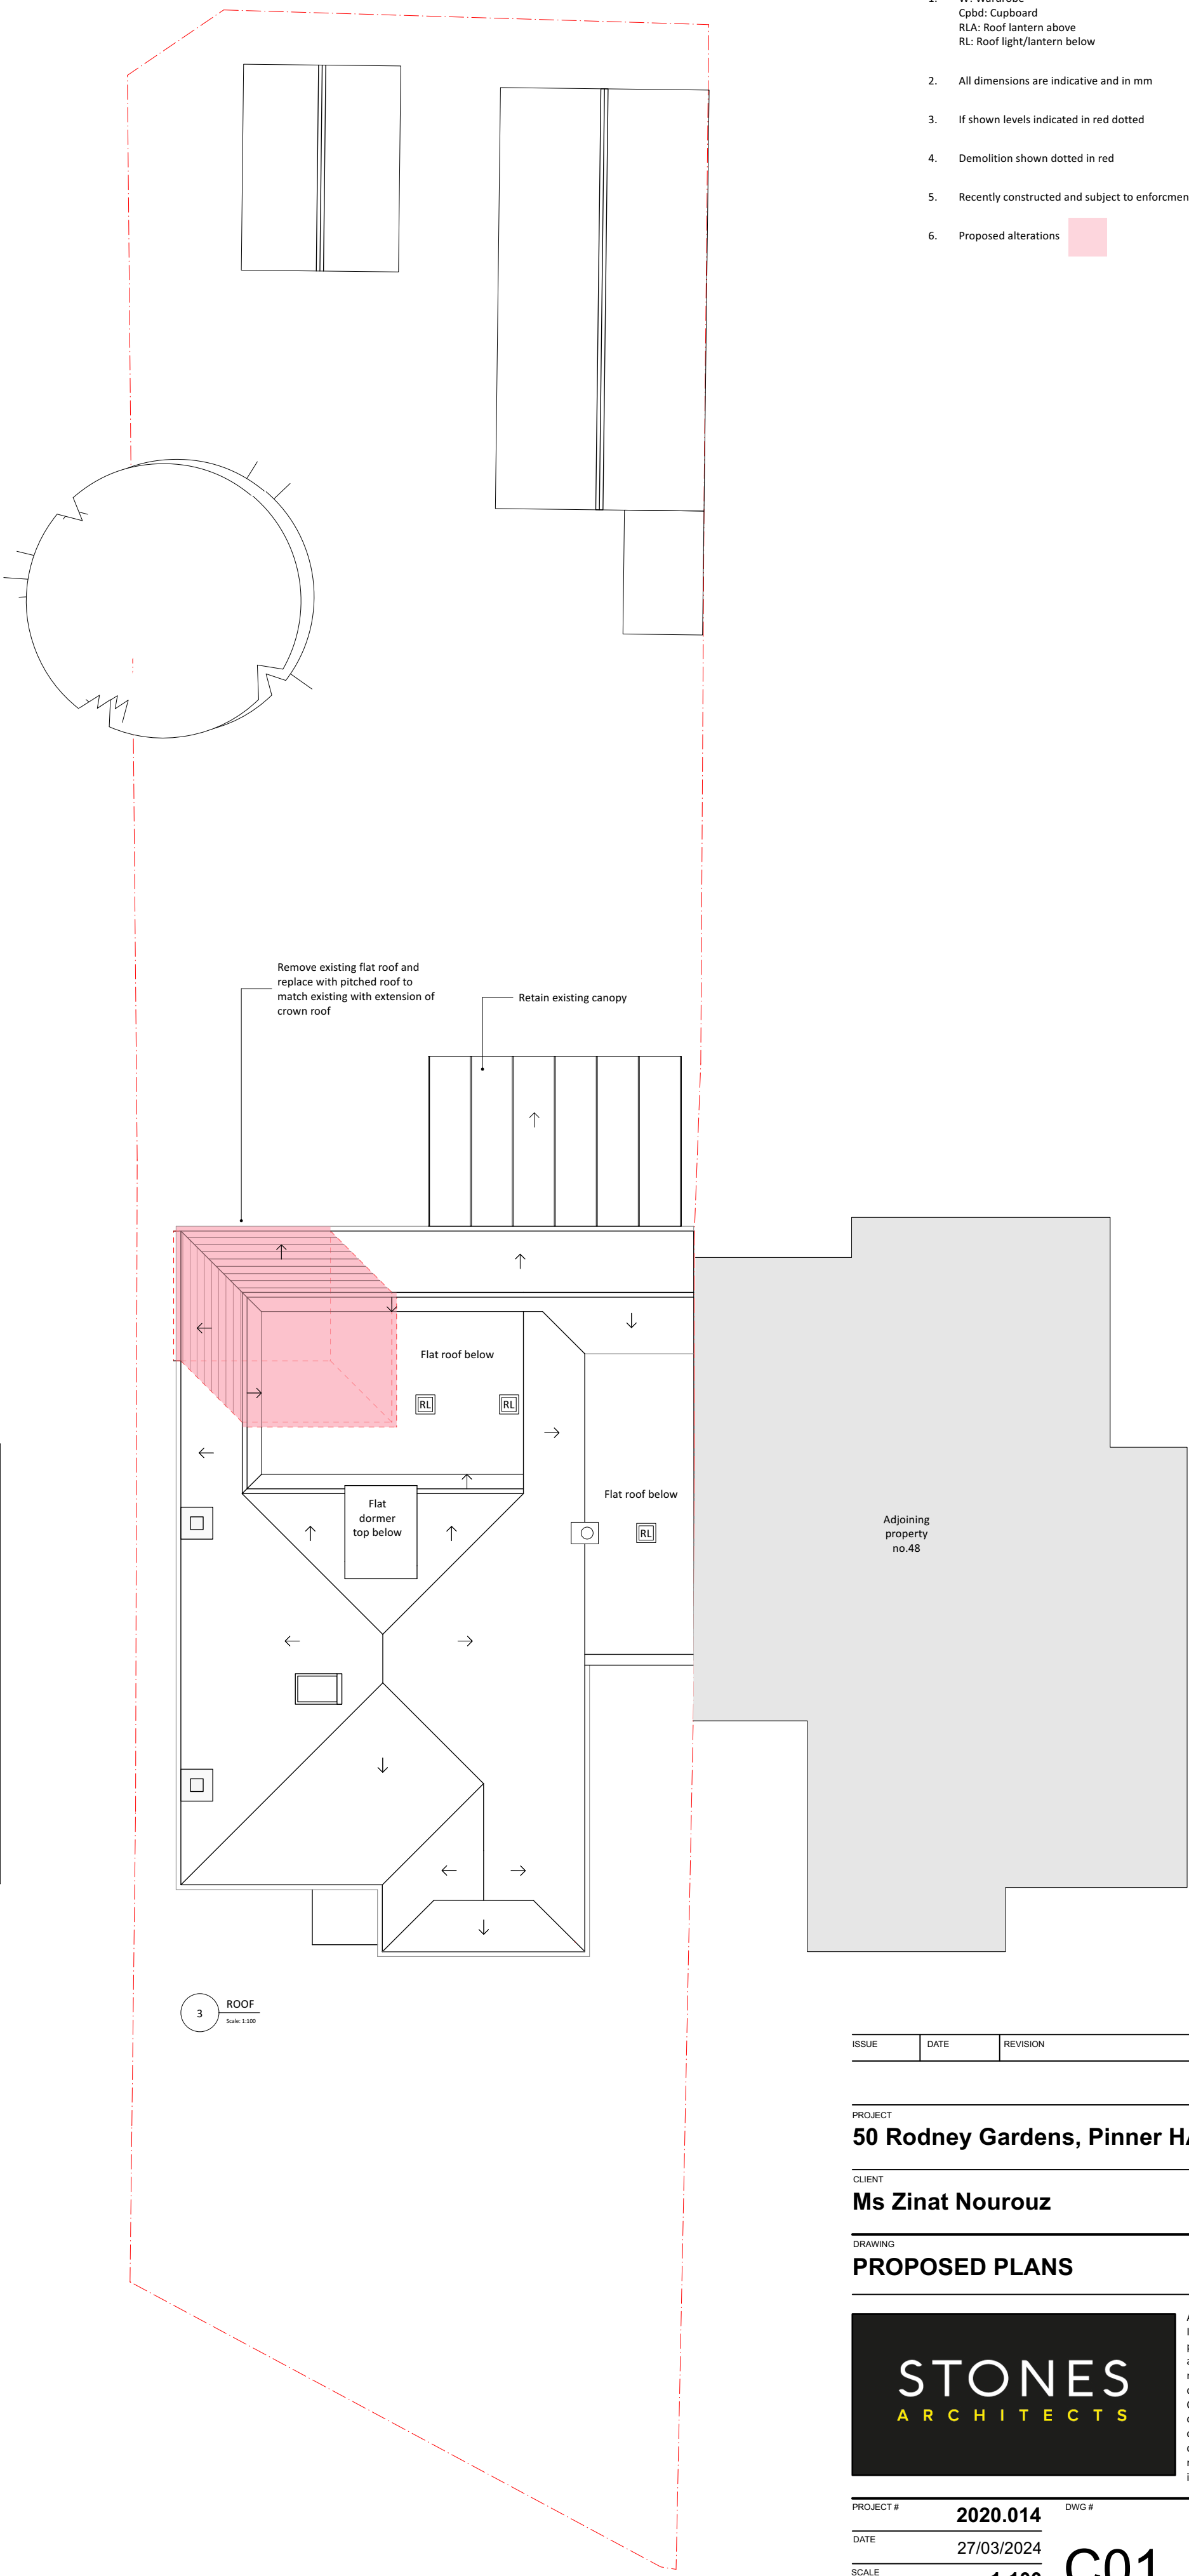

3 ROOF
Scale 1:100

General Notes

1. W: Wardrobe
Cblb: Cupboard
RLA: Roof lantern above
RL: Roof light/lantern below
2. All dimensions are indicative and in mm
3. If shown levels indicated in red dotted
4. Demolition shown dotted in red
5. Recently constructed and subject to enforcement ref: ENF/390/23
6. Proposed alterations

| ISSUE | DATE | REVISION |
|-------|------|----------|
|-------|------|----------|

PROJECT
50 Rodney Gardens, Pinner HA5 2RP

CLIENT
Ms Zinat Nourouz


DRAWING
PROPOSED PLANS



| | | | | | |
|-----------|-------------------|-------|----|-----|--|
| PROJECT # | 2020.014 | DWG # | | REV | |
| DATE | 27/03/2024 | | | | |
| SCALE | 1:100 | | | | |
| DRAWN | JC | CHKD | JC | | |

Stones Architects Ltd
50 Goldharbour Lane Hayes Middlesex UB3 3EP
t 020 8969 0000 e mail@stonesarchitects.co.uk w stonesarchitects.co.uk

0.0 1.0 2.0 3.0 4.0 5.0 M

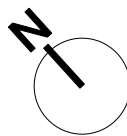

C01