



Scale: 100 0 1m 2 3 4 5 6 7 8 9 10m
Scale: 50 0 1m 2 3 4 5m



As Built Ground Floor
1 : 100

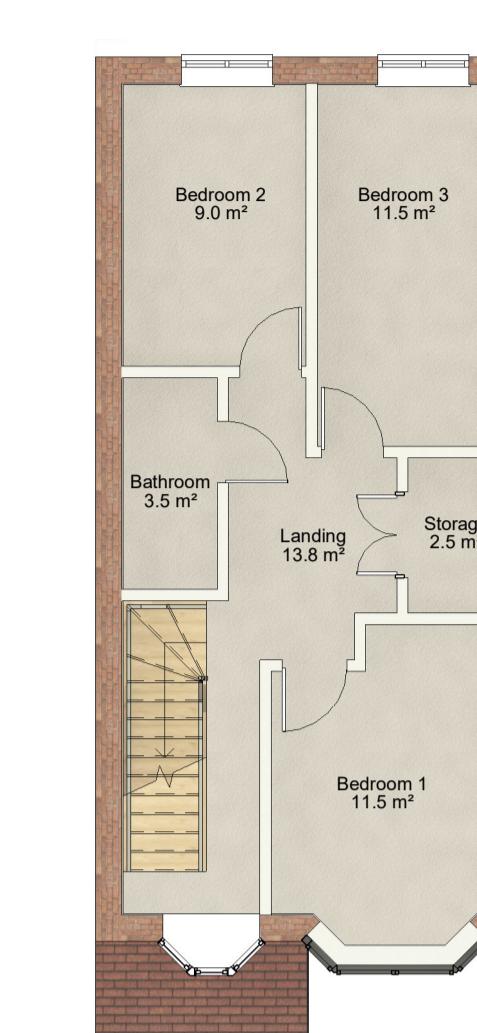


As Built First Floor
1 : 100

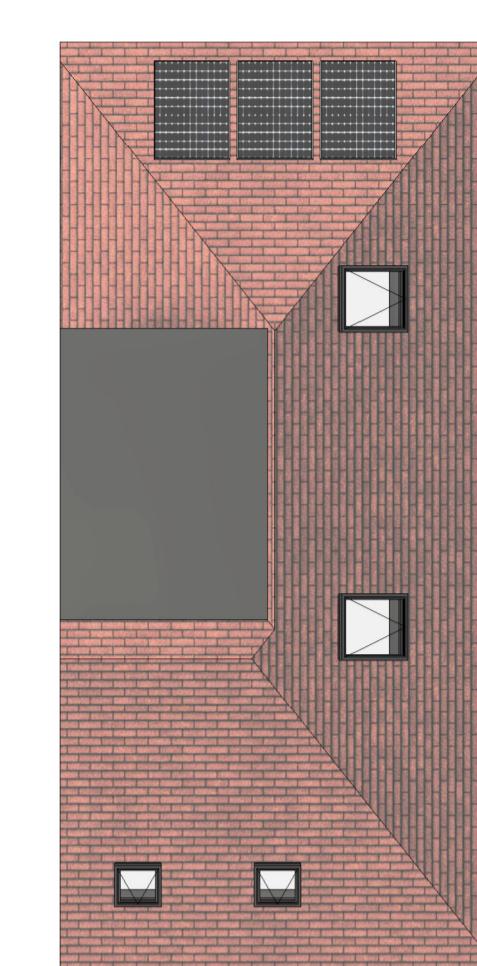


As Built Roof Plan
1 : 100

Ground Floor	
Living	10.0 m ²
Hall	10.0 m ²
WC	3.9 m ²
Utility	8.3 m ²
Kitchen	8.2 m ²
Sitting Room	14.2 m ²
Ground Floor: 6	54.5 m ²
First Floor	
Bedroom 1	11.5 m ²
Landing	13.8 m ²
Bathroom	3.5 m ²
Bedroom 2	9.0 m ²
Bedroom 3	11.5 m ²
Storage	2.5 m ²
First Floor: 6	51.8 m ²
Grand total: 12	106.3 m ²

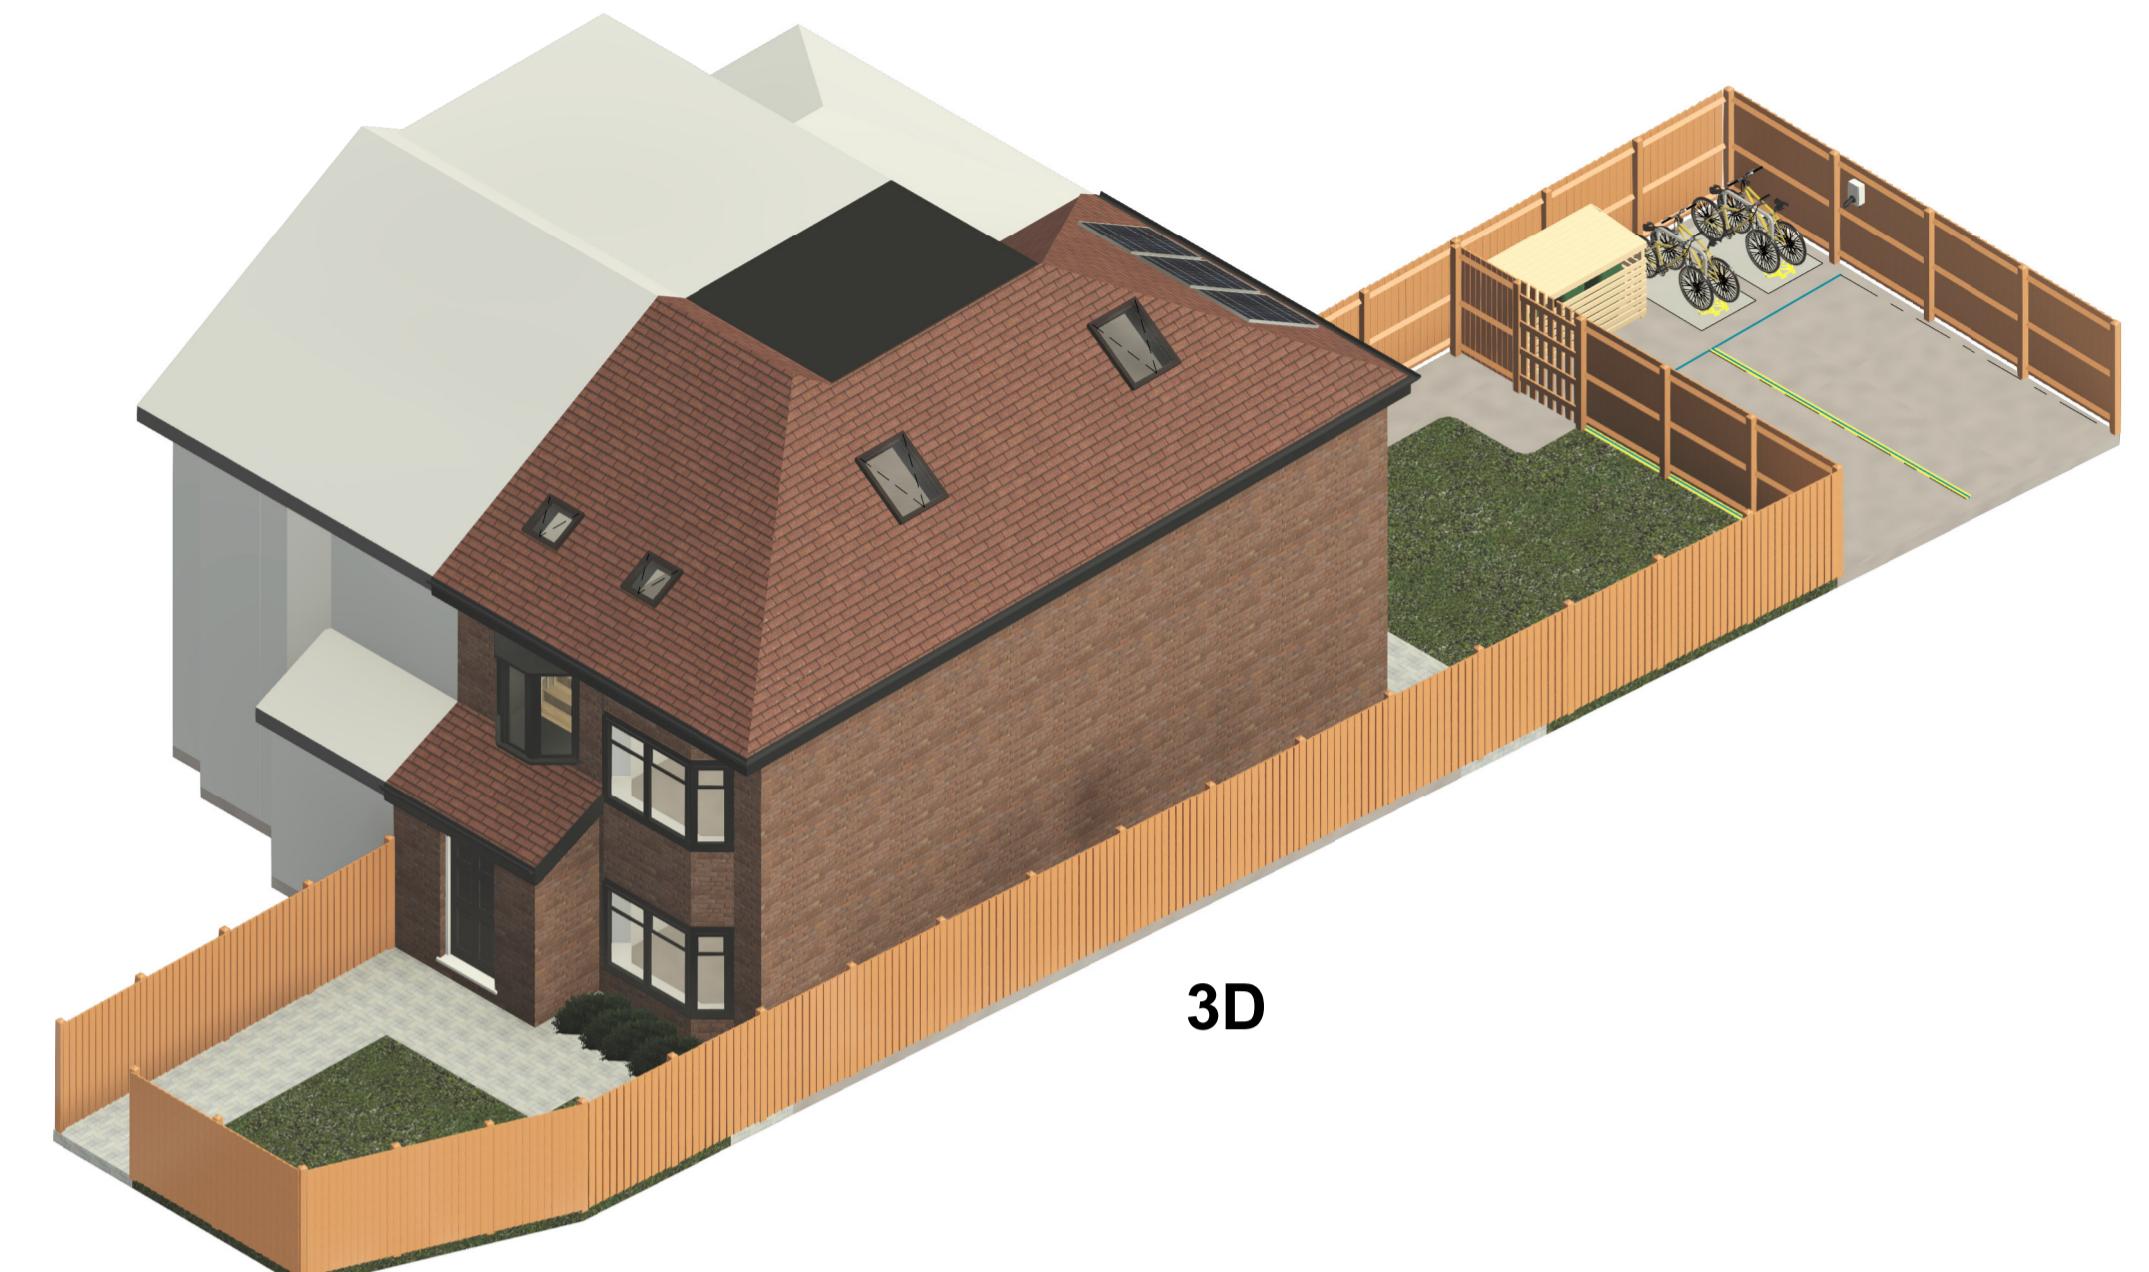

3D

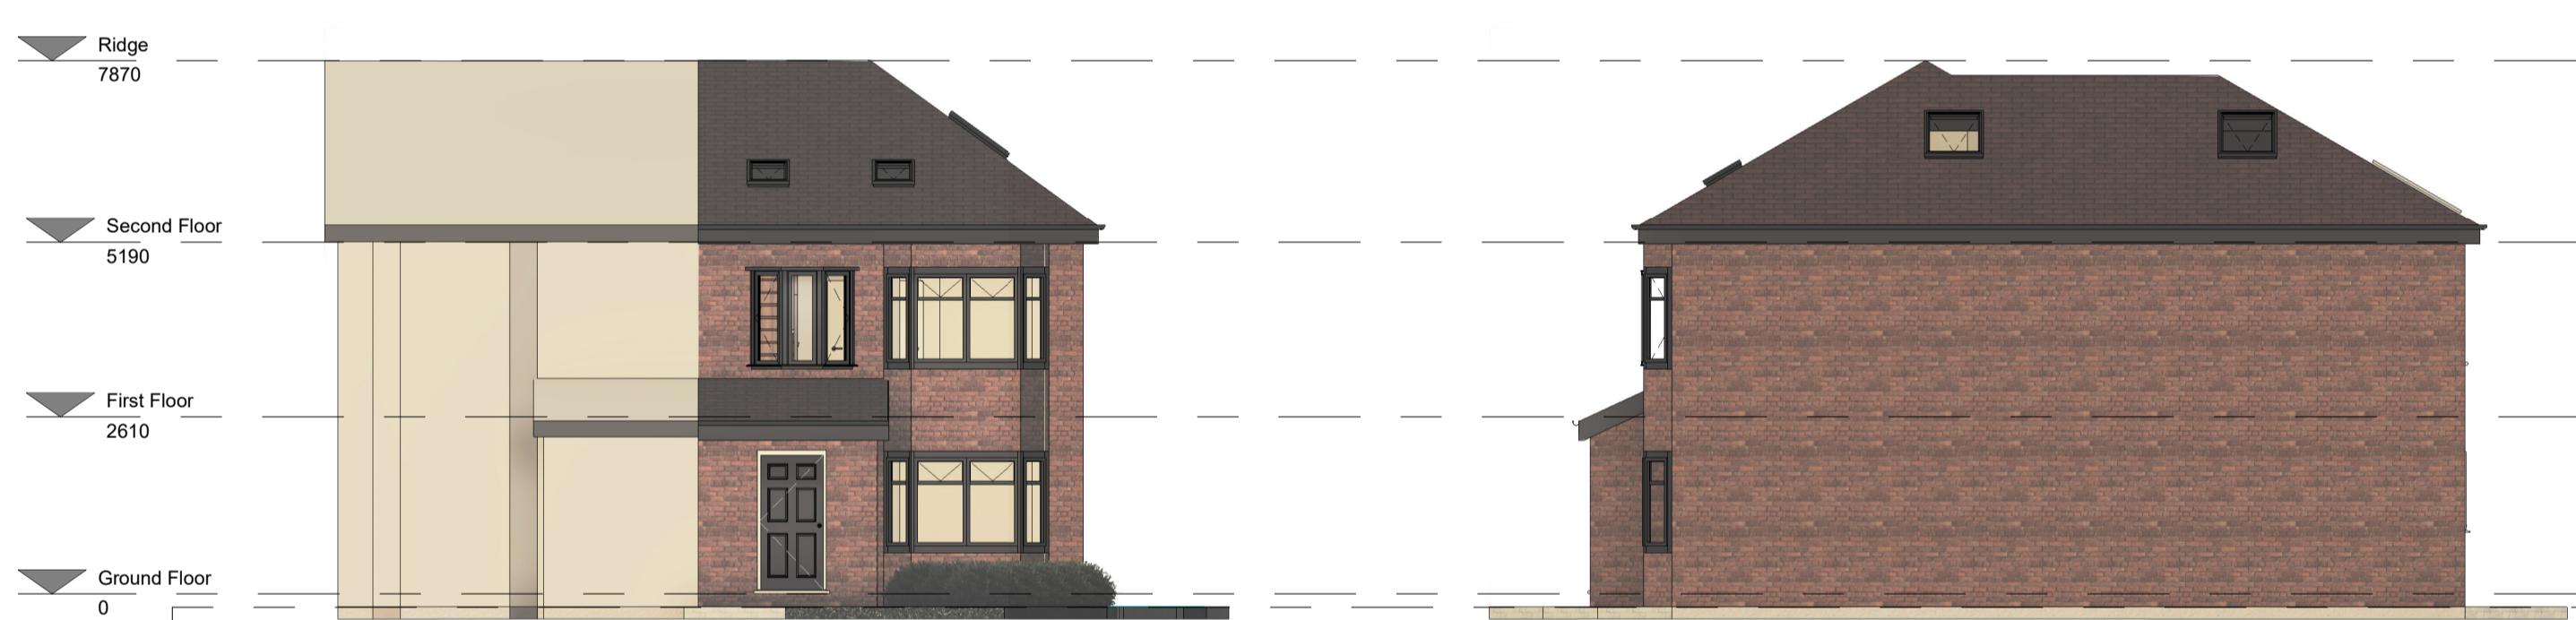

As Built Front Elevation
1 : 100



As Built Right Side Elevation
1 : 100



As Built Rear Elevation
1 : 100


Scale: 500 0 5m 10 15 20 25 30 35 40 45 50m




As Built Front Perspective



As Built Rear Perspective

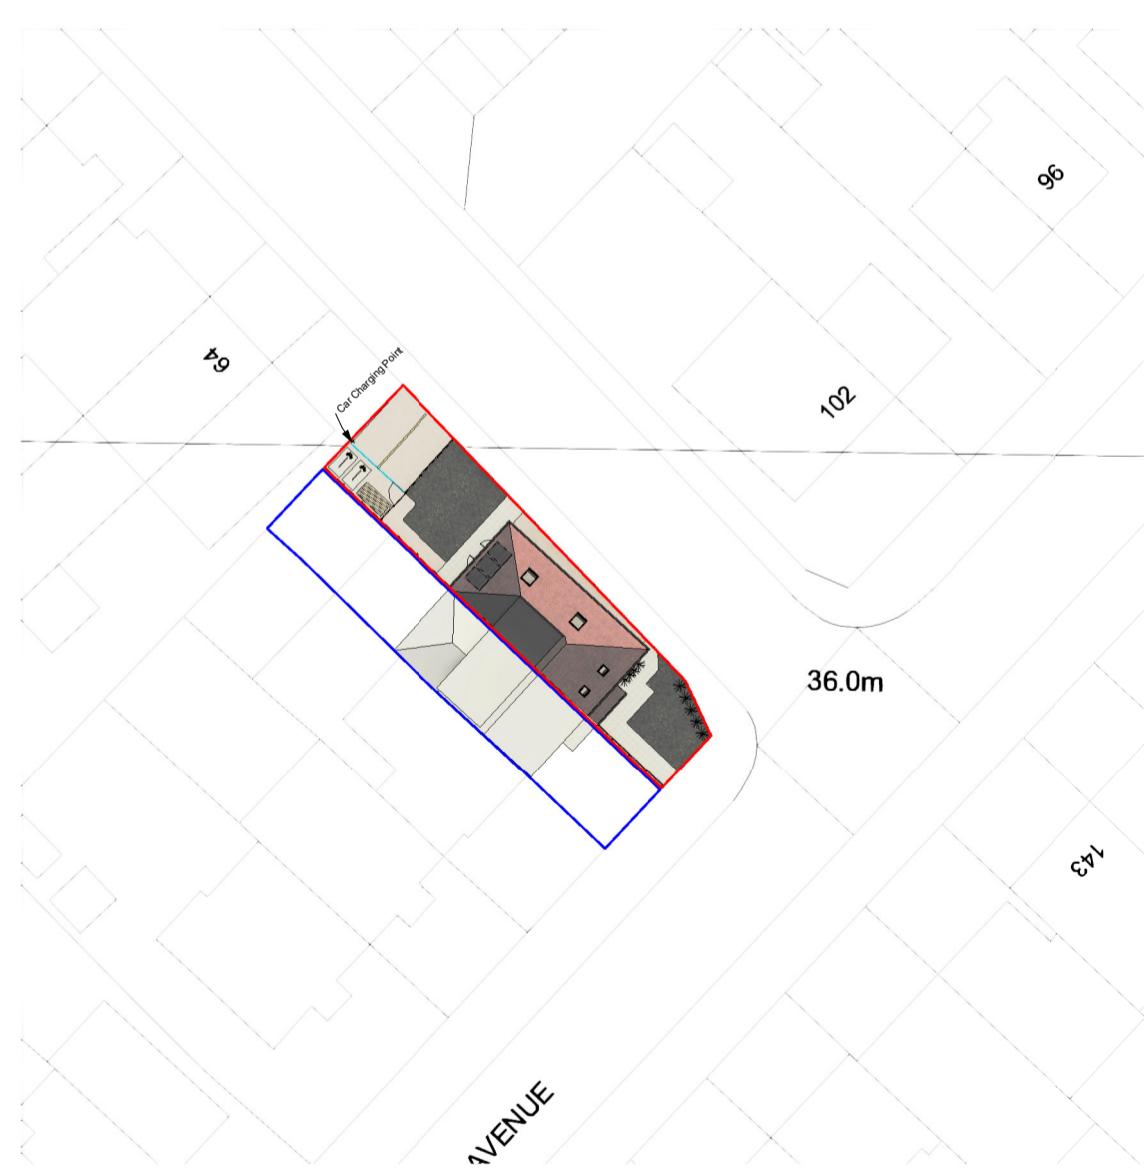

As Built Site Plan
1 : 500

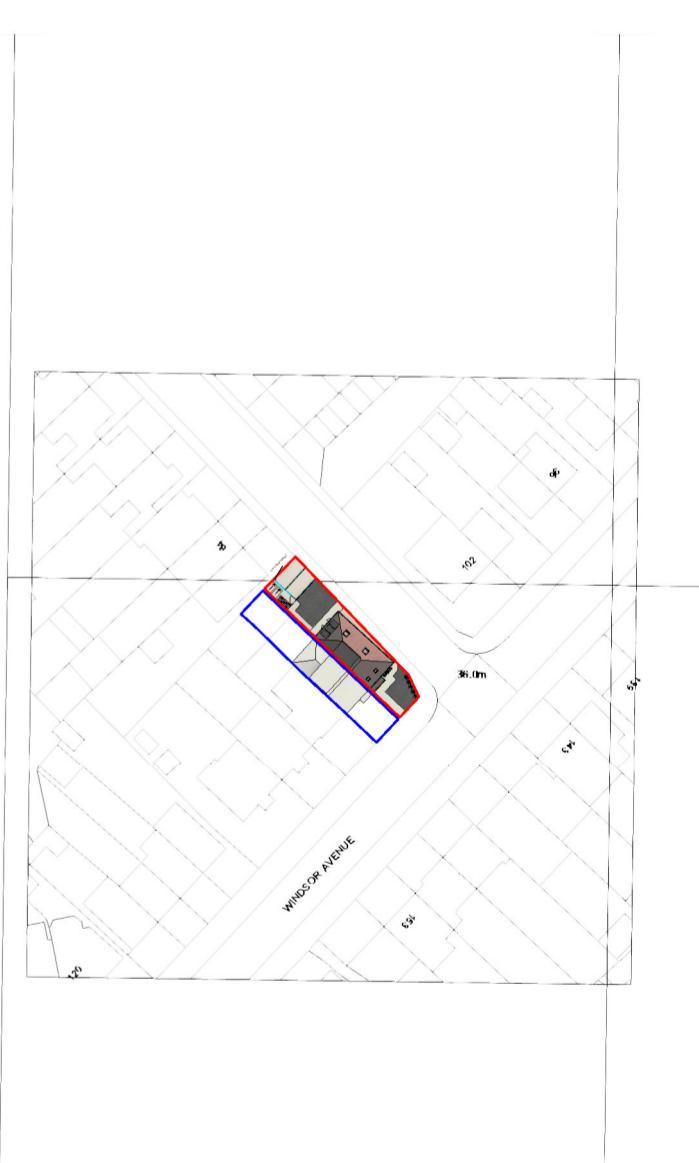

As Built Location Plan
1 : 1250

Scale: 1250 0 12.5m 25 50 75 100 125m

Scale: 200 0 2m 4 6 8 10 12 14 16 18 20m
Scale: 20 0 0.2 0.4 0.6 0.8 1m 1.2 1.4 1.6 1.8 2m