




PRE-EXISTING GROUND FLOOR PLAN

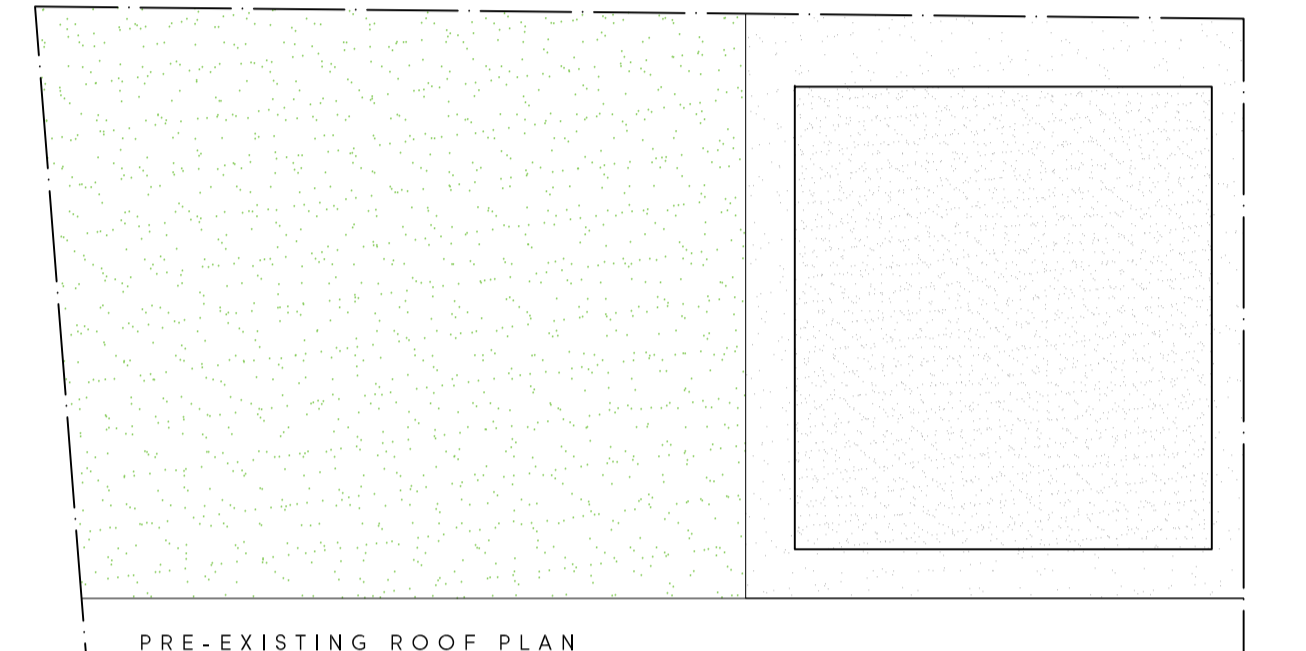

PRE-EXISTING ROOF PLAN

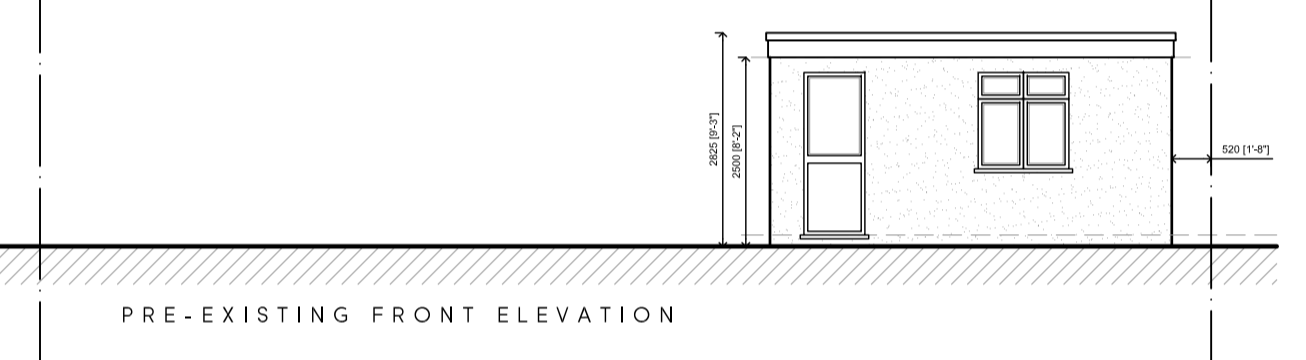

PRE-EXISTING FRONT ELEVATION


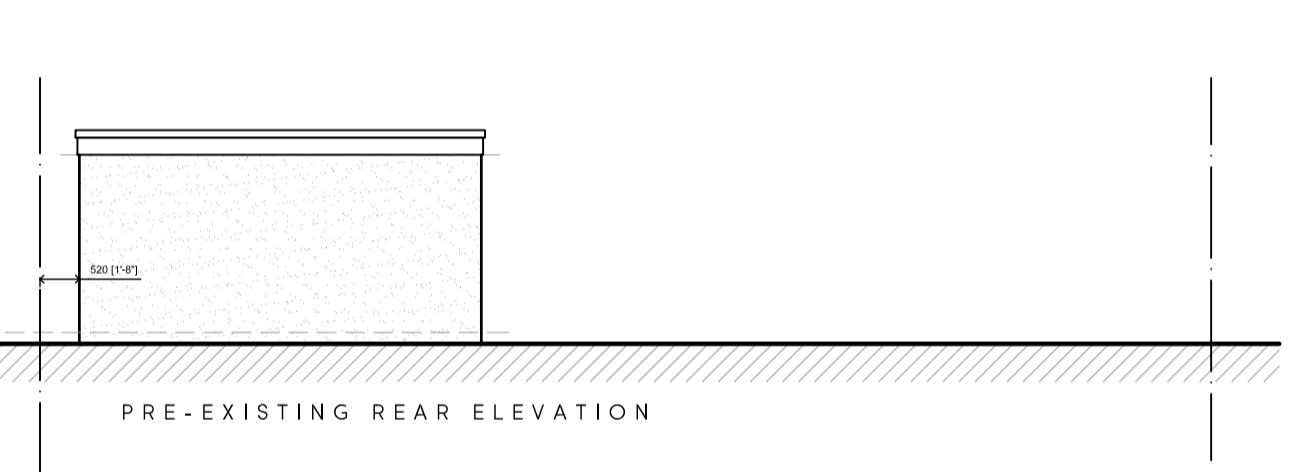


PRE-EXISTING REAR ELEVATION




PRE-EXISTING SIDE ELEVATION

PRE-EXISTING SIDE ELEVATION

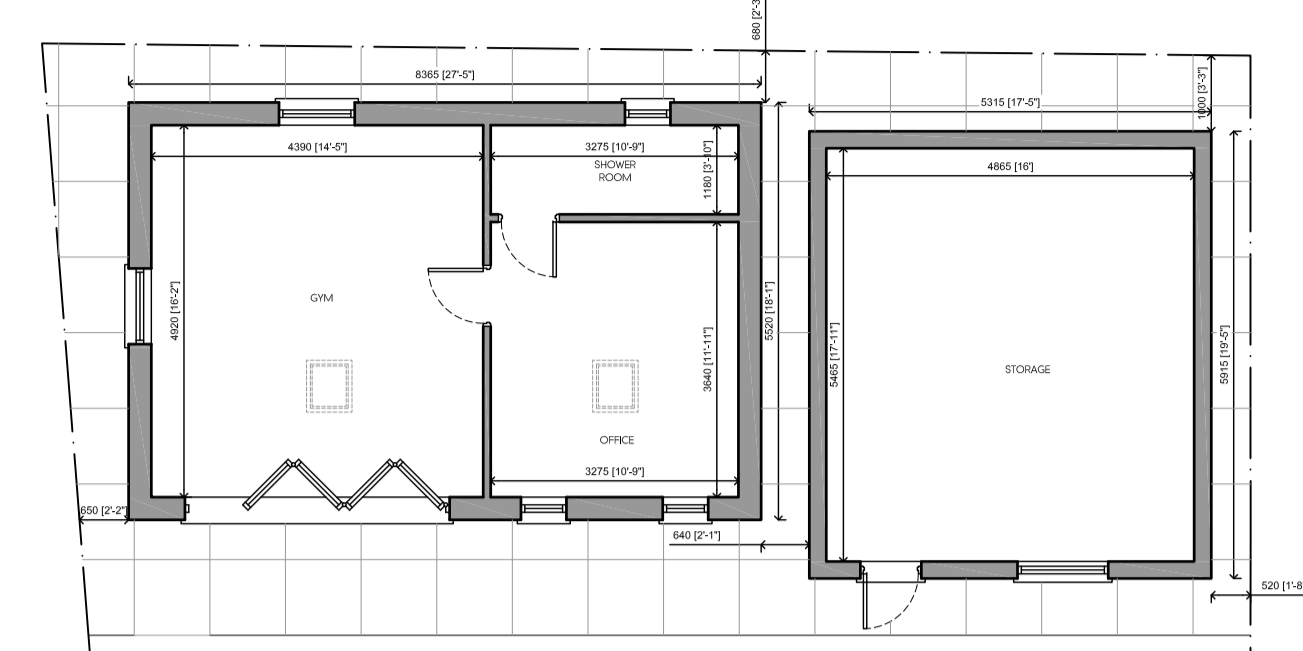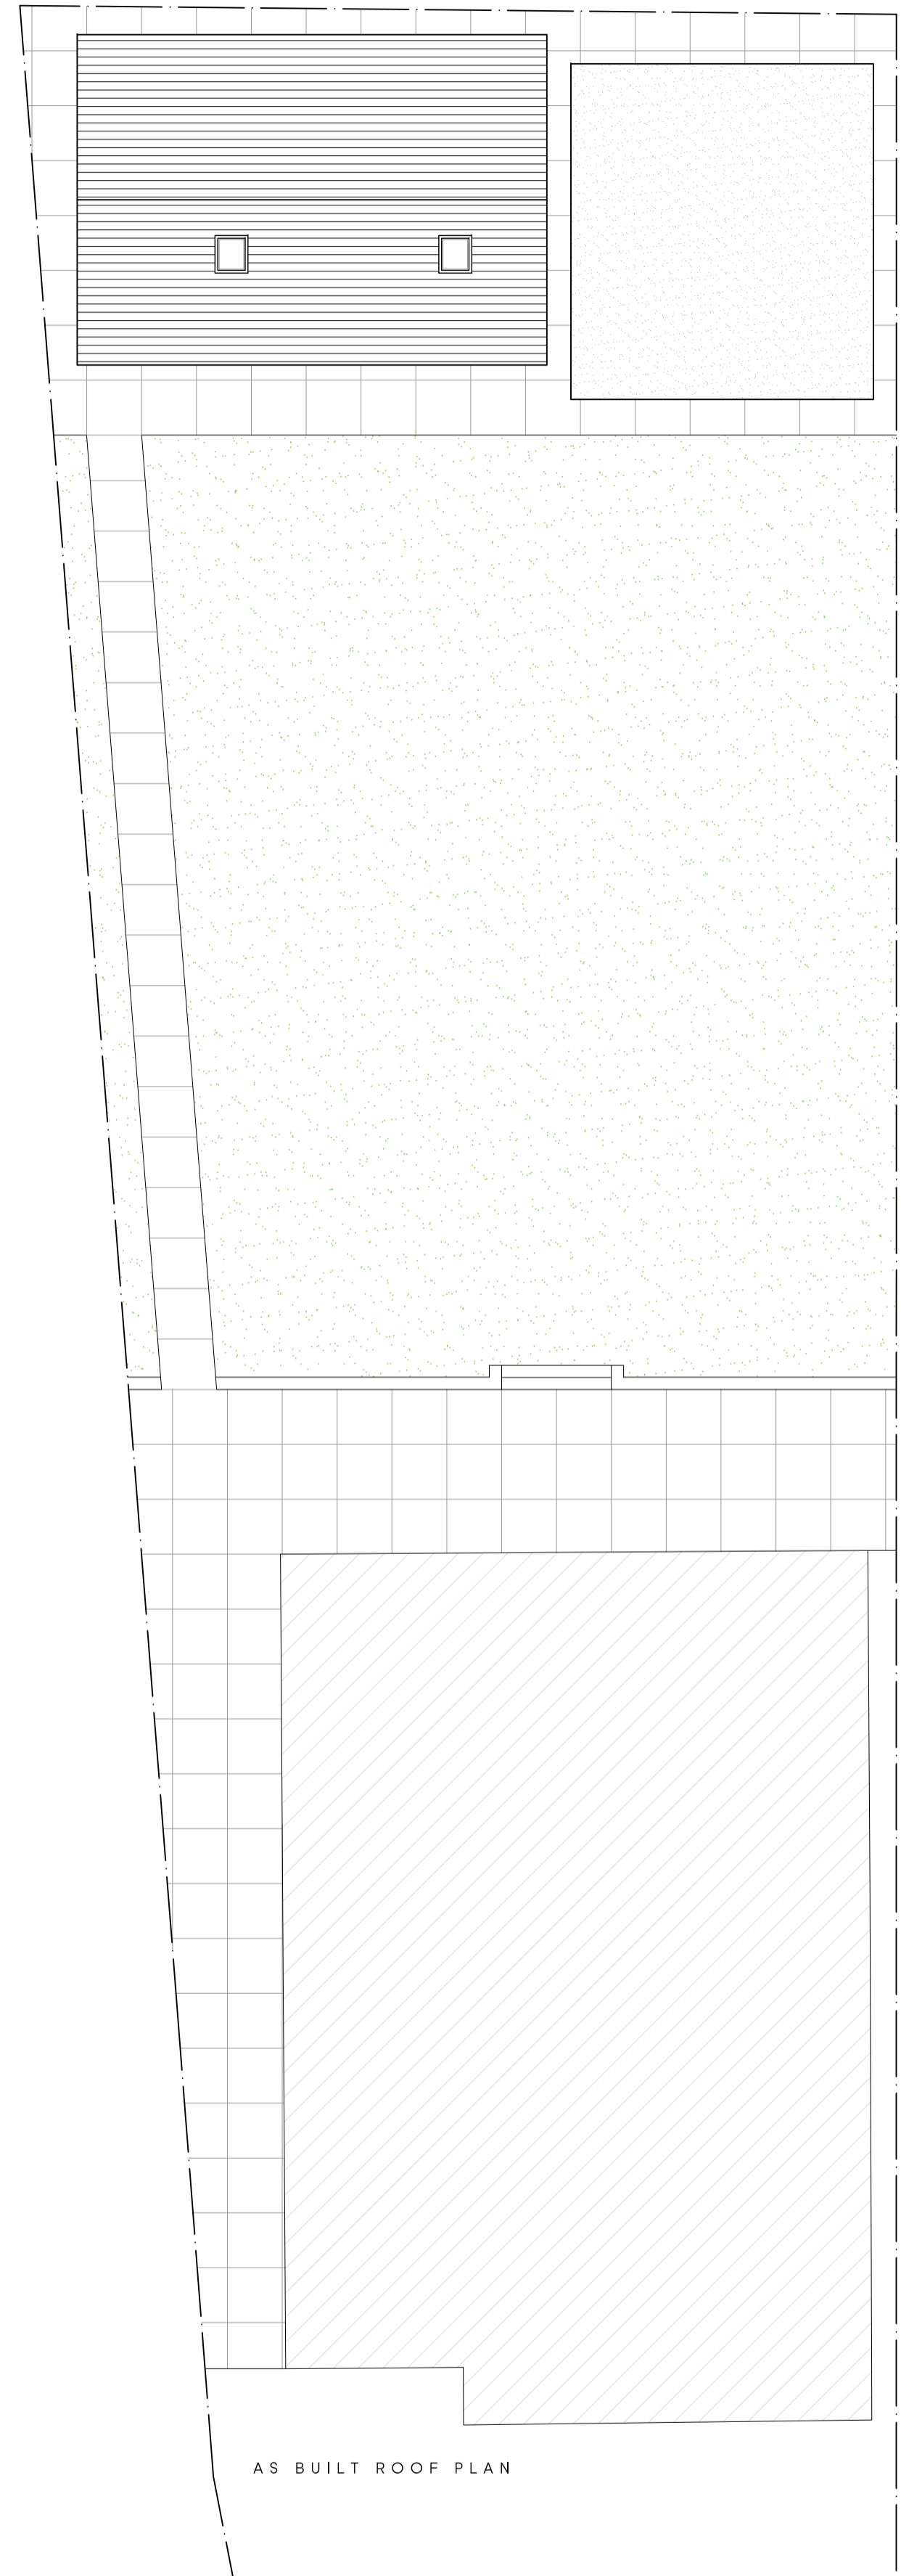


AS BUILT GROUND FLOOR PLAN

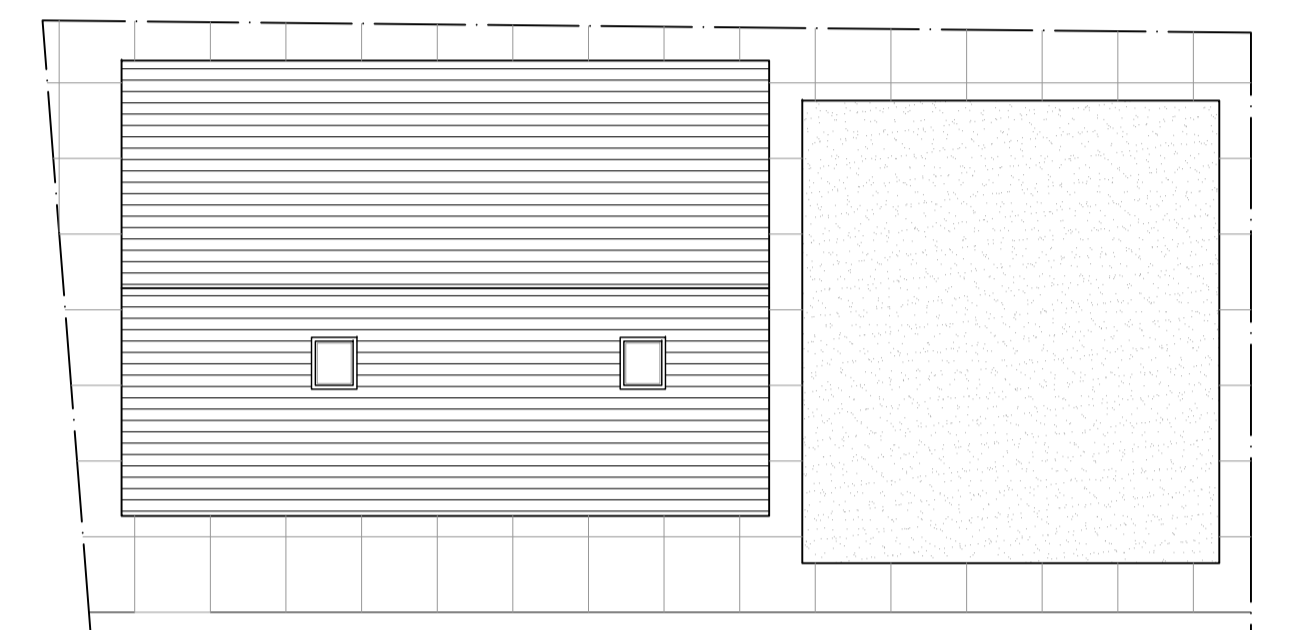


AS BUILT ROOF PLAN



AS BUILT FRONT ELEVATION

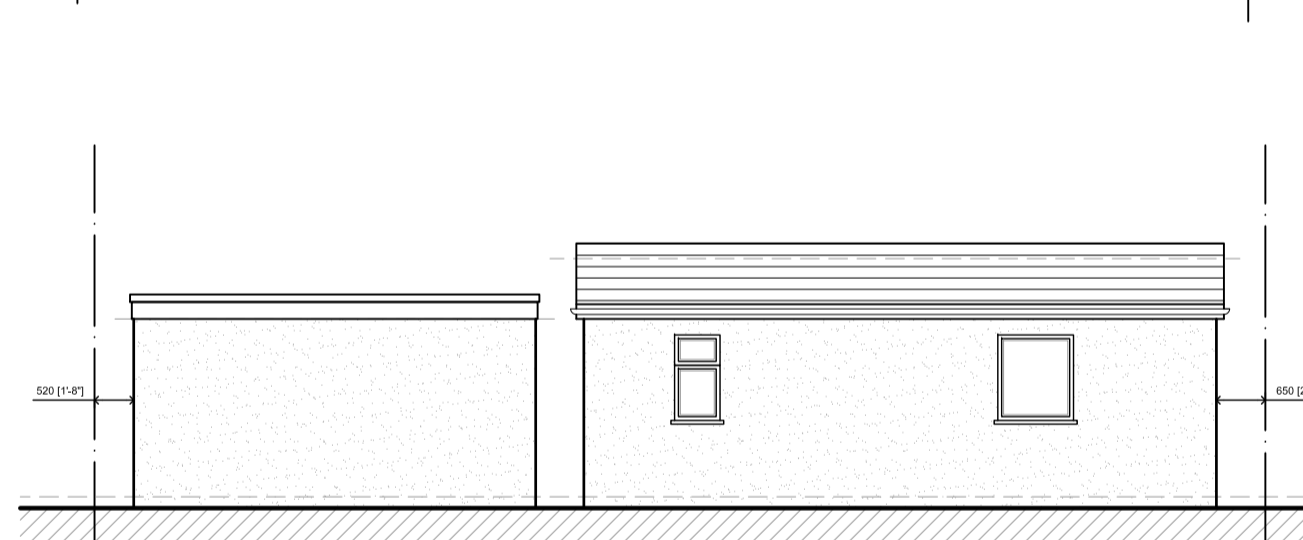

AS BUILT REAR ELEVATION

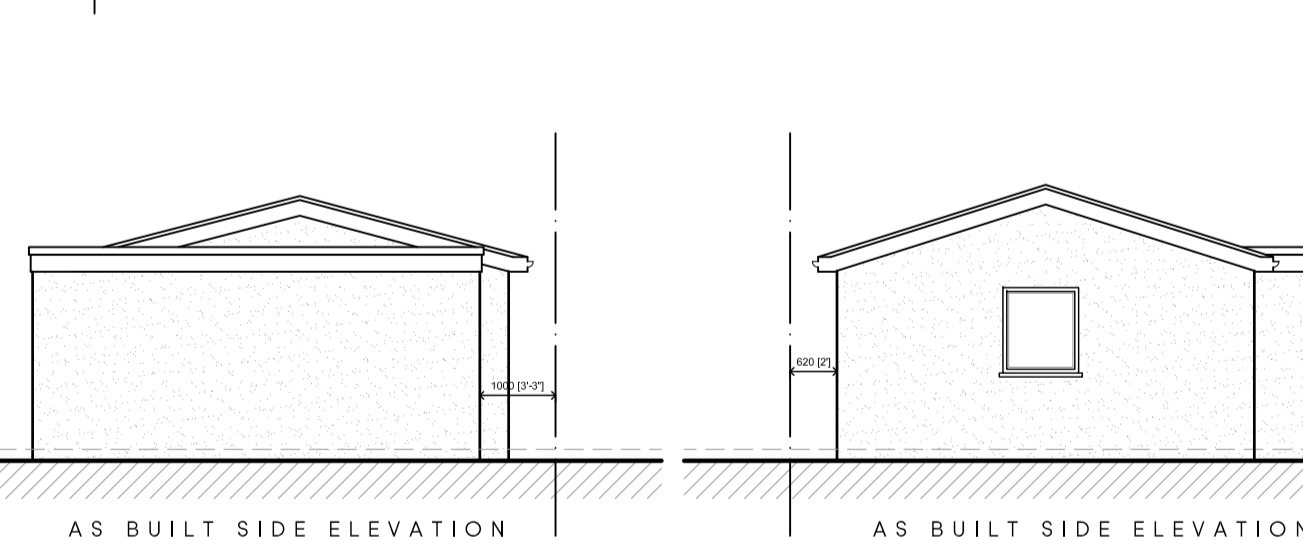

AS BUILT SIDE ELEVATION

AS BUILT SIDE ELEVATION



LOCATION PLAN
SCALE 1:1250



SCALE 1:1250

Rev	Date	Description	Init.
-	-	-	-

Client
MR KHOSA

Project Title
PROPOSED EXTENSIONS AND ALTERATIONS
55 THE GREENWAY, ICKENHAM, UB10 8LU
Drawing Title

Cad File	Sheet Size	Scale
P001	A1	1:100
Drawn by	Drawing Date	Approved by
KP	FEB 2026	BR
Project No.	Drawing No.	Revision
2022	P201	-



20 The Avenue,
Hatch End, Pinner,
Middlesex HA5 4EP
01923840077
info@brarchitects.co.uk
www.brarchitects.co.uk

This drawing is property of BR Architects Ltd © and must not be copied or otherwise reproduced. All dimensions must be checked on site before commencing work. No dimensions to be scaled from this drawing. This drawing was produced using AutoCad 2025.

PLANNING ISSUE