
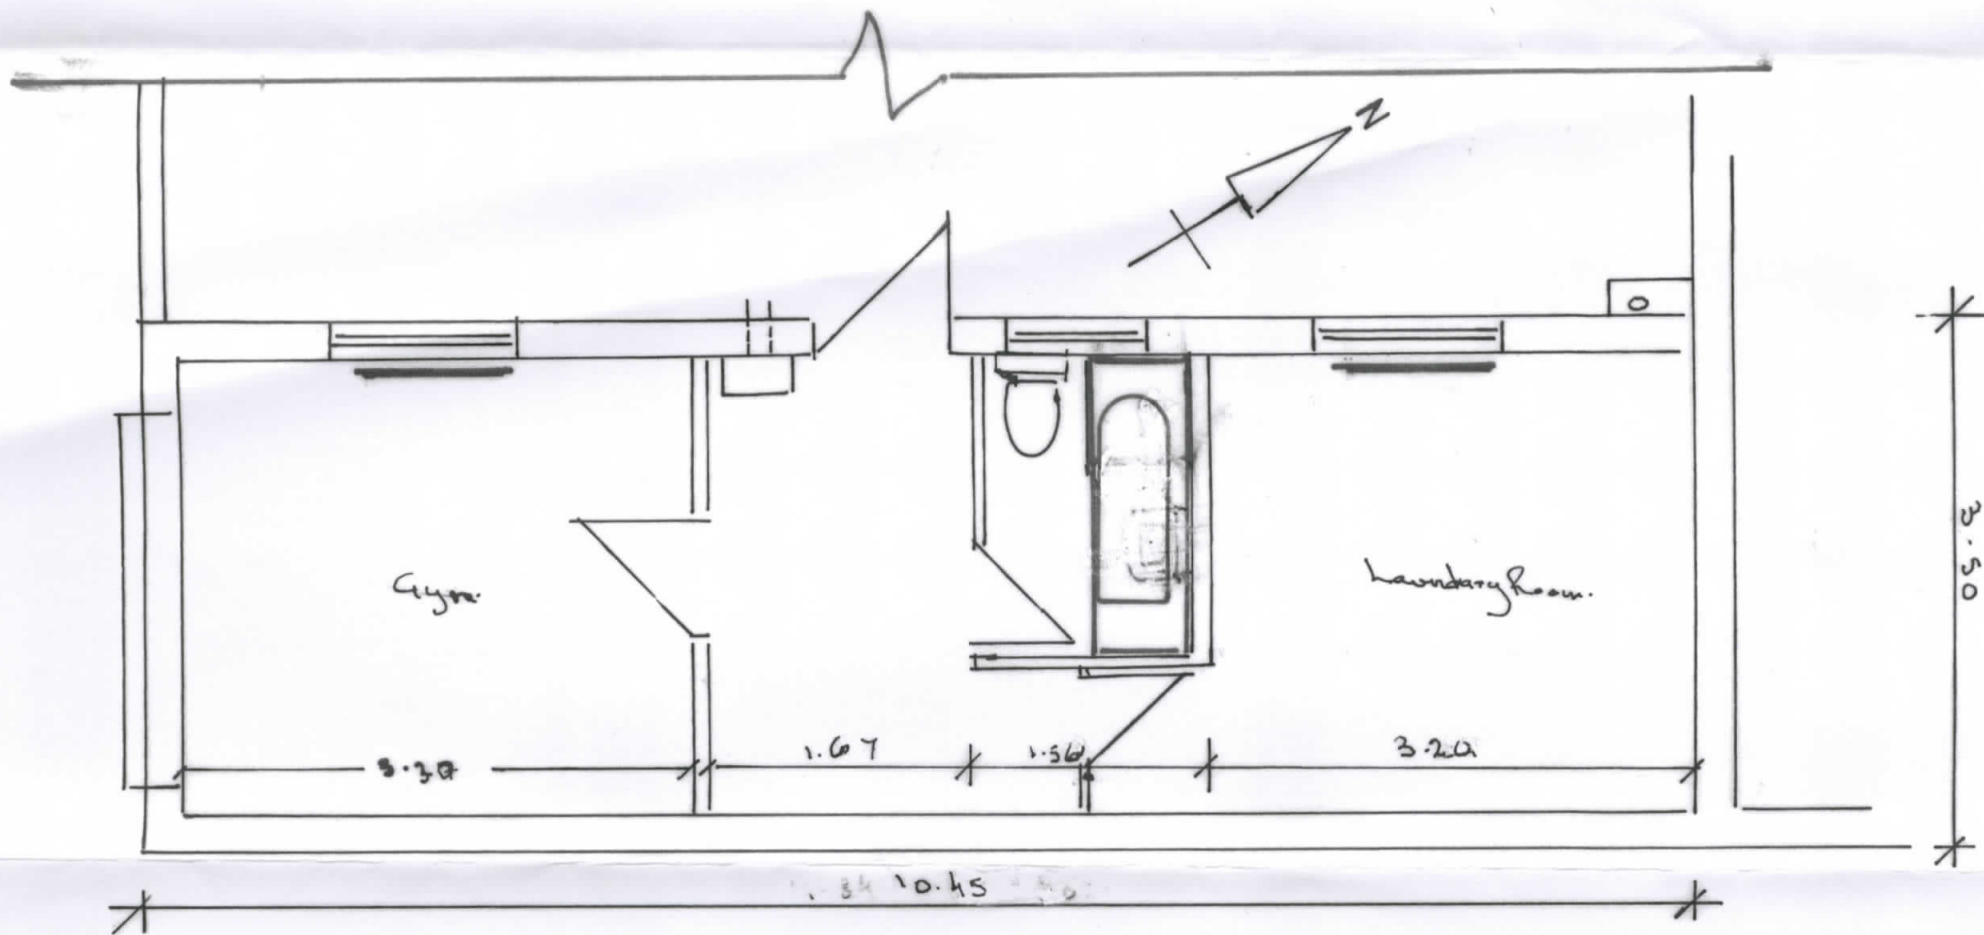
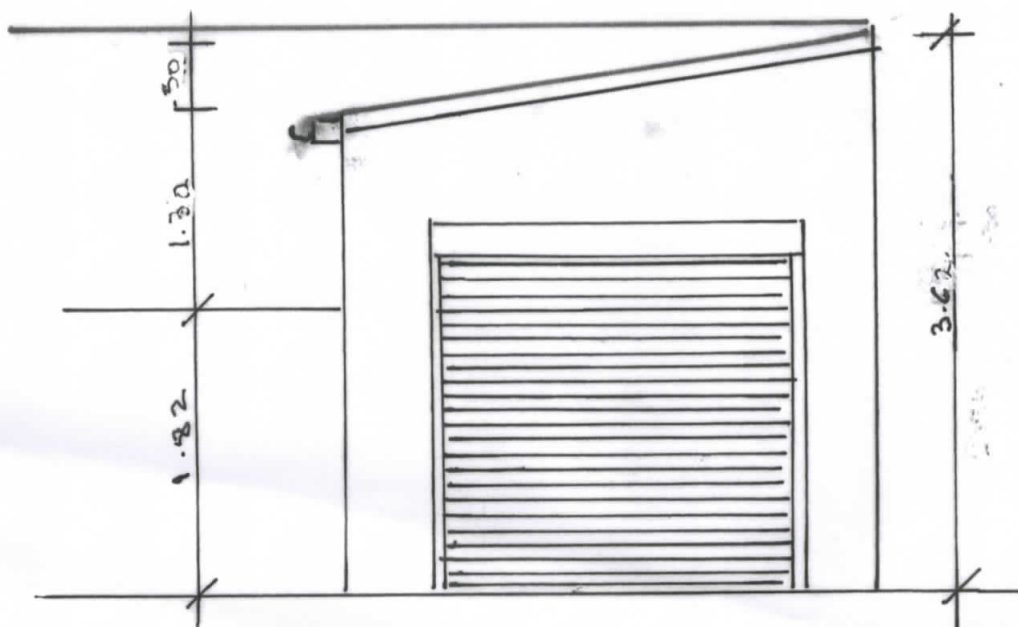


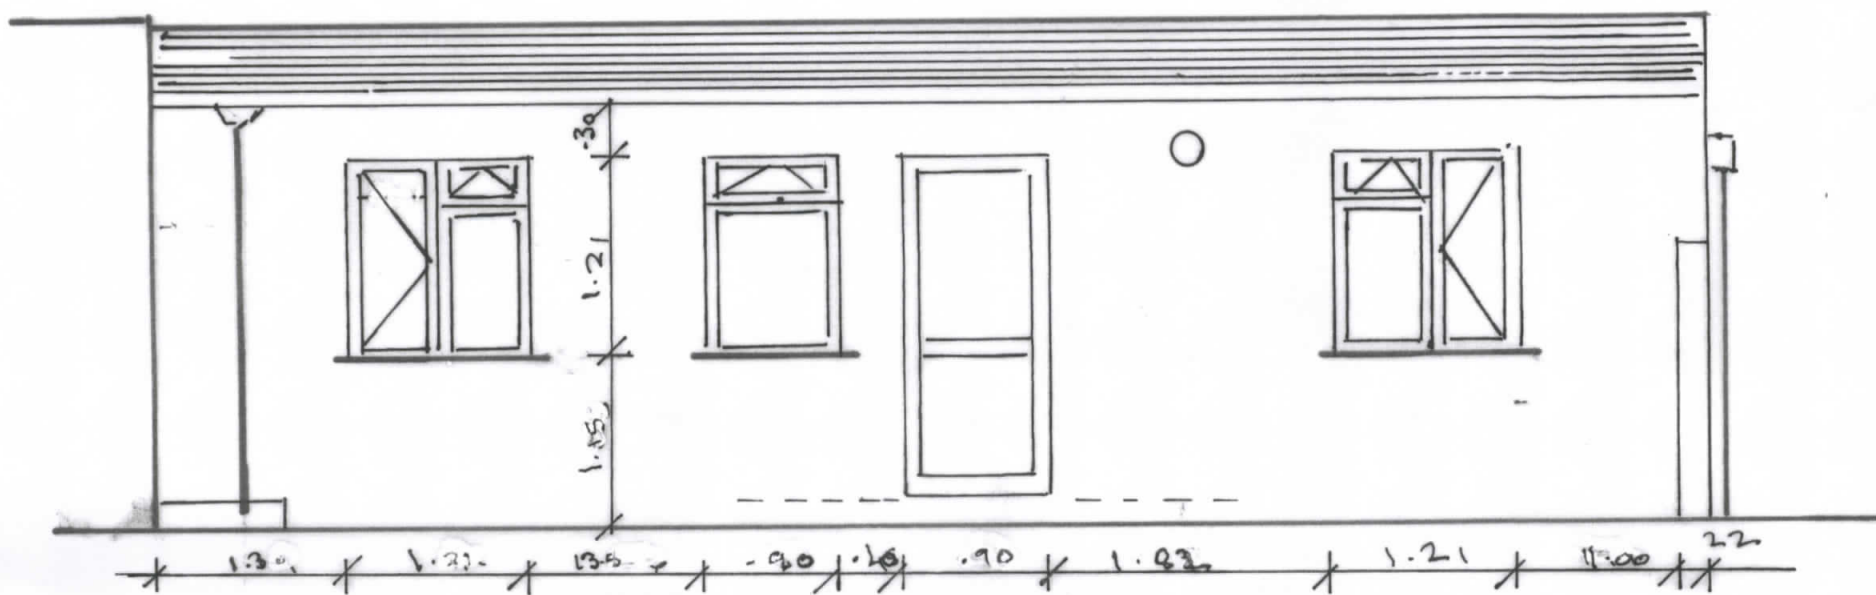

Single Storey outbuilding at the rear of 22 Brookside Road, Hayes, Middx UB8 4DPH	NOTES: All dimensions must be checked on site and not scaled from this drawing.	Client Job Title AS Developed.	Scale 1:50 Drawn by SB. Date March 2009	Drawing Title AS Constructed. Drg No. SB/22/BS Rev
--	---	---	---	---

A PRODUCT OF THE UNO RANGE - ARCHITECT CAT. No. 7313

420x297mm A3

PLANNING & TRANSPORTATION
GROUP

27 MAR 2009