
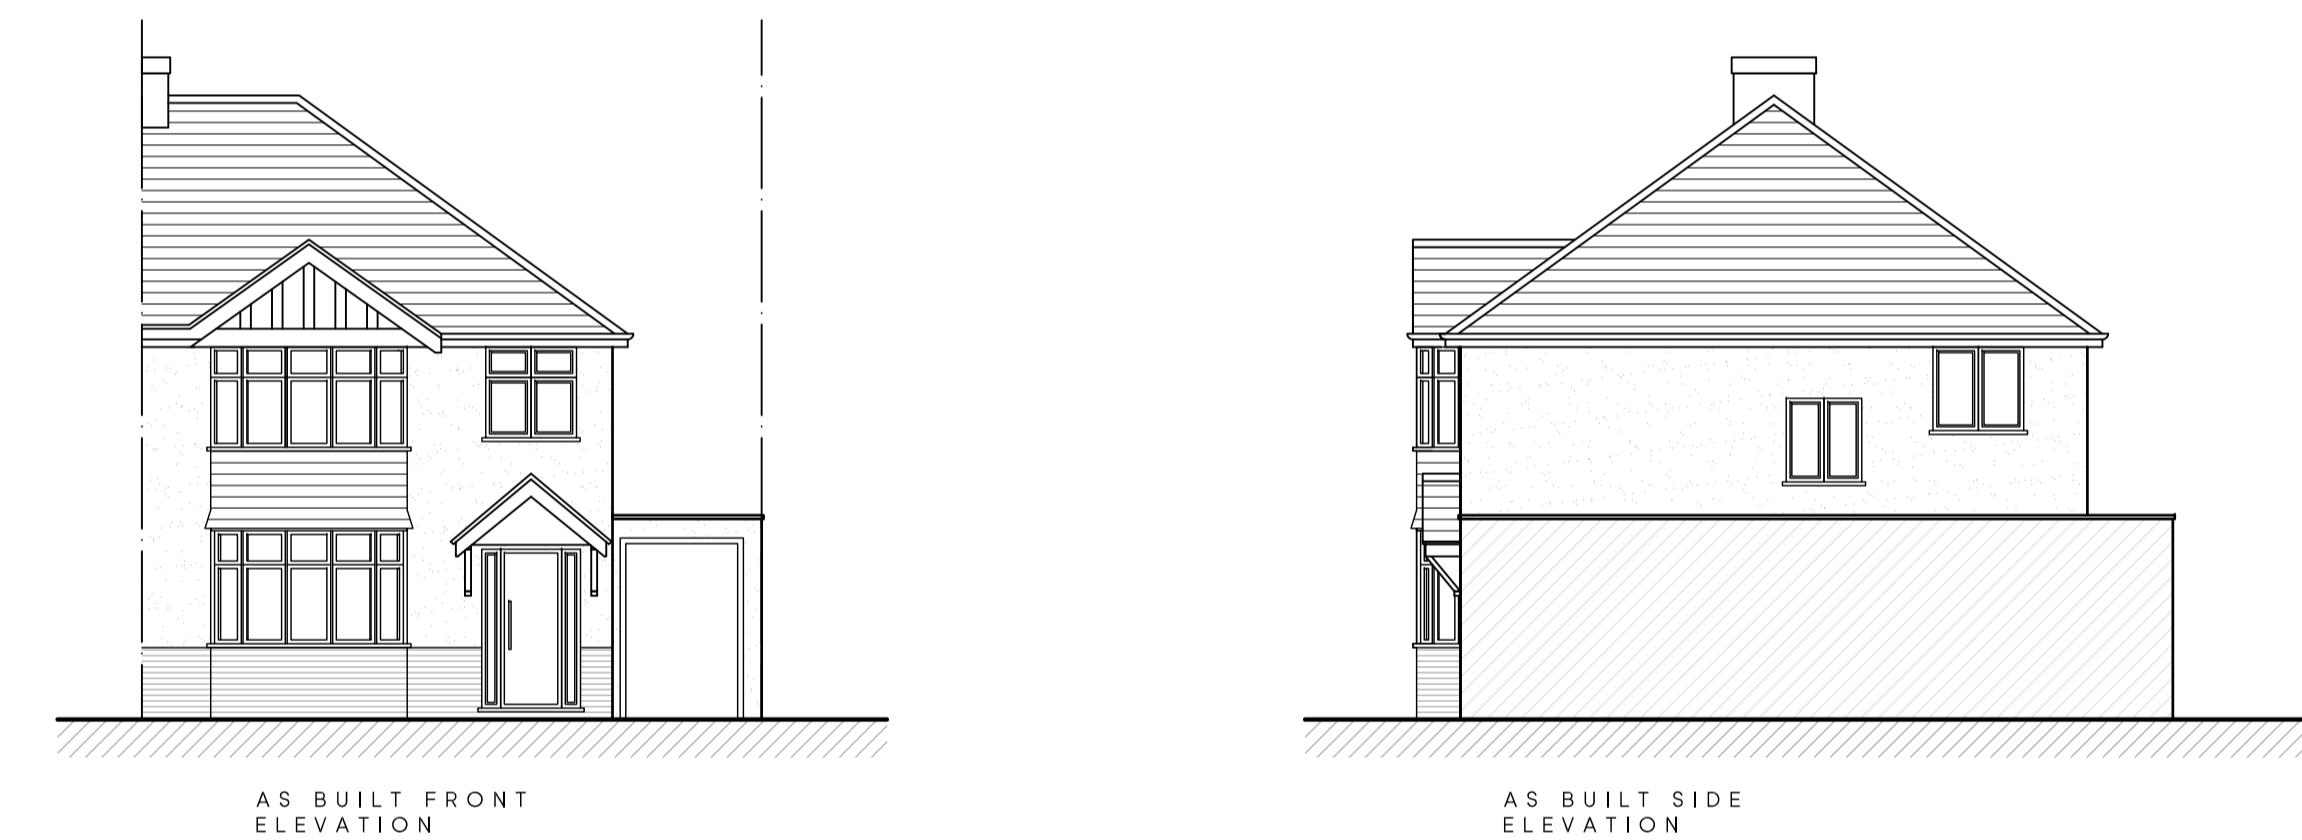


0 1m 2m 5m 10m 20m
SCALE BAR 1:100

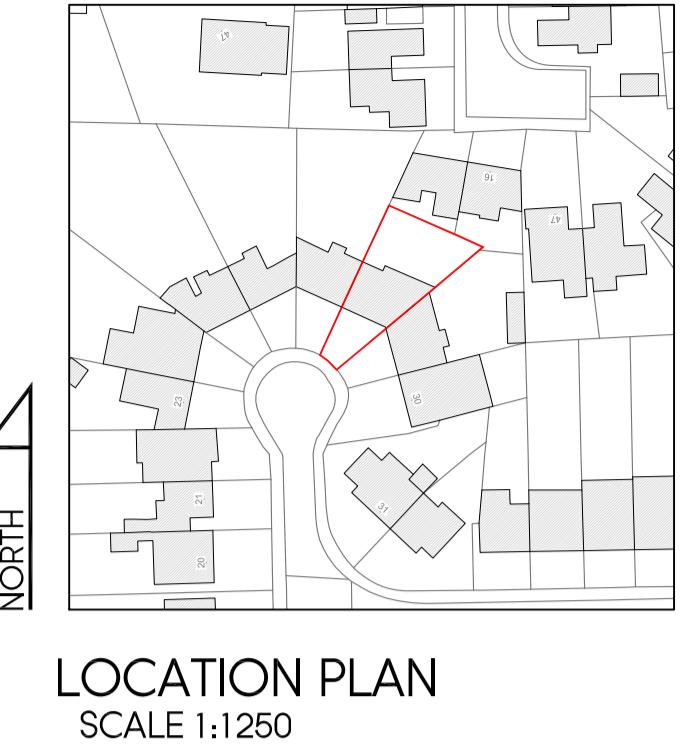

Rev	Date	Description	Init.
Client			
MR PUNNI			
Project Title PROPOSED LAWFUL DEVELOPMENT: EXISTING USE			
26 CANDOVER CLOSE, WEST DRAYTON, UB7 0BD Drawing Title			
EXISTING PLANS AND ELEVATIONS			
Cad File P001 Drawn by KP Project No. 1966	Sheet Size A1 Drawing Date MAY 2023 Drawing No. P201	Scale 1:100 Approved by NJ Revision -	

 **Juttlia
Architects**
2-4 High Street Ruislip
Middlesex HA4 7AR
01895 840077 | 01895 840078
info@juttlia-architects.com
juttlia-architects.com

This drawing is property of Juttlia Architects Ltd © and must not be copied or otherwise reproduced. All dimensions must be checked on site before commencing work. No dimensions to be scaled from this drawing. This drawing was produced using AutoCAD 2016.

PLANNING ISSUE