

0 5 10 15 20 25 50  
Metres



SITE PLAN  
1:500@A1



0 5 10 15 20 25 50  
Metres



LOCATION PLAN  
1:1250@A1



- 14/05/23 PLANNING ISSUE

REV DATE

NOTE  
When this drawing is issued in uncontrolled CAD format it will be accompanied by a PDF version. It is the responsibility of the user to prepare their own documents / models / drawings for which they are solely responsible.  
The recipient should report all drawing errors, omissions and discrepancies to the architect. All dimensions should be checked on site by the contractor and such dimensions shall be the contractor's responsibility.

Panorama Design and Property Limited accepts no responsibility or liability for:-  
- any use of this drawing by parties other than the party for whom it was prepared  
- any alterations or additions to or discrepancies arising out of changes to the background information on which the drawings are based that was current at the time the drawing was prepared or that occurs after it has been issued by Panorama Design and Property Limited  
- any loss or degradation of the information held in this drawing resulting from the translation from the original file format to any other file format or from the recipients reading of it in any other programme or any version of the programme other than that supplied by Panorama Design and Property Limited  
- the accuracy of such information provided by others or for any costs, claims, proceedings and expenses arising out of reliance on such information  
- any scaling from this drawing other than by the local planning authority solely for the purposes of the planning application to which it relates

**PANORAMA**  
ARCHITECTS + INTERIOR DESIGNERS

PANORAMA DESIGN AND PROPERTY Ltd  
32 FOWEY AVENUE, LONDON IG1 5JT  
TEL 07575274811 WEB WWW.PANORAMADP.CO.UK


job title  
**15 DENECROFT CRESCENT**

drawing title / location  
**SITE AND LOCATION PLANS**  
**PLANNING**

drawn by	checked	scale	status
SZ	SZ		PLANNING


project	zone	source	classification	drawing no.	revision
0102	-	-	(02)_000	-	

- ① EPDM ROOF
- ② UPVC FASCIA BOARD
- ③ WHITE RENDERED FINISH
- ④ UPVC WINDOWS AND DOORS
- ⑤ BLACK UPVC GUTTER

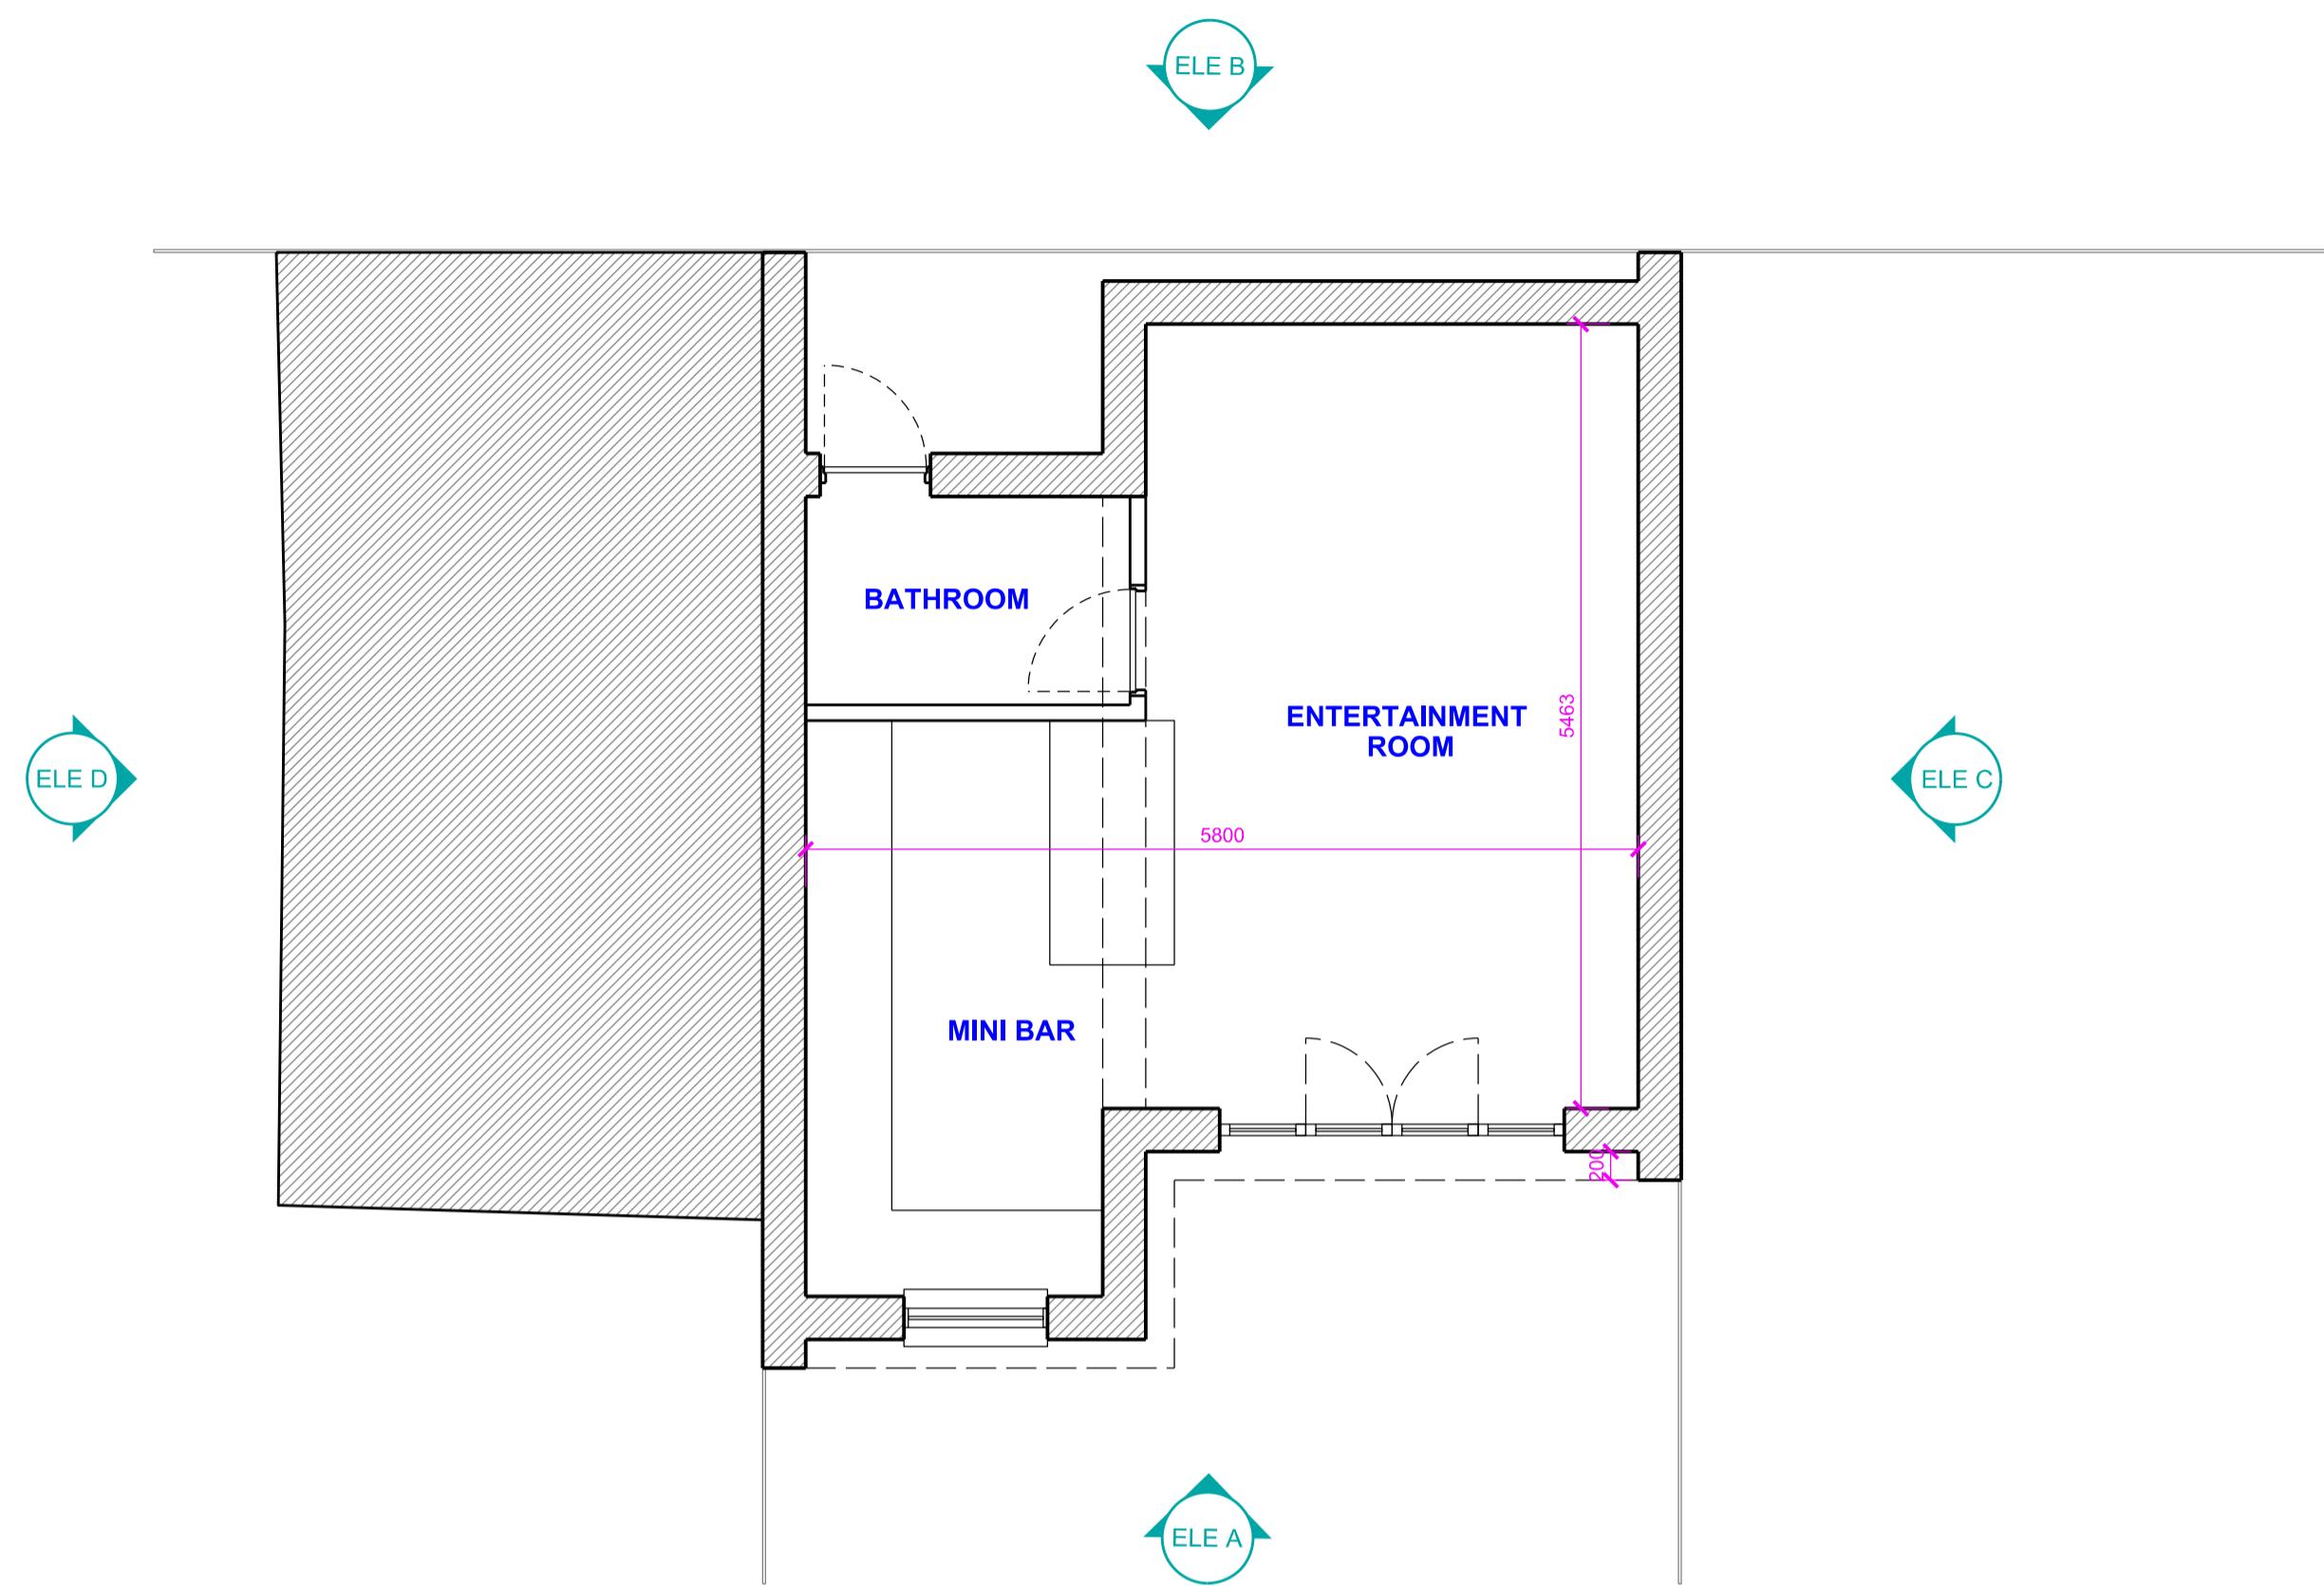


GARDEN ROOM FLOOR PLAN

1:50@A1

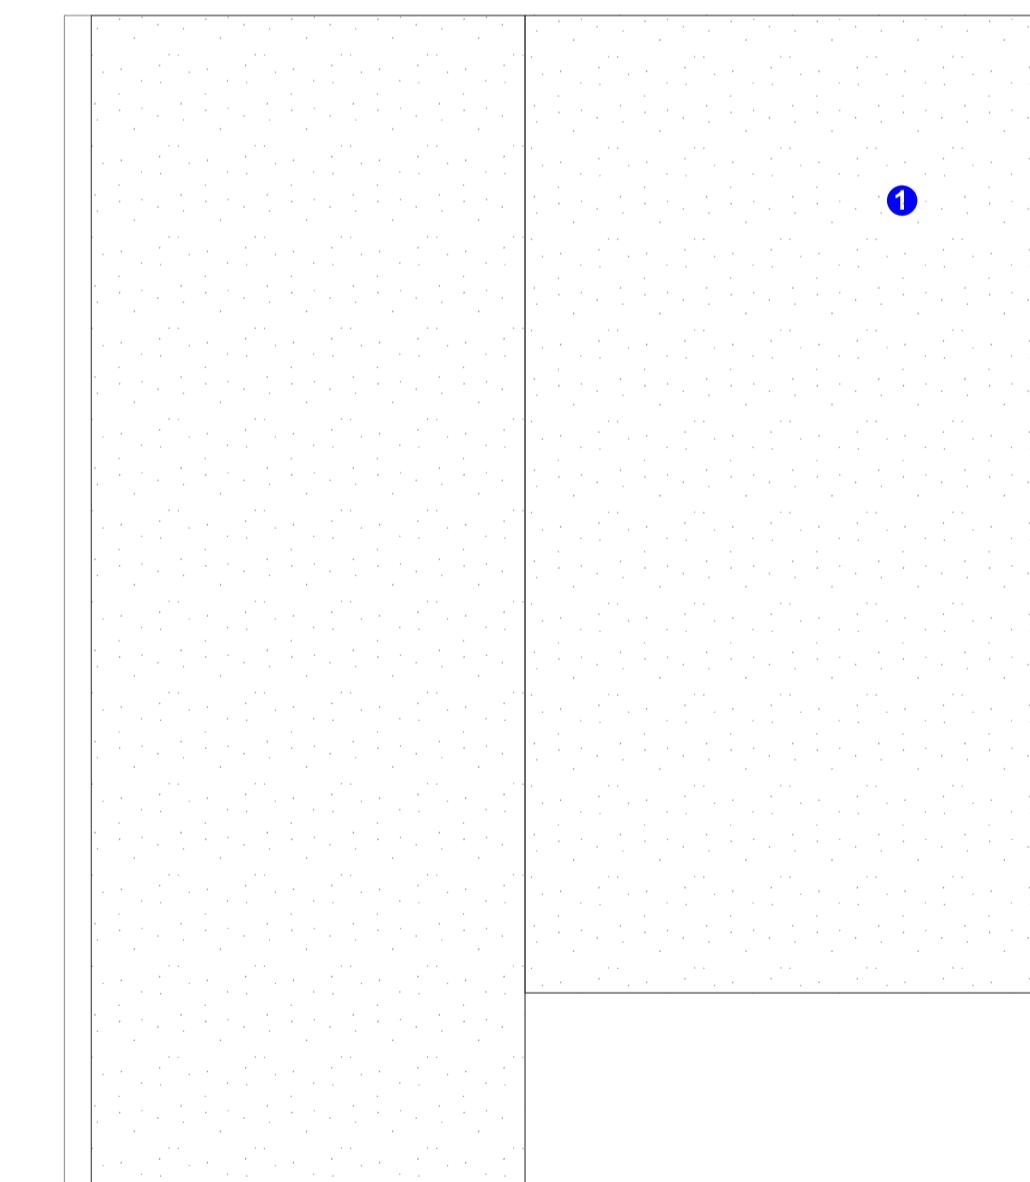


GARDEN ROOM ROOF PLAN

1:500@A1

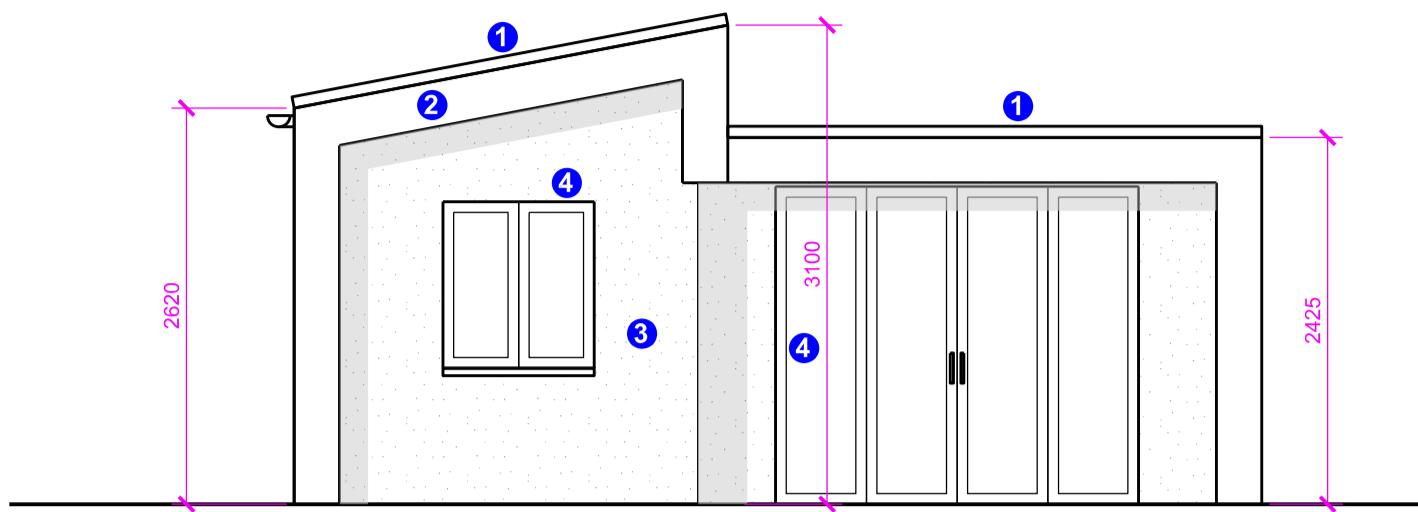


GARDEN ROOM ELEVATION A

1:50@A1

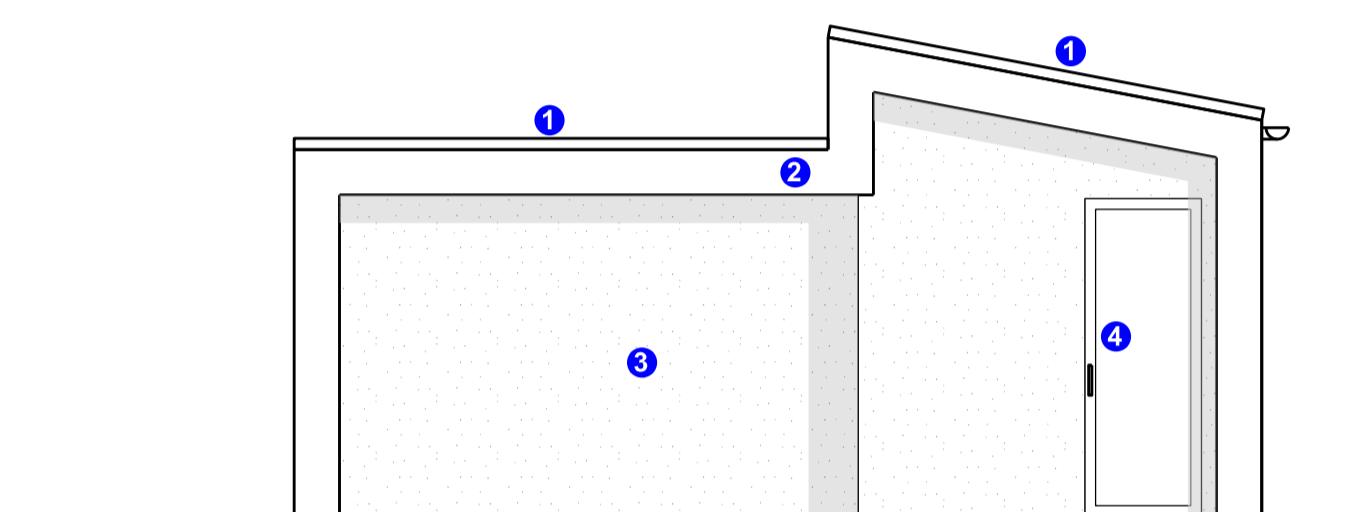


GARDEN ROOM ELEVATION B

1:50@A1

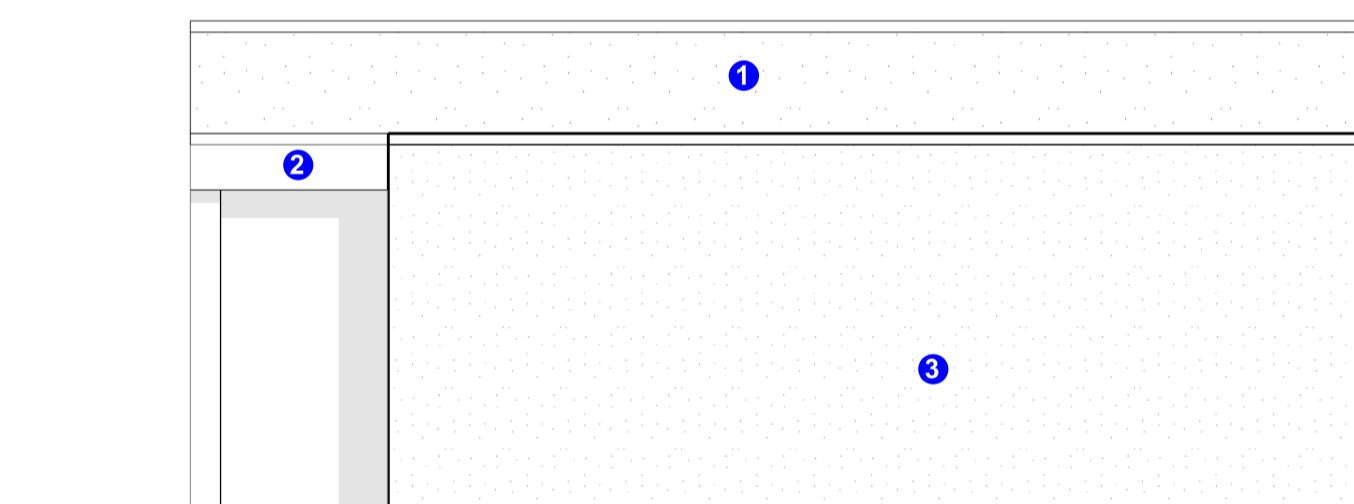

GARDEN ROOM ELEVATION C

1:50@A1

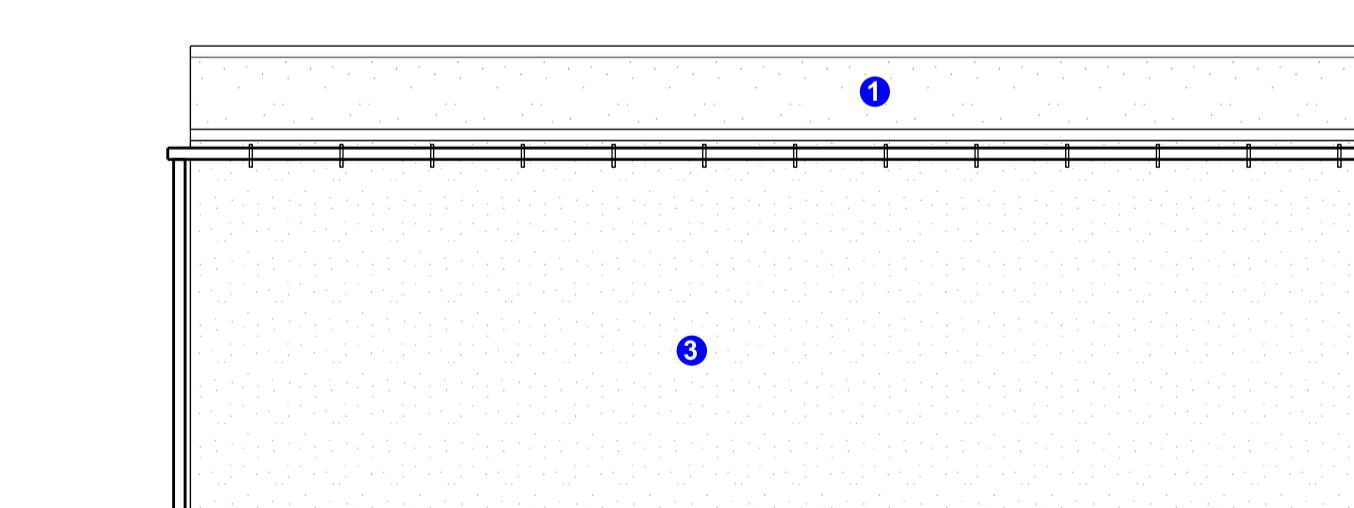

GARDEN ROOM ELEVATION D

1:50@A1

		01/05/23	PLANNING ISSUE
REV	DATE		

NOTE  
When this drawing is issued in uncontrolled CAD format it will be accompanied by a PDF version. It is the responsibility of the user to prepare their own documents / models / drawings for which they are solely responsible.  
The recipient should report all drawing errors, omissions and discrepancies to the architect. All dimensions should be checked on site by the contractor and such dimensions shall be the contractor's responsibility.

Panorama Design and Property Limited accepts no responsibility or liability for:-  
- any use of this drawing by parties other than those for whom it was prepared  
- any alterations or additions to or discrepancies arising out of changes to the background information on which the drawings are based that was current at the time it was issued and which occur during the period after it has been issued by Panorama Design and Property Limited  
- any loss or degradation of the information held in this drawing resulting from the translation from the original file format to any other file format or from the recipients reading of it in any other programme or any version of the programme other than that issued by Panorama Design and Property Limited  
- the accuracy of such information provided by others or for any costs, claims, proceedings and expenses arising out of reliance on such information  
- any scaling from this drawing other than by the local planning authority solely for the purposes of the planning application to which it relates

**PANORAMA**  
ARCHITECTS + INTERIOR DESIGNERS

PANORAMA DESIGN AND PROPERTY Ltd  
32 FOWEY AVENUE, LONDON IG1 5JT  
TEL 07575274811 WEB WWW.PANORAMADP.CO.UK

job title  
15 DENECROFT CRESCENT

drawing title / location  
AS BUILT PLANS AND ELEVATIONS  
PLANNING

drawn by	checked	scale	status		
SZ	SZ	1:50@A1; 1:100@A3	PLANNING		
project	zone	source	classification	drawing no.	revision
0102	-	-	(02)_100	-	-