


NOTES  
CONTRACTORS MUST VERIFY ALL DIMENSIONS ON SITE BEFORE  
COMMENCING ANY WORK OR SHOP DRAWINGS  
DO NOT SCALE FROM THIS DRAWING  
RE ATRA COPYRIGHT

Rear Garden  
With Patio Area  
c.line  
party wall

Prayer Hall  
+2450  
④


Prayer Hall  
+2450  
⑤

Non Open Able Unless Parts  
Of The Flank Window Which Can  
Be Opened Are More Than 1.7m  
Above The Floor Of The Room  
In Which The Window Is Installed  
(Obscure Glass Window)

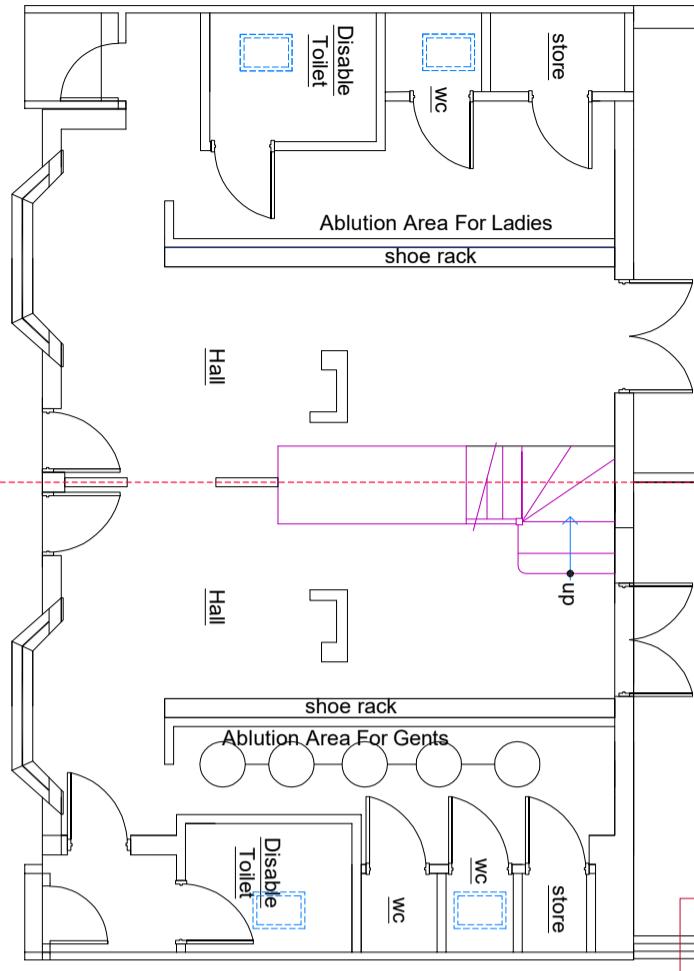

Front Drive  
Ground Floor Layout - As Built

+2450 denotes floor  
to ceiling height

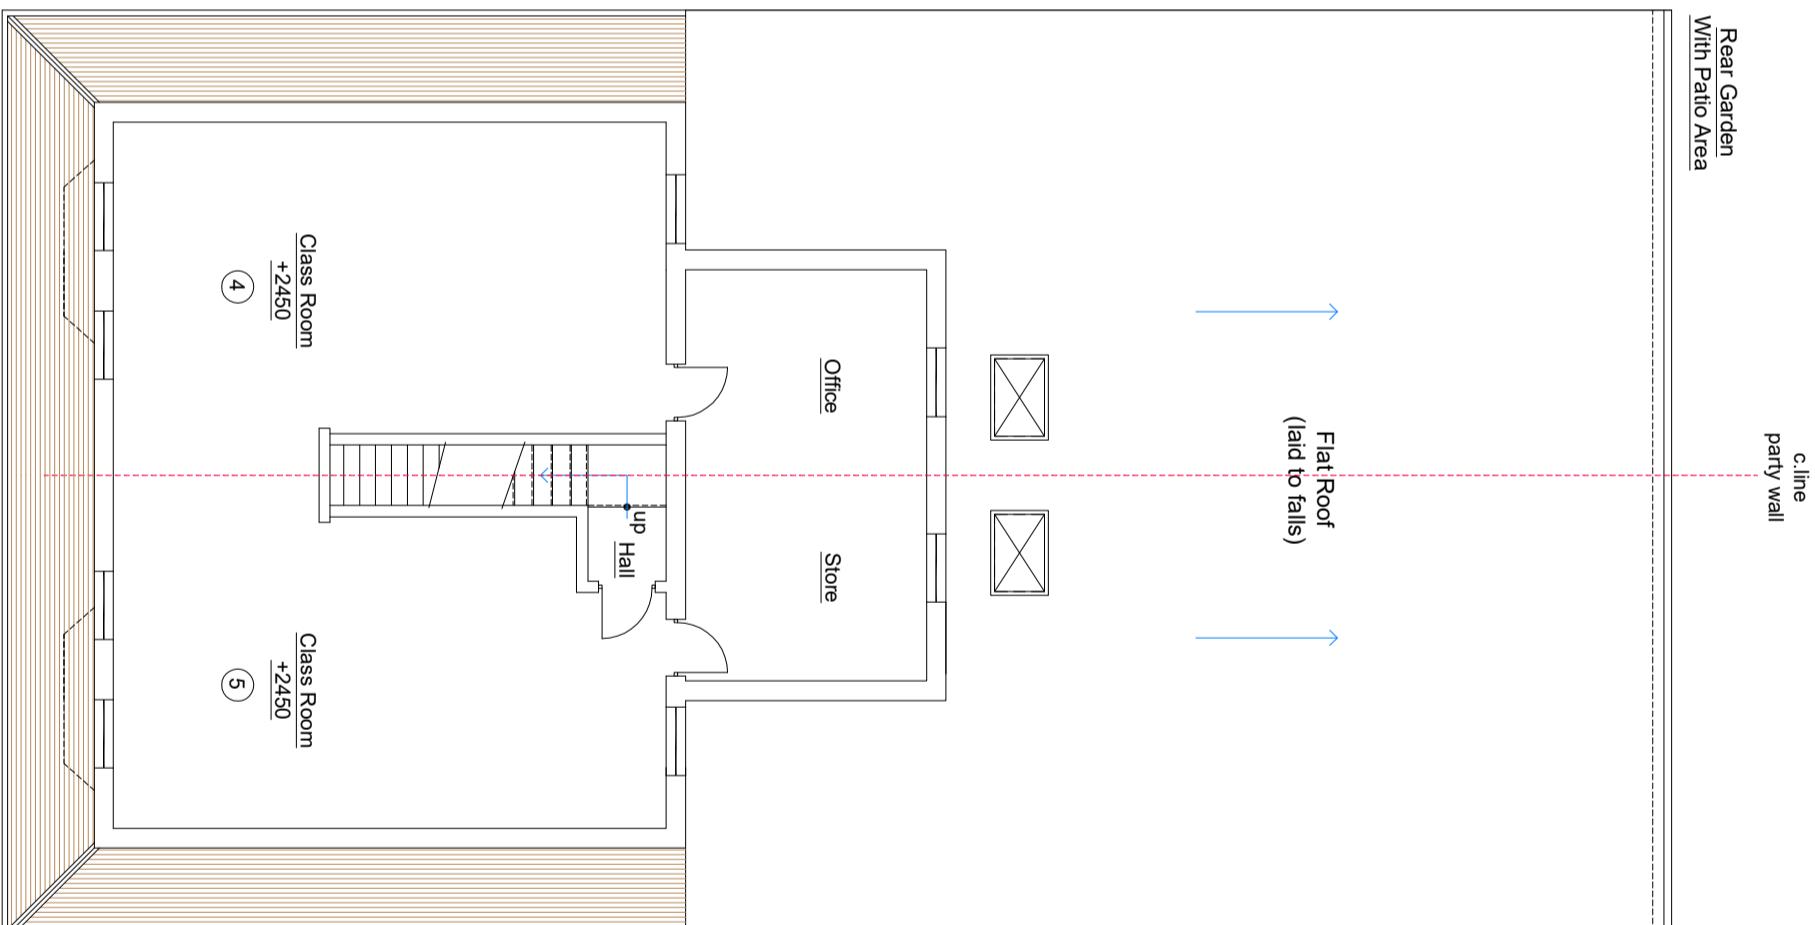

Front Drive  
First Floor Layout - As Built

+2450 denotes floor  
to ceiling height

Rear Garden  
With Patio Area  
c.line  
party wall

Flat Roof  
(laid to falls)

NOTES:  
1. All dimensions to be verified on site  
and any discrepancy reported to the  
client  
2. This drawing to be read in conjunction  
with all relevant drawings

owners to serve party wall act notice  
on owners of adjacent property and  
obtain written agreement, prior to  
commencement of any works

client/builder to obtain all  
planning permission approvals  
from the relevant authority.  
commencement of building works  
prior to the planning &  
building control approvals  
is to client/builder's own risk

PROJECT	CLIENT
4-5 Cowley Mill Road	Muslim Community Centre
Uxbridge - Middlesex	
UB8 2QB	
DRAWING TITLE	
As Built Floor Layouts	
Sheet 4	
DRAWING STATUS	
As Built	
DRAWING NUMBER	
2024 - 22 - 04	
REVISION	
A	

0  
1m  
2m  
3m  
Scale Bar