

NOTES  
 CONTRACTORS MUST VERIFY ALL DIMENSIONS ON SITE BEFORE  
 COMMENCING ANY WORK OR SHOP DRAWINGS  
 DO NOT SCALE FROM THIS DRAWING  
 RE ATRA COPYRIGHT

Notes:

1. All dimensions to be verified on site and any discrepancy reported to the client
2. This drawing to be read in conjunction with all relevant drawings

c.line  
 party wall  
 Rear Garden  
 With Patio Area

c.line  
 party wall


Rear Garden  
 With Patio Area

c.line  
 party wall


Rear Garden  
 With Patio Area

owners to serve party wall act notice on owners of adjacent property and obtain written agreement, prior to commencement of any works

client/builder to obtain all planning permission approvals from the relevant authority. commencement of building works prior to the planning & building control approvals is to client/builder's own risk

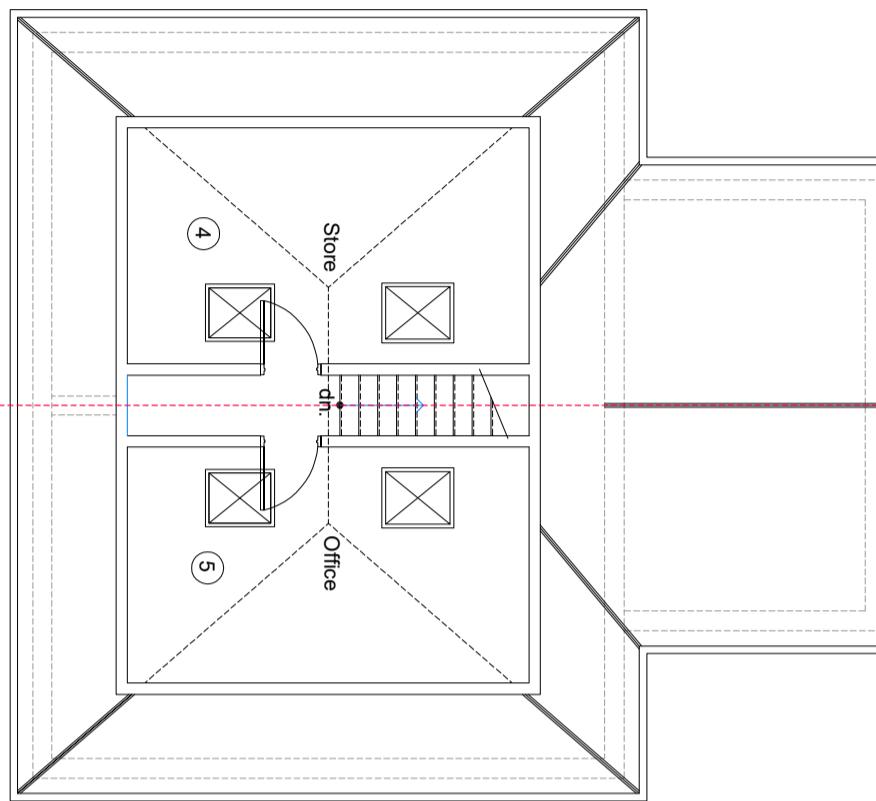

Loft Floor Layout - As Built

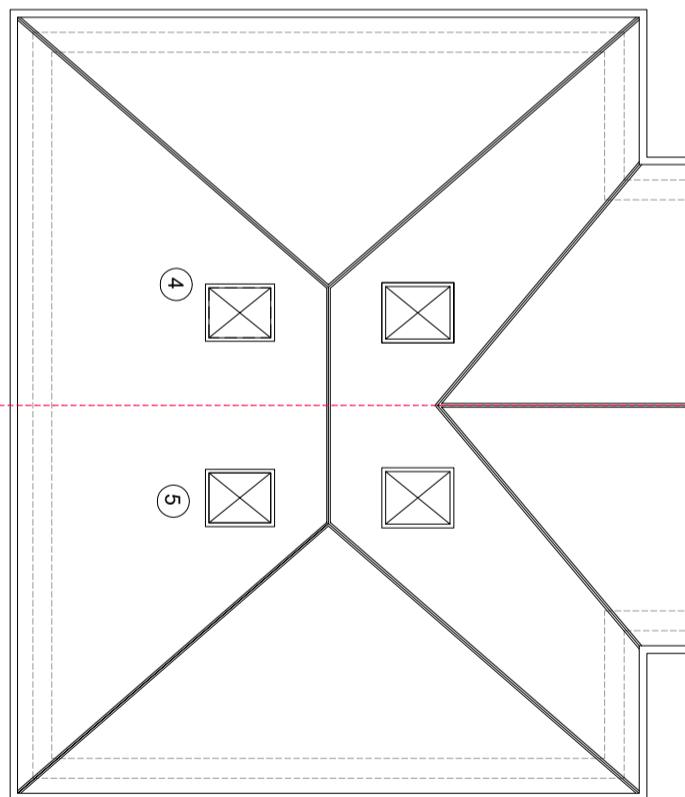

Roof Layout - As Built

0  
 1m  
 2m  
 3m  
 Scale Bar

PROJECT	DRAWN BY	CHEKED	DATE
4-5 Cowley Mill Road			
Uxbridge - Middlesex			
UB8 2QB			

REV	AMENDMENT	DATE	CHK'D
A	Planning Issue	13.02.24	RS

**As Built**

DRAWING STATUS

Planning Issue

As Built Floor Layouts  
 Sheet 5

SCALE 1:50 @ A1  
 DRAWN BY RS  
 CHECKED RS  
 DATE 13.02.24

DRAWING NUMBER 2024 - 22 - 05  
 DRAWING TITLE Planning Issue  
 REVISION A