
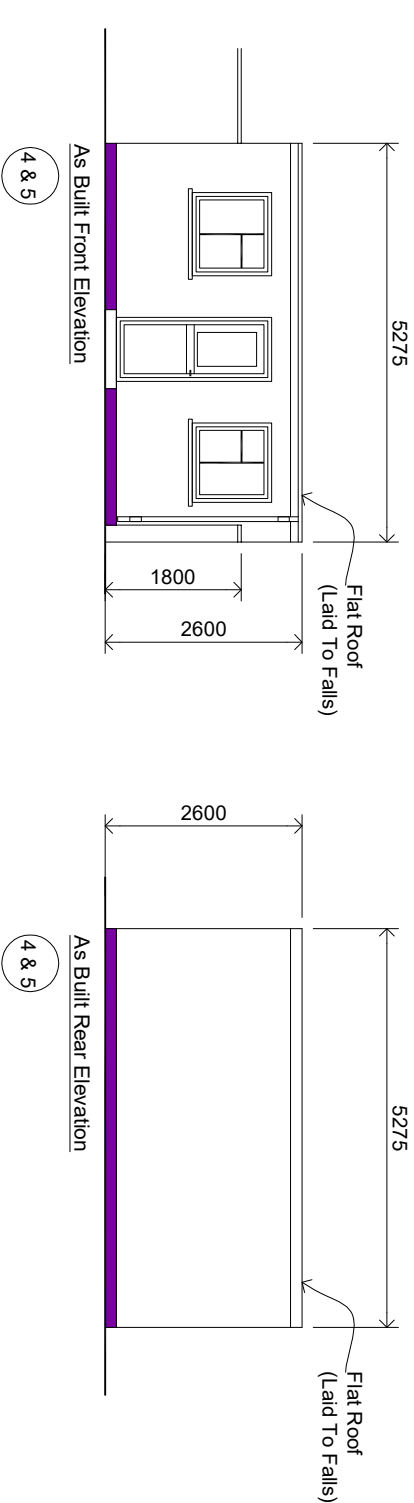


Out Building:
Used For Storage
Purposes Only

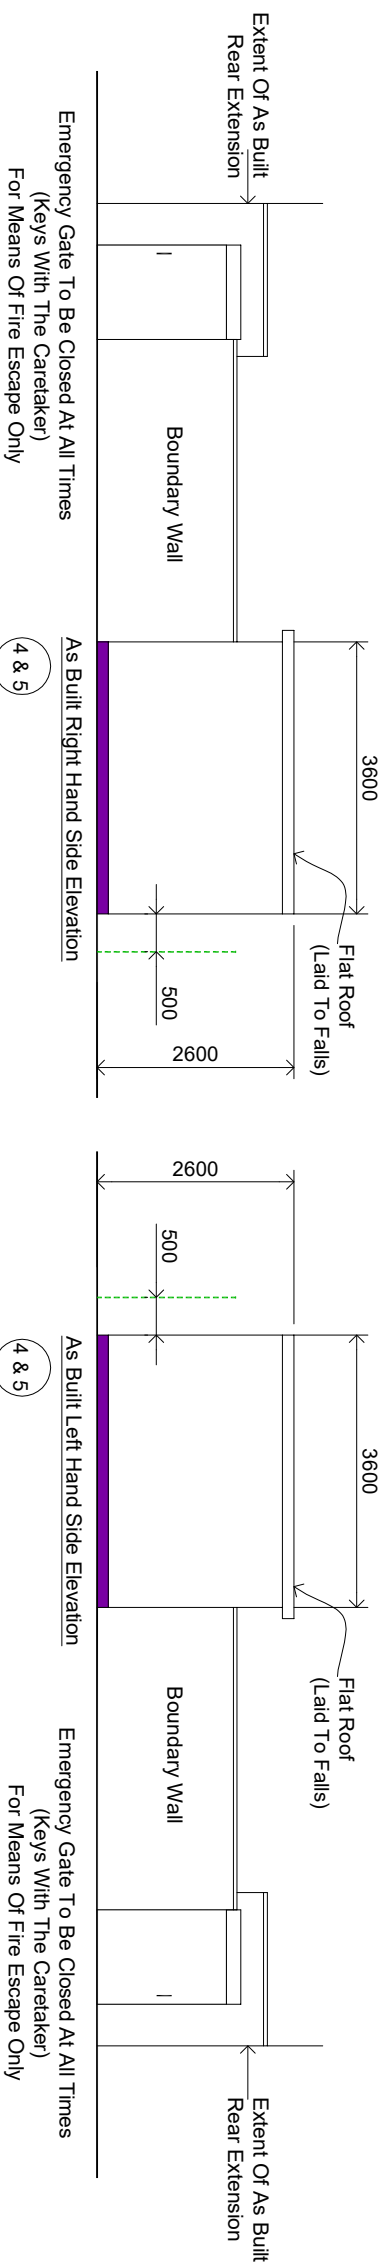

NOTES
CONTRACTORS MUST VERIFY ALL DIMENSIONS ON SITE BEFORE COMMENCING ANY WORK ON SHOP DRAWINGS
DO NOT SCALE FROM THIS DRAWING
RS ATPA COPYRIGHT

- Notes:
- All dimensions to be verified on site and any discrepancy reported to the client
 - This drawing to be read in conjunction with all relevant drawings

owners to serve party wall ad notice on owners of adjacent property and obtain written agreement, prior to commencement of any works

client/builder to obtain all planning permission approvals from the relevant authority, prior to the commencement of building works and building control approvals is to client/builders own risk

REV	AMENDMENT	DATE	CHD
A	Planning Issue	13.02.24	RS



CLIENT	
Muslim Community Centre	
PROJECT	
4 - 5 Cowley Mill Road Uxbridge - Middlesex UB8 2QB	
DRAWING TITLE	
As Built OutBuilding Sheet 7	

SCALE	DRAWN BY	CHECKED	DATE
1:50 @ A1	RS	RS	13.02.24
1:100 @ A3			
DRAWING NUMBER	REVISION		
2024 - 22 - 07	A		

As Built
Planning Issue