



FOR CONSTRUCTION PURPOSES DO NOT SCALE FROM THIS DRAWING.
ALL DIMENSIONS TO BE CHECKED ON SITE. ANY DISCREPANCIES MUST BE
REPORTED TO THE ARCHITECT FOR VERIFICATION PRIOR TO
COMMENCEMENT OF THE EFFECTED WORKS. IF IN DOUBT ASK. THIS
DRAWING IS COPYRIGHT.

Rev No	Date	Revision note
P1	03.09.2010	Planning issue.
P2	16.09.2014	Survey dimension included on Brook Business Centre River Colne side boundary.
P3	25.09.2014	River Colne side boundary highlighted for topo. survey.

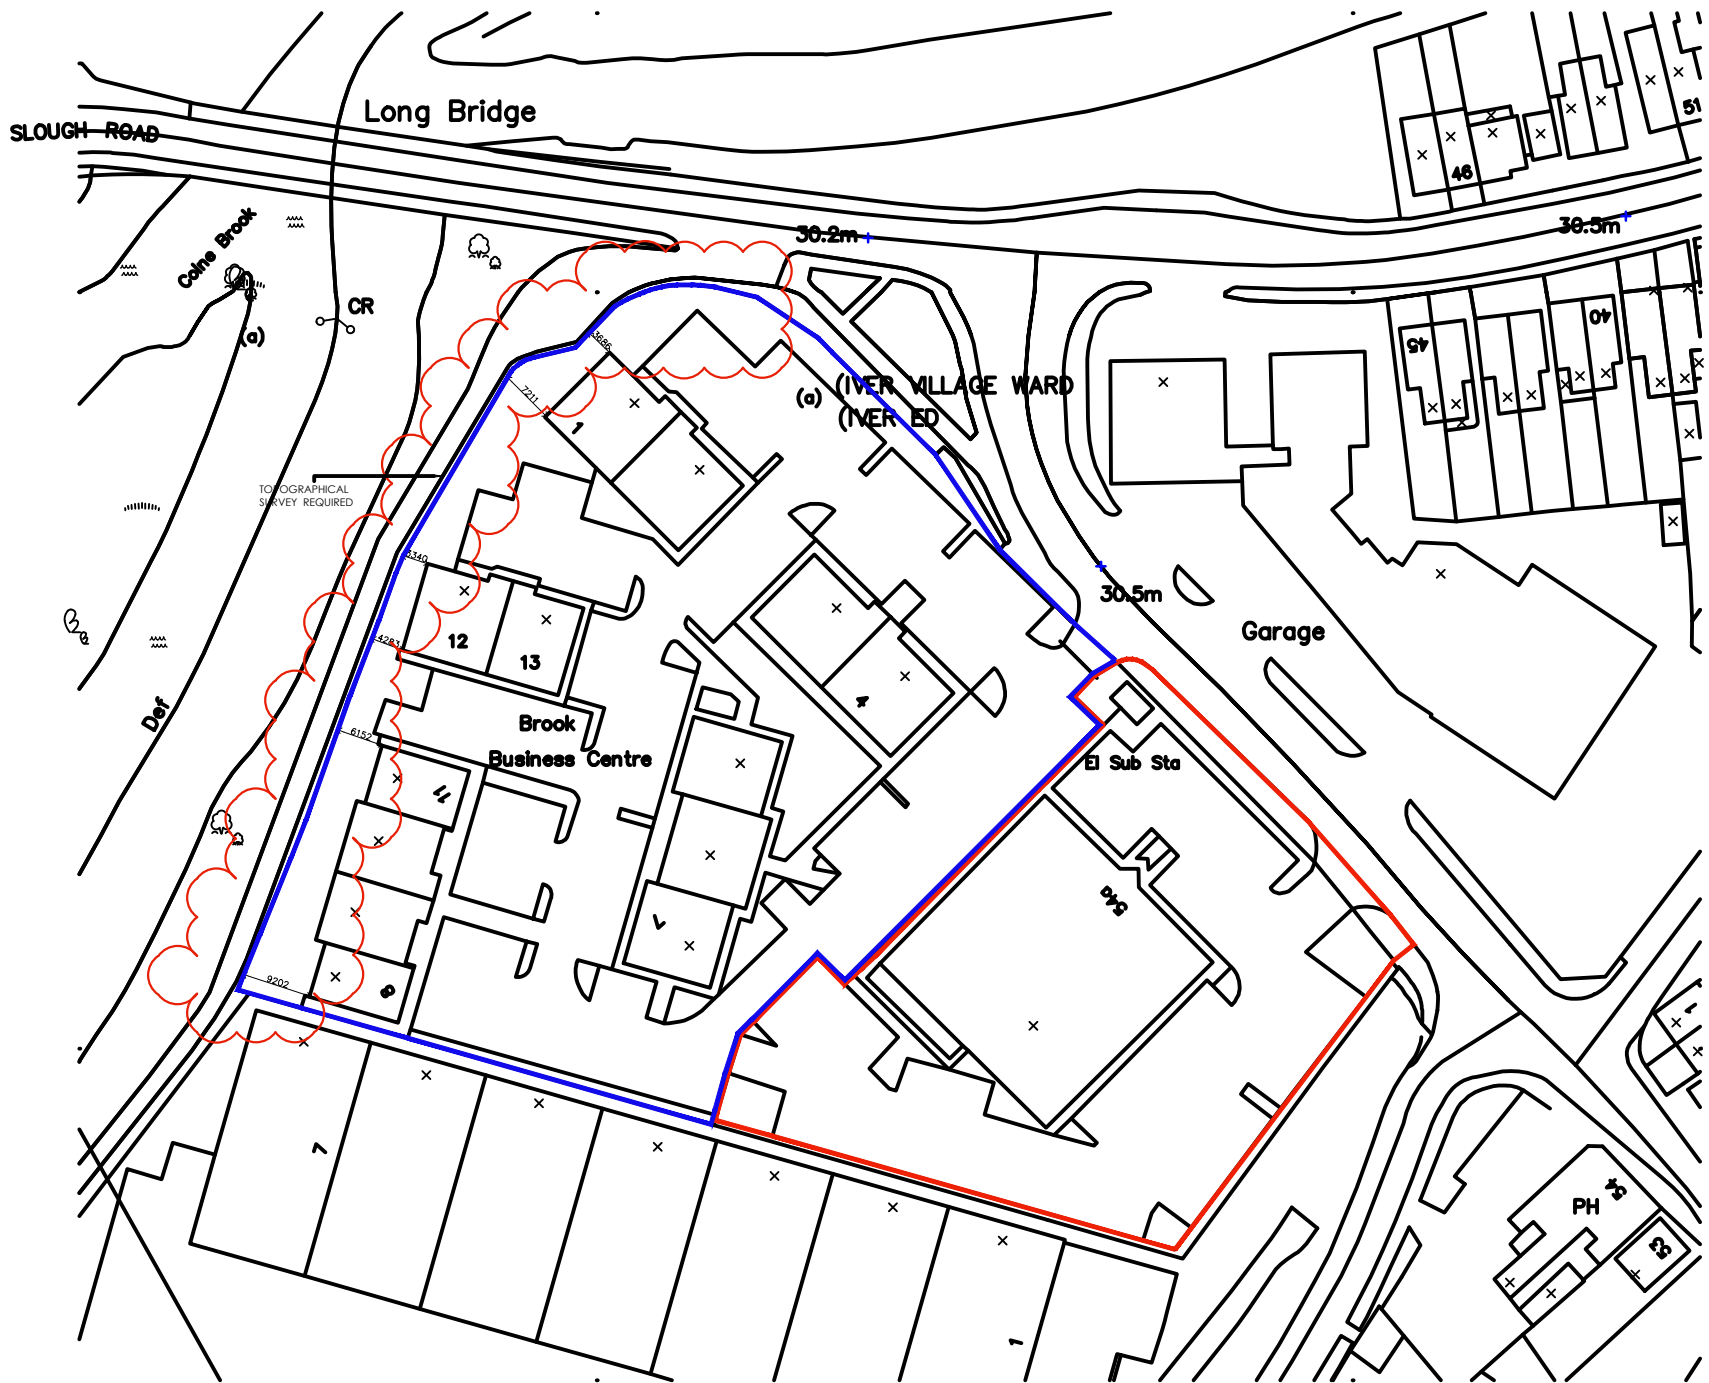

Red line area = 3724m²

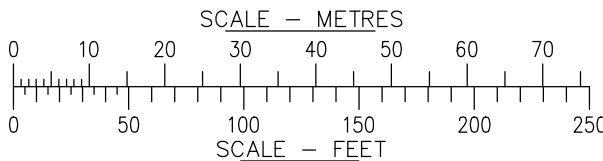

jpb
architects

BROOK HOUSE
54a COWLEY MILL ROAD
UXBRIDGE UB8 2FX
TEL: (01895) 272 446
FAX: (01895) 272 483
EMAIL: admin@jpbarchitects.co.uk

JOB TITLE

BROOK HOUSE
54a COWLEY MILL ROAD
UXBRIDGE MIDDLESEX
UB8 2QE

DRG TITLE

SITE LOCATION PLAN

SCALE @ A3
1:1000 @ A3

DATE
AUG 2010

JOB NO.
10401

DRG NO.
100

REV
P3