




4 Existing (As-Built) Front Elevation

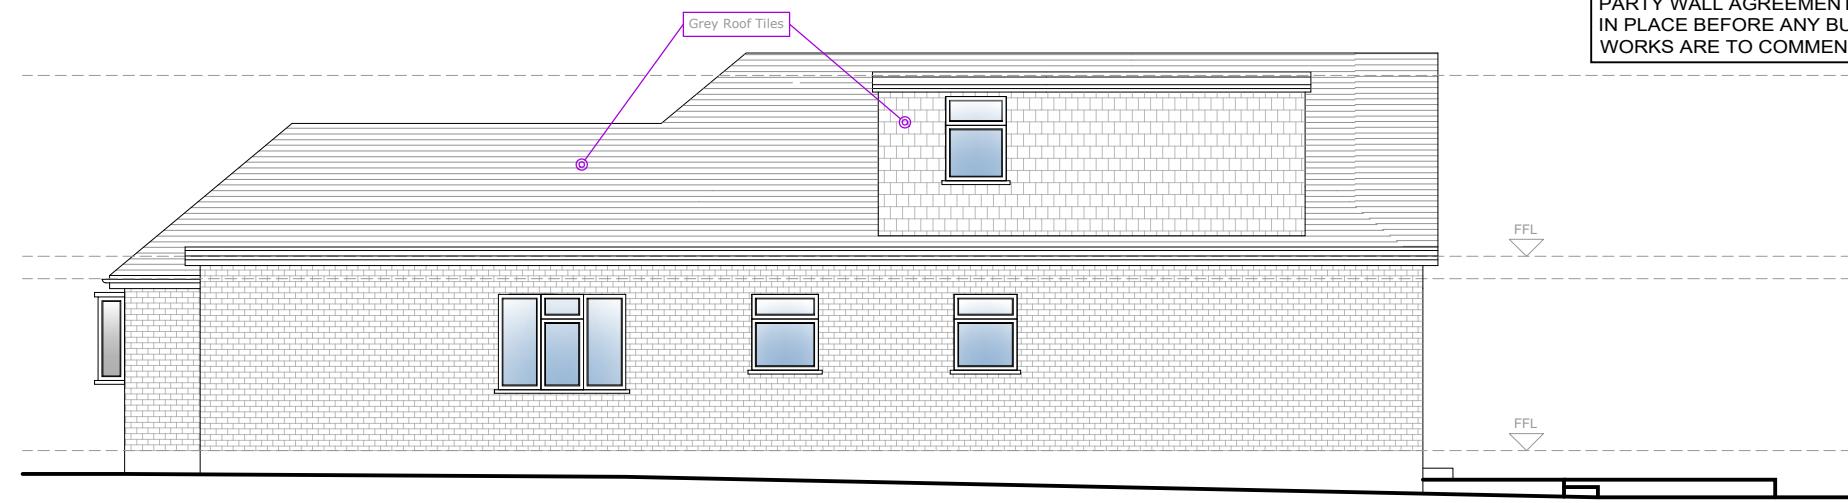


5 Existing (As-Built) Side Elevation

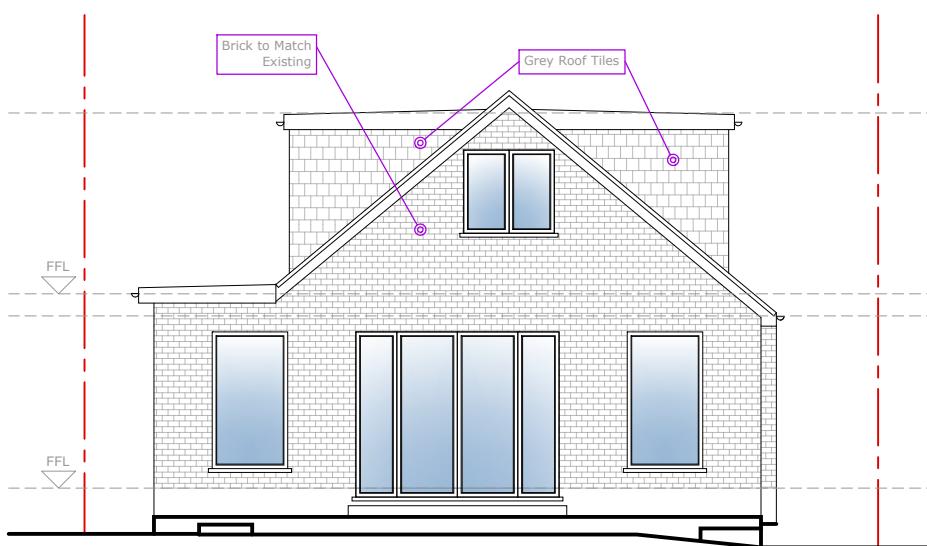


6 Existing (As-Built) Rear Elevation

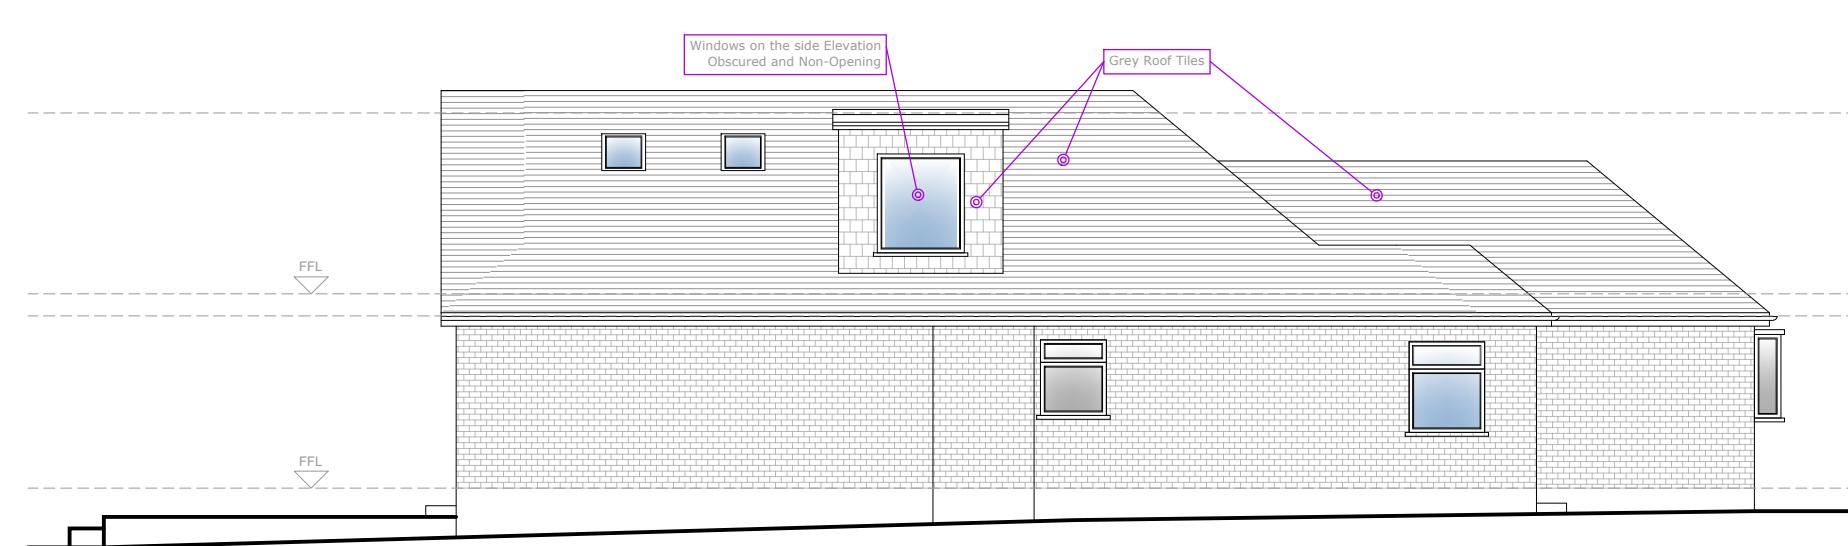

7 Existing (As-Built) Side Elevation

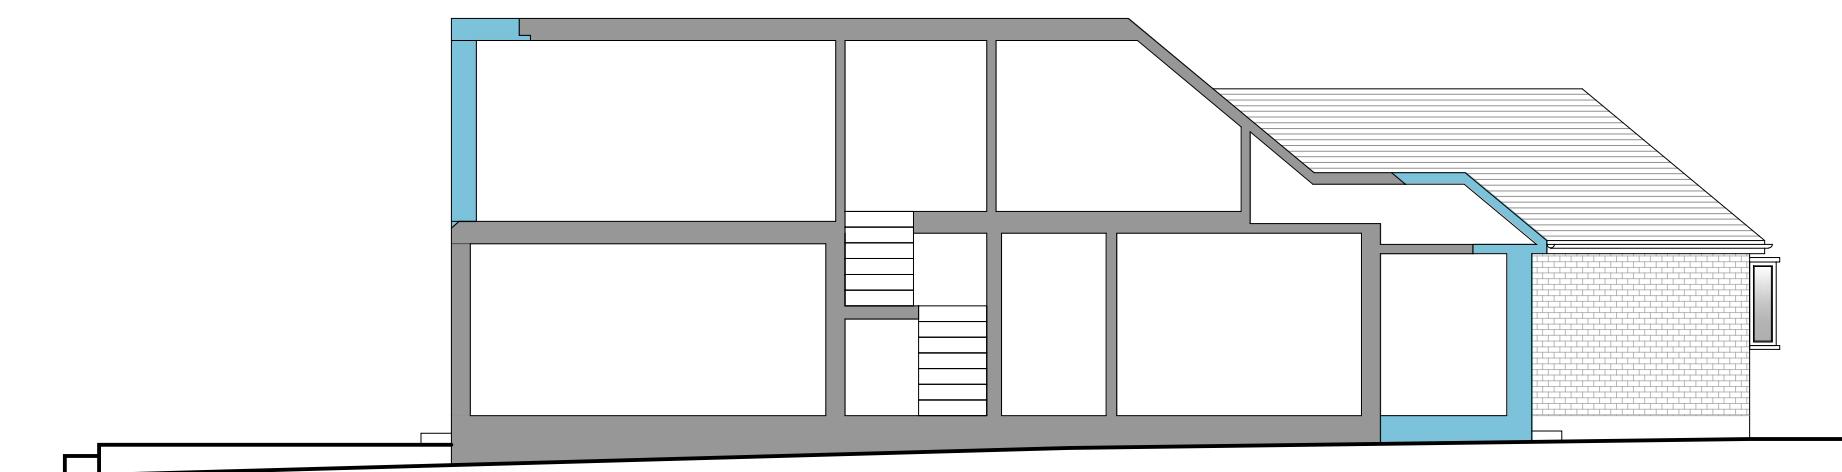

8 Existing (As-Built) Side Section

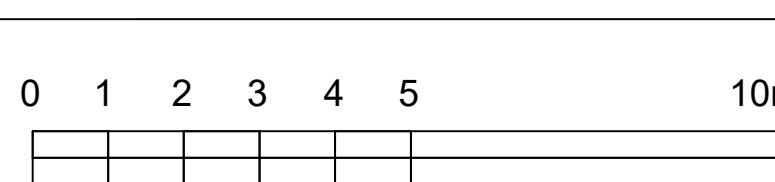

**IMPORTANT GENERAL NOTE**  
The specification is to be read in conjunction with the plans/section details, and other associated structural details as may be provided.  
All work is to be carried out to the Local Authority Planning and Building Regulations Approval, and the Codes of Practice and British Standards as necessary.  
All dimensions, levels, sizes, positions and locations of particulars as indicated on drawings are to be verified by the appointed Contractor on site prior to engaging in works. Any discrepancies must be reported to the Architect/Surveyor/Engineer or responsible person/s immediately.  
The Contractor is responsible for ensuring compliance with the CDM Regulations, and appropriate Health & Safety on site precautions.  
The Client/Building Owner must obtain any necessary PARTY WALL AGREEMENTS, prior to engaging in the works on site.

Revision	Date	Description

Page Size	Drawn By	Checked By
A3 Scale 1:100 Revision 1st	NE AP Drawing Status Planning Issue Date Sep-23	

**DontMoveExtend.com**  
Planning Permission Specialists  
Project 9 Brook Close  
Ruislip HA4 8AF  
Title Existing (As-Built)  
Elevations  
Drawing No. BC9-03-1004