



REAR DORMER FLAT ROOF RAISED  
BY 100mm ABOVE EXISTING RIDGE  
TO ACHIEVE INTERNAL HEADROOM

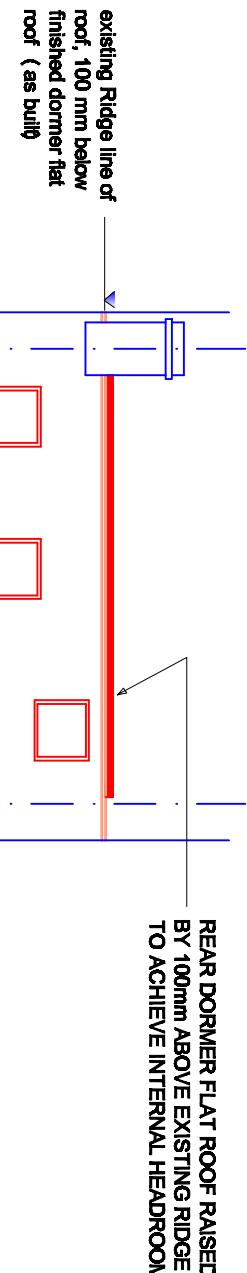

REAR DORMER FLAT ROOF RAISED  
BY 100mm ABOVE EXISTING RIDGE  
TO ACHIEVE INTERNAL HEADROOM

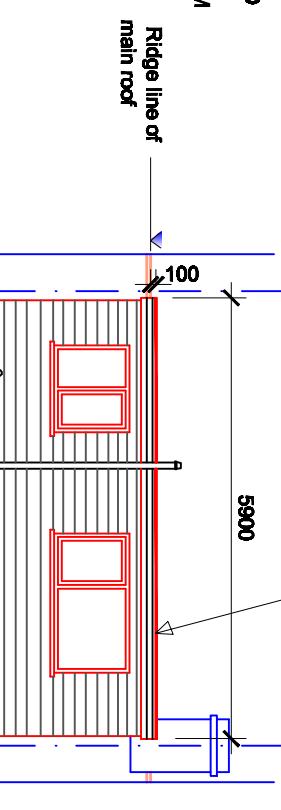

Party Wall Agreements are deemed to be the responsibility of the client. Party Wall Agreement MUST be put in place prior to commencement of works. All notices to be in accordance with The Party Wall Act 1996. A Party Wall Surveyor may be appointed.

Existing structures including walls foundations, beams and lintels carrying new altered and additional loads must be checked for its adequacy. The area must be exposed and checked and verified with the BC Officer.

The workmanship and materials must comply with the relevant British Standards, Codes of Practice, BBA certificates and relevant manufacturers instructions.

Dormer Construction with Tile Hanging. Form timber frame with 100x50mm nogging, studs, head and sole plate. Studs to be maximum 300cts and covered externally with 12mm external ply with bituminised breather paper externally. Timber frame to be insulated with 100mm celotex insulation boards. Cover internally with 12.5mm plaster board and set on polythene vapour barrier. Provide vertical tiling on 38x25mm tannalised battens on breather felt membrane fixed to external face of ply. Lead soakers to be provided at junction of roof and dormer cheeks.

#### REVISIONS

All dimensions and particulars are to be checked on site before work commences and any discrepancy to be reported to THE SURVEYOR.  
DO NOT SCALE off this drawing, use written dimensions only.

Project

PROPOSED LOFT  
CONVERSION AT NO.  
35 BERWICK AV  
HAYES, MIDDLESEX  
UB4 0NG

Drawing

PROPOSED ELEVATIONS  
(As Built)


Number

2021/JS/105


Revisions

PERMITTED DEVELOPMENT CRITERIA
All new external materials to match existing materials.
Proprietary rooflights to front roof slope not to project 150mm beyond the roof covering
No part of the New works to exceed the height of the original roof/encroach the boundaries

#### PROPOSED FRONT ELEVATION (As Built)

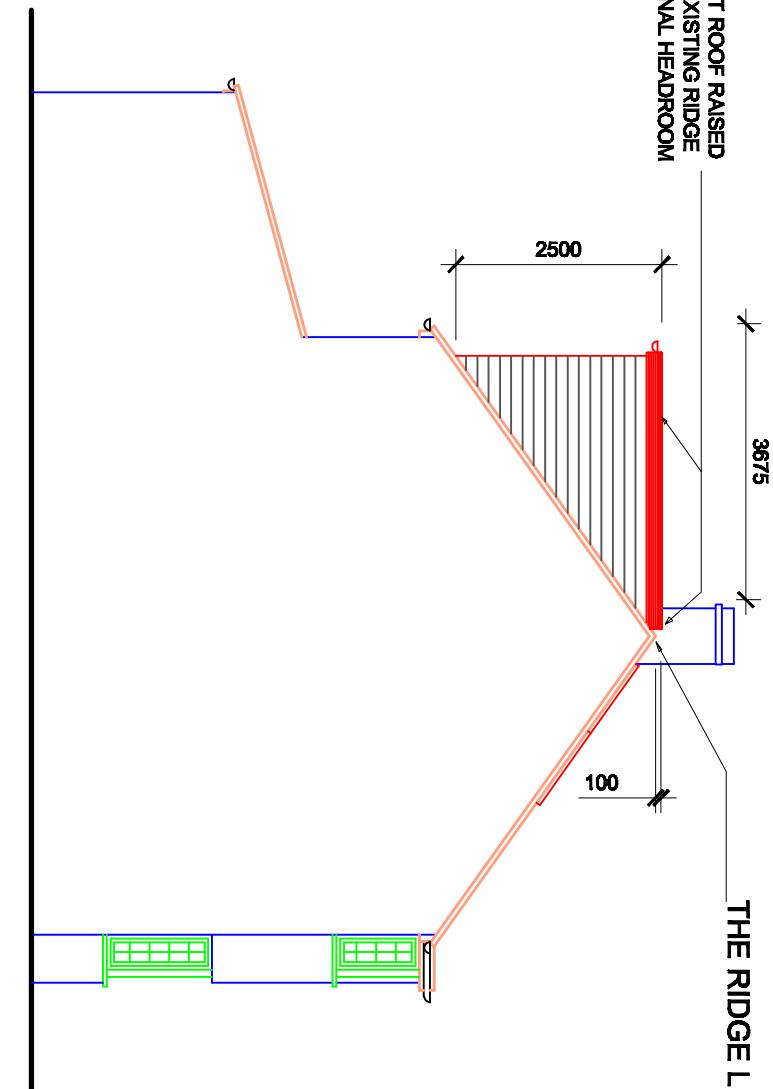

#### PROPOSED REAR ELEVATION (As Built)

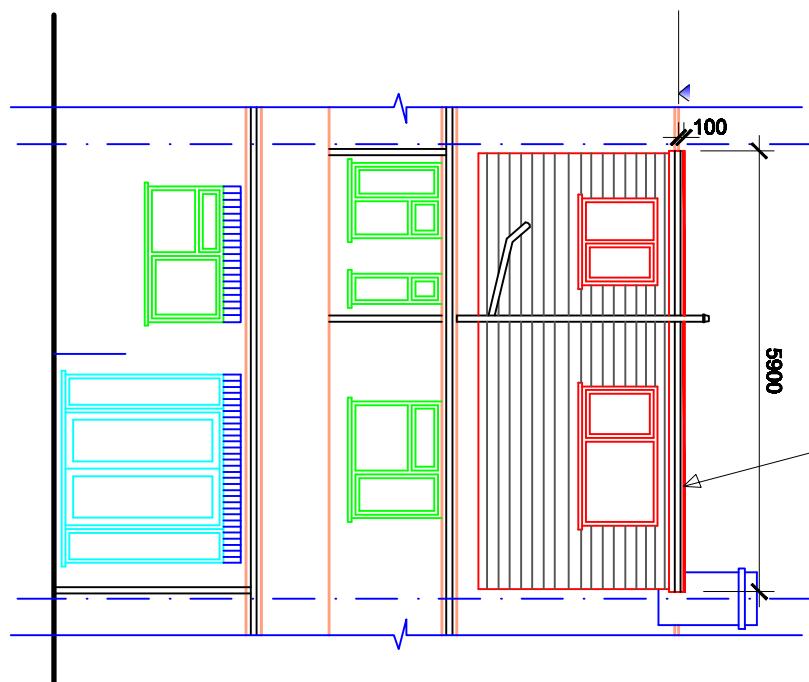

Client  
MR. JASPAL SINGH SANDHU