
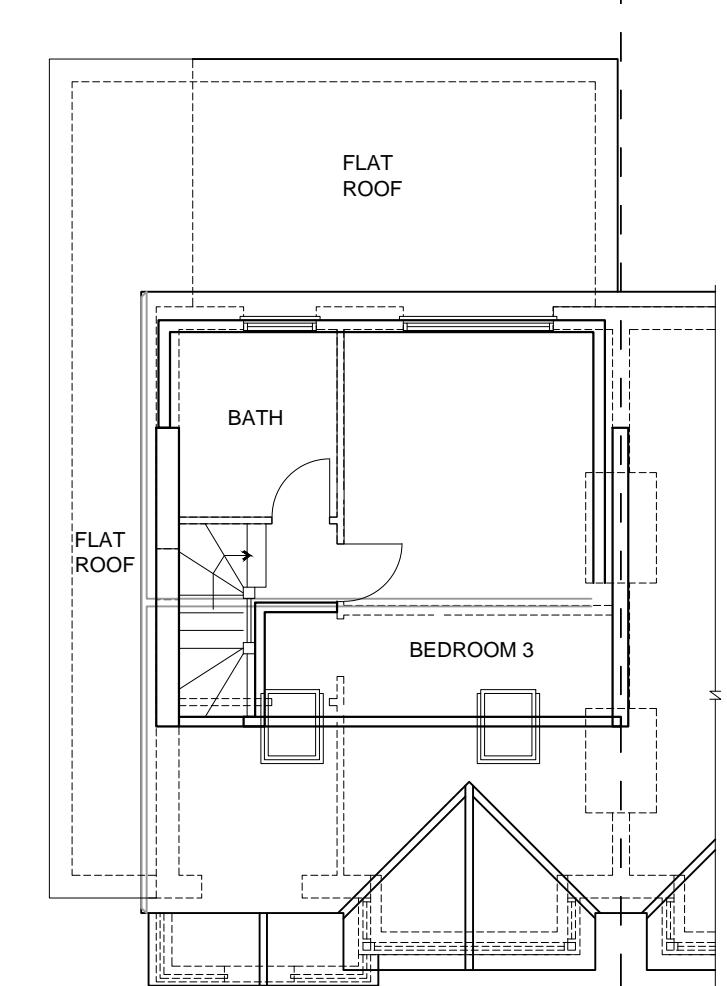
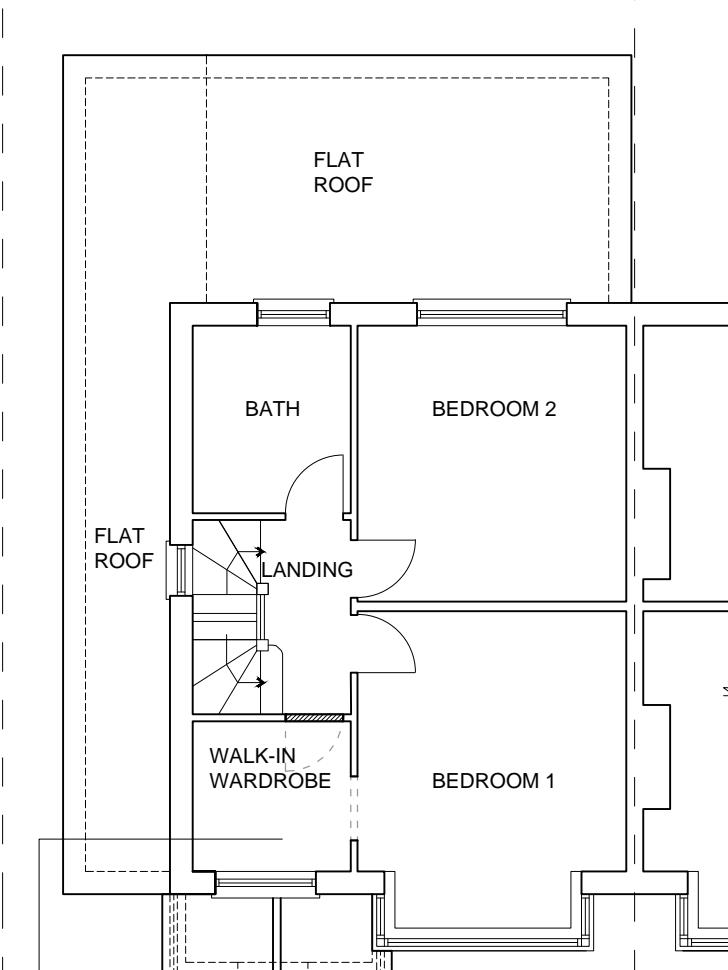


Rev.No	DATE	REV. NOTE
CAD REF		

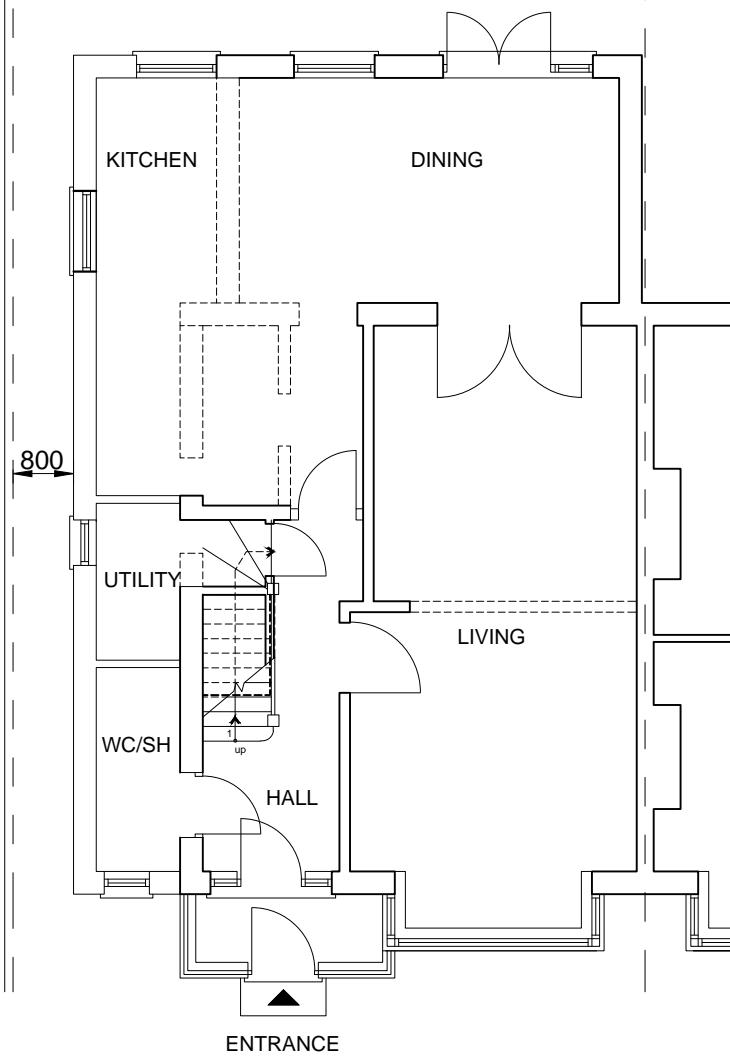

Bedroom-3 to be converted into Walk-in Wardrobe.

Project Title		
Retention of Roof Overhang and Part Outbuilding as of Approved Planning (51100/APP/2021/4128).		
Layout Name		
Proposed/As Built Floor Plans		
Client	Mr Taj Mohammad Safi	
Site	6 Siverdale Gardens, Hayes, UB3 3LN	
Drawn By	Designed By	
LT	SA	
Drawing No	Revision No	
06/SGH/011	00	
Compass	Date	Scale
	19-02-2023	1:100, 1:500
	Project No	Sheet No
		-
HEAD OFFICE : S A Design & Management Ltd saud_ahmad67@outlook.com		
Phone : 0044 7930880404		
THIS DRAWING IS A COPYRIGHT OF S A DESIGN & MANAGEMENT LTD AND DUPLICATED OR REPRODUCED WITHOUT PERMISSION FROM THE COMPANY.		

1:50 SCALE BAR 0 0.5 1 1.5 2 2.5m

1:100 SCALE BAR 0 1 2 3 4 5m

1:200 SCALE BAR 0 2 4 6 8 10m

1:500 SCALE BAR 0 5 10 15 20 25m

1:1250 SCALE BAR 0 12.5 25 37.5 50 62.5m