


Rev. No	DATE	REV. NOTE
CAD REF		


All external materials matching to existing.




PRE-EXISTING SIDE ELEVATION

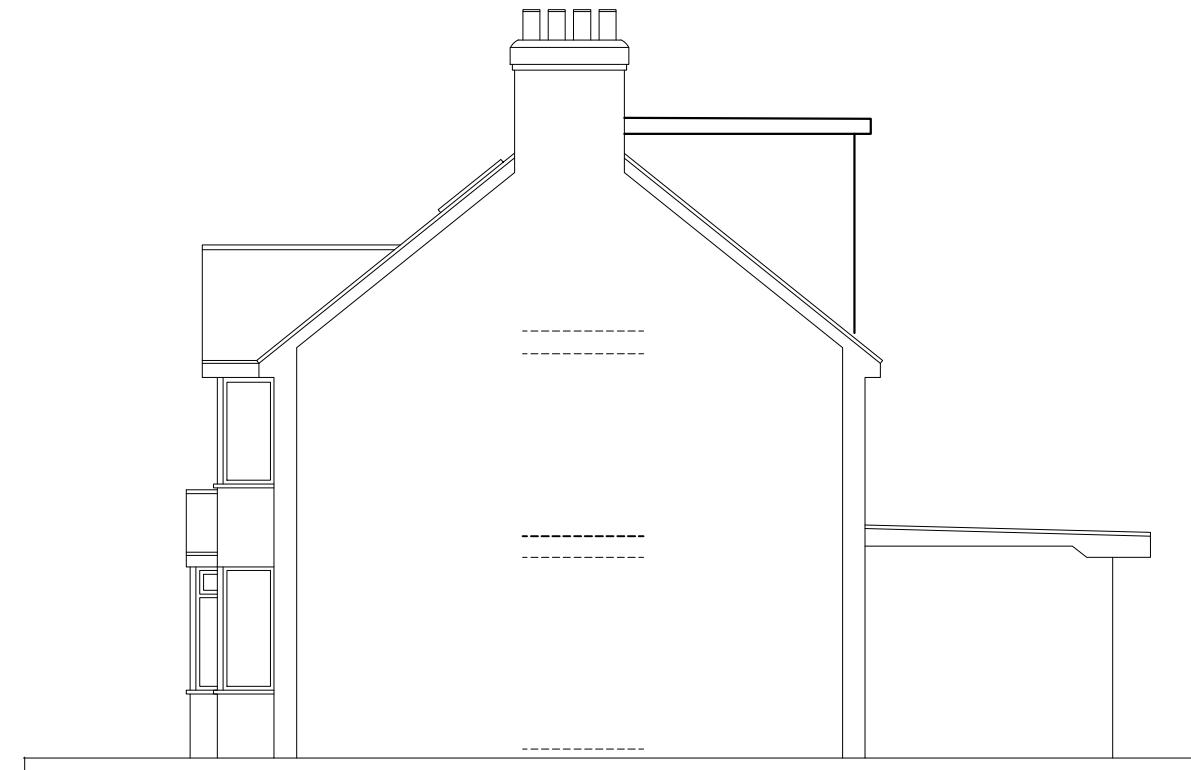

PRE-EXISTING SIDE ELEVATION

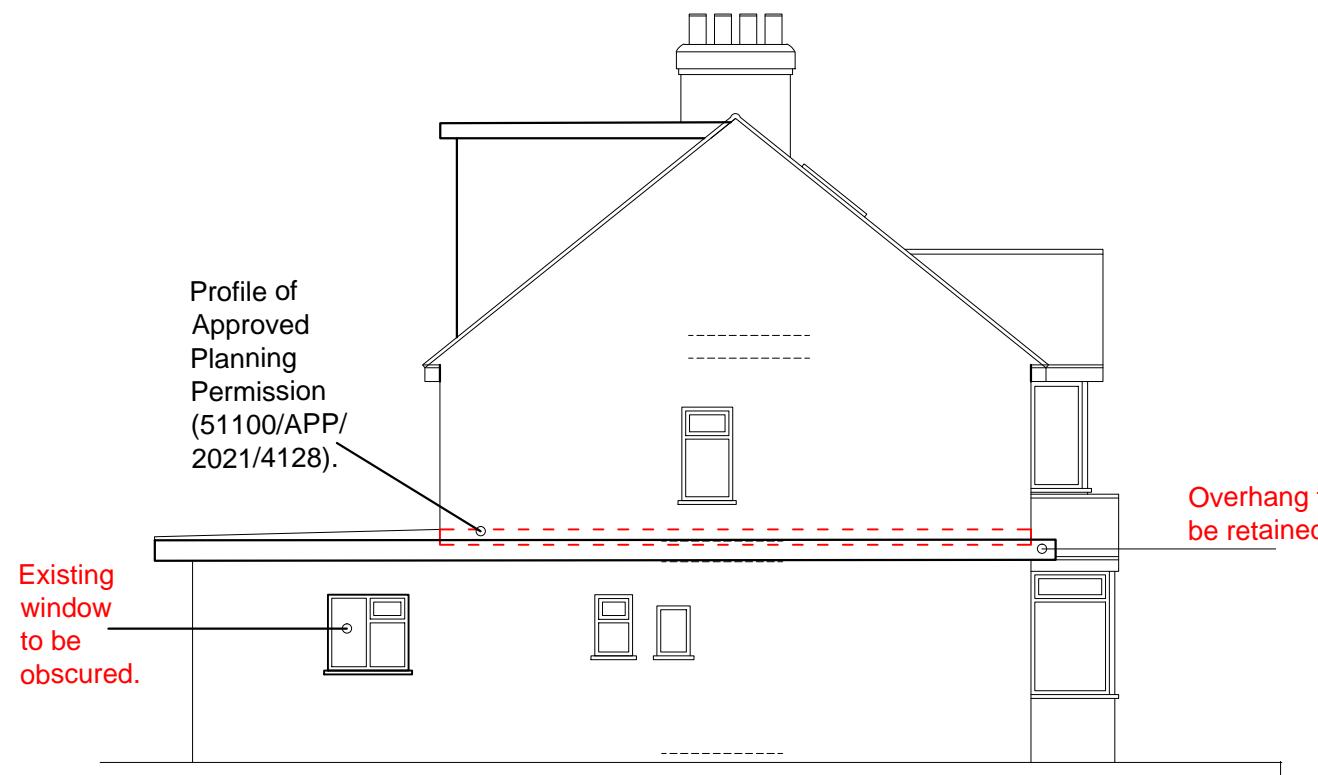

AS BUILT/PROPOSED SIDE ELEVATION

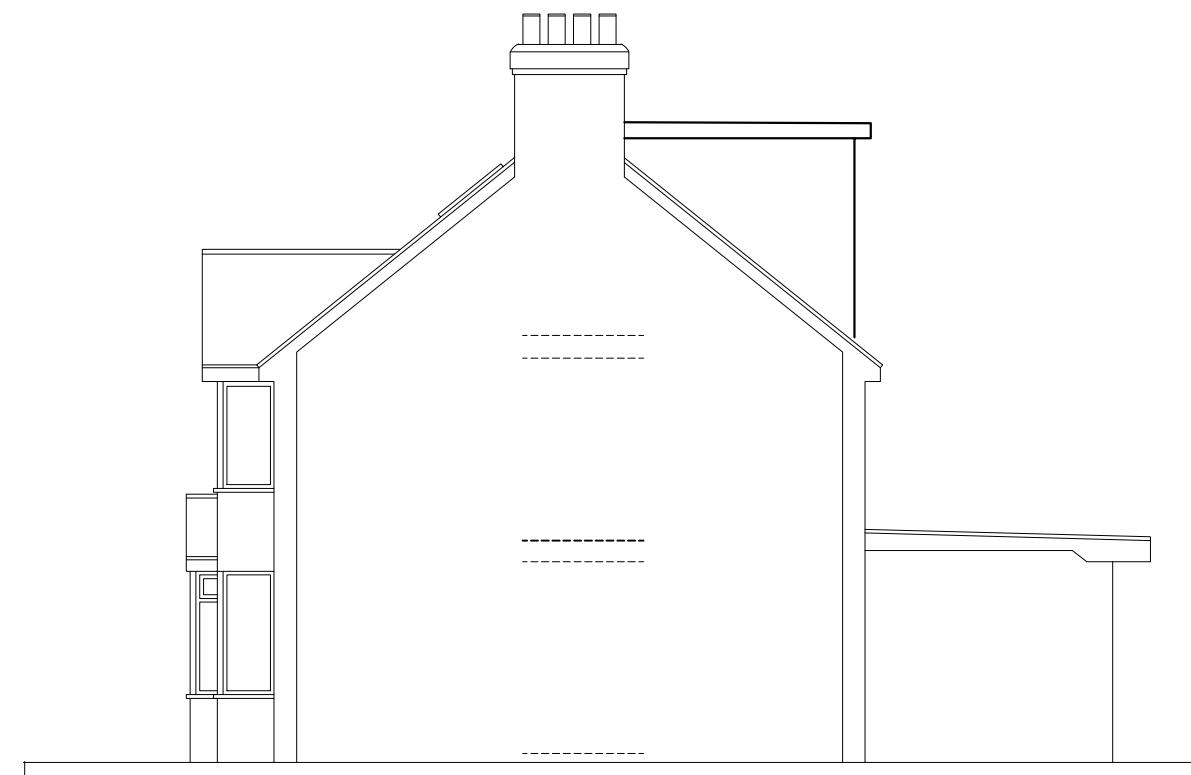

AS BUILT/PROPOSED SIDE ELEVATION

Project Title		
Retention of Roof Overhang and Part Outbuilding as of Approved Planning (51100/APP/2021/4128).		
Layout Name		
Client	Proposed Block Plan	Mr Taj Mohammad Safi
Site		6 Siverdale Gardens, Hayes, UB3 3LN
Drawn By	Designed By	
LT	SA	
Drawing No	Revision No	
06/SG/022	00	
Compass	Date	Scale
	19-02-2023	1:100, 1:500
	Project No	Sheet No
		-

HEAD OFFICE :  
S A Design & Management Ltd  
saud\_ahmad67@outlook.com

Phone :  
0044 7930880404

THIS DRAWING IS A COPYRIGHT OF S A DESIGN & MANAGEMENT LTD AND  
MUST NOT BE  
DUPLICATED OR REPRODUCED WITHOUT PERMISSION FROM THE COMPANY.