

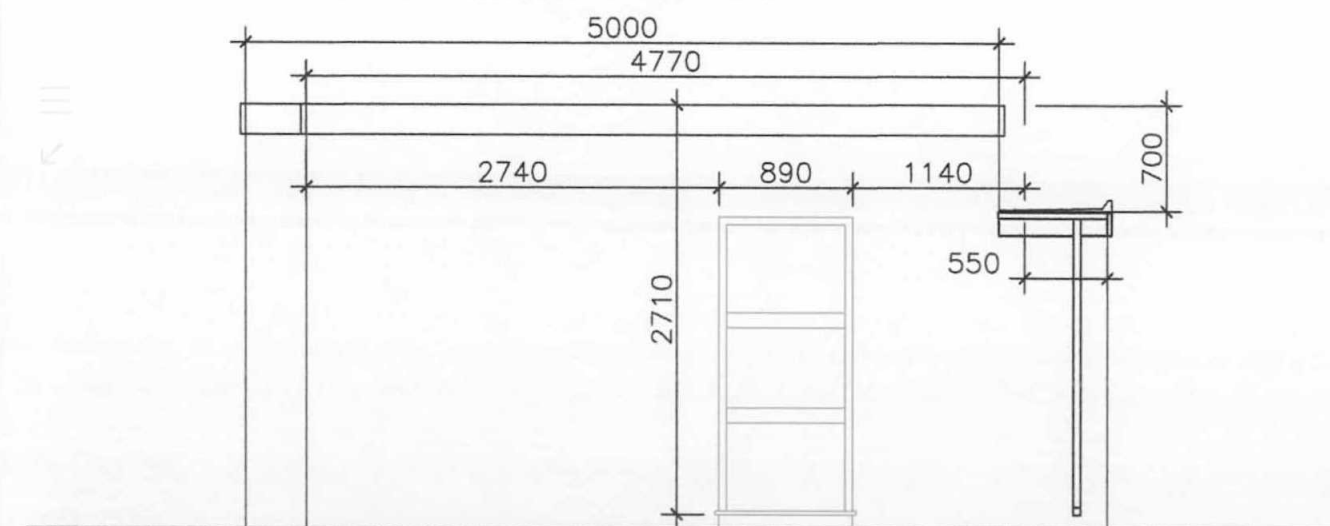
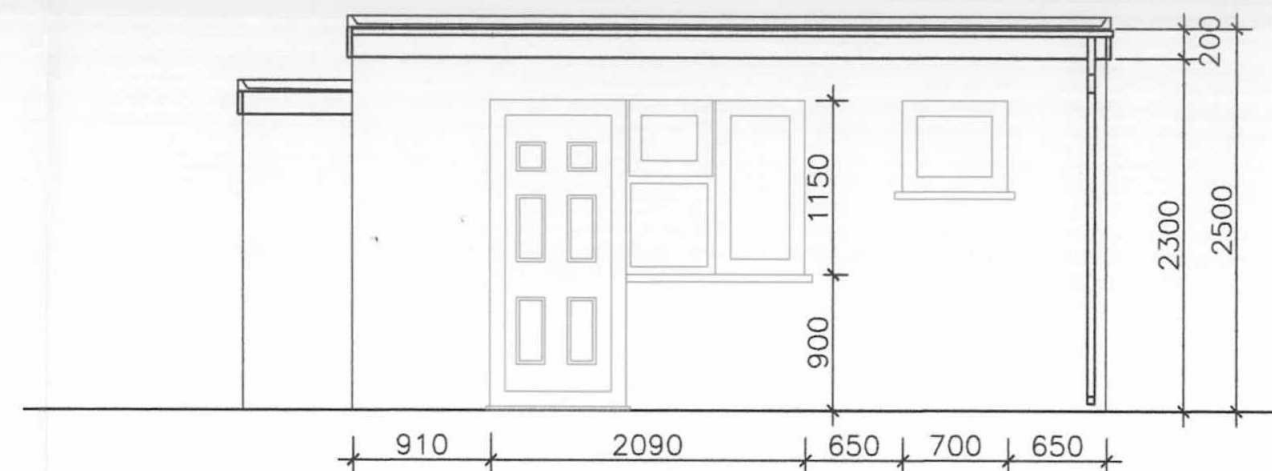


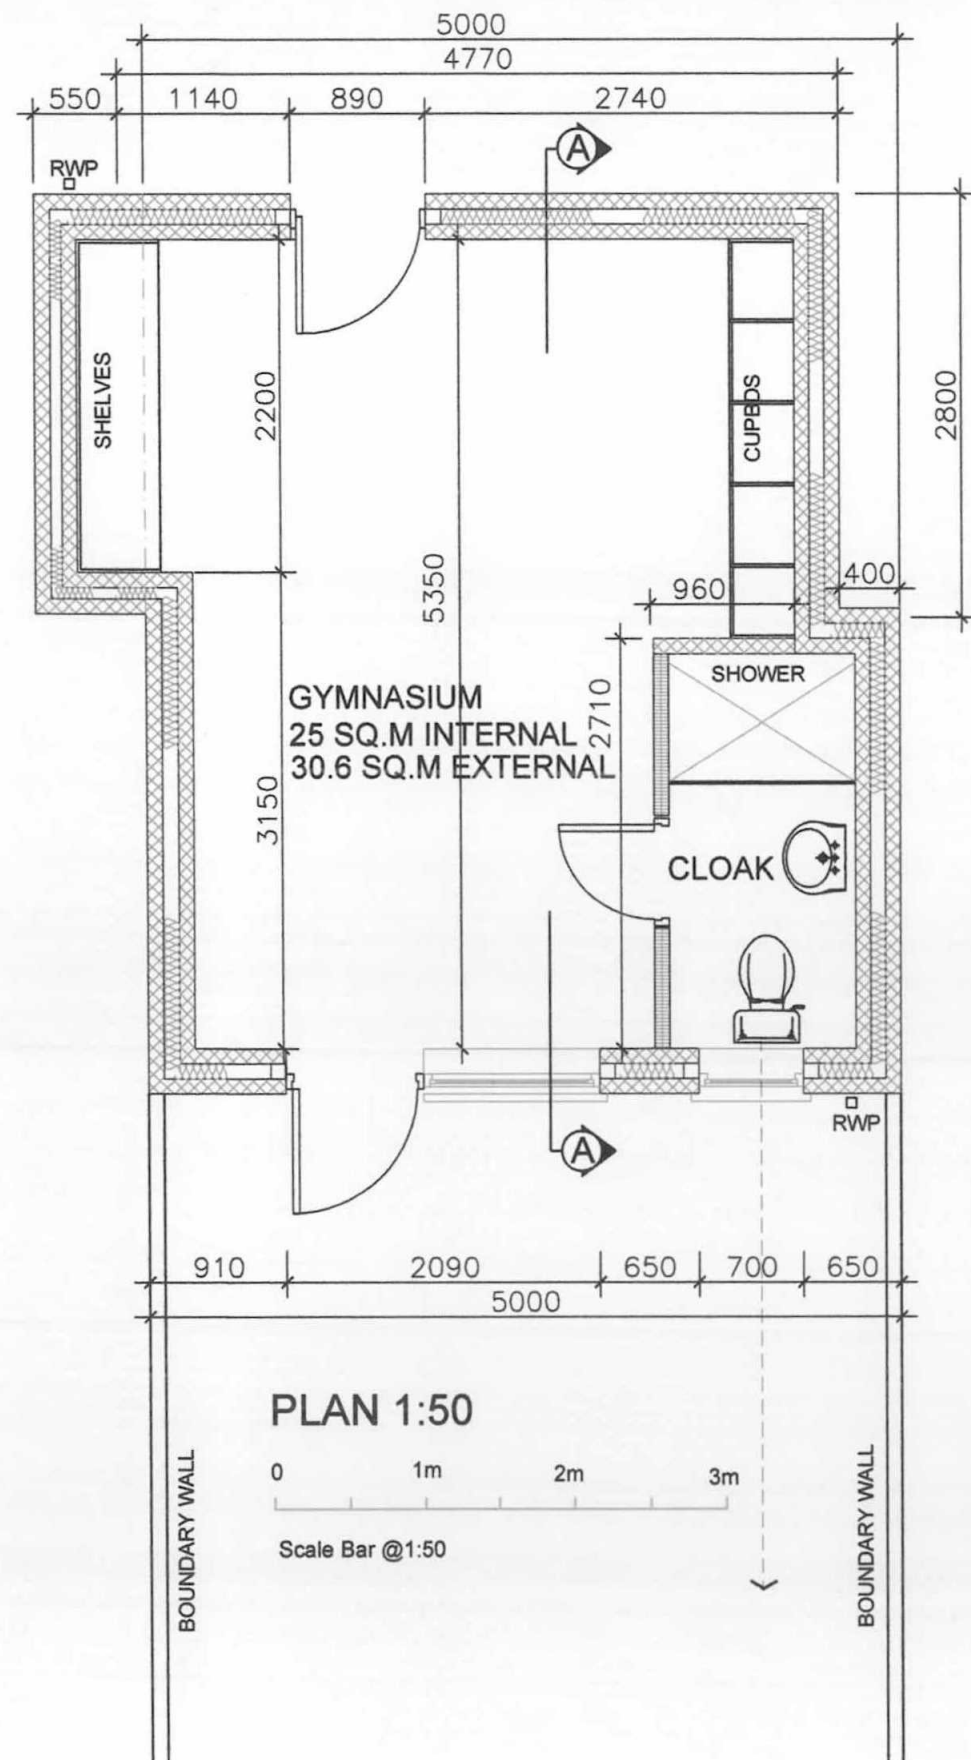

MATERIALS:

- ROOF:** 2 LAYERS FELT ROOF ON 18mm WBPLYWOOD ON 200X50 TIMBER JOISTS @350 CENTRES ON METAL HANGERS
- WALLS:** 100 MM BLOCKS OUTER LEAF WITH 100MM CAVITY INSULATED AND 100MM INNER BLOCKS LEAF. OUTER LEAF RENDERED & DECORATED WITH WHITE PAINT
- WINDOWS:** UPVC WHITE DOUBLE GLAZED
- DOORS:** UPVC WHITE DOUBLE GLAZED
- RWP'S** GUTTERS AND DOWNPIPES WHITE PVC
- FOOTINGS:** 1000X600 DEEP CONCRETE FOUNDATIONS

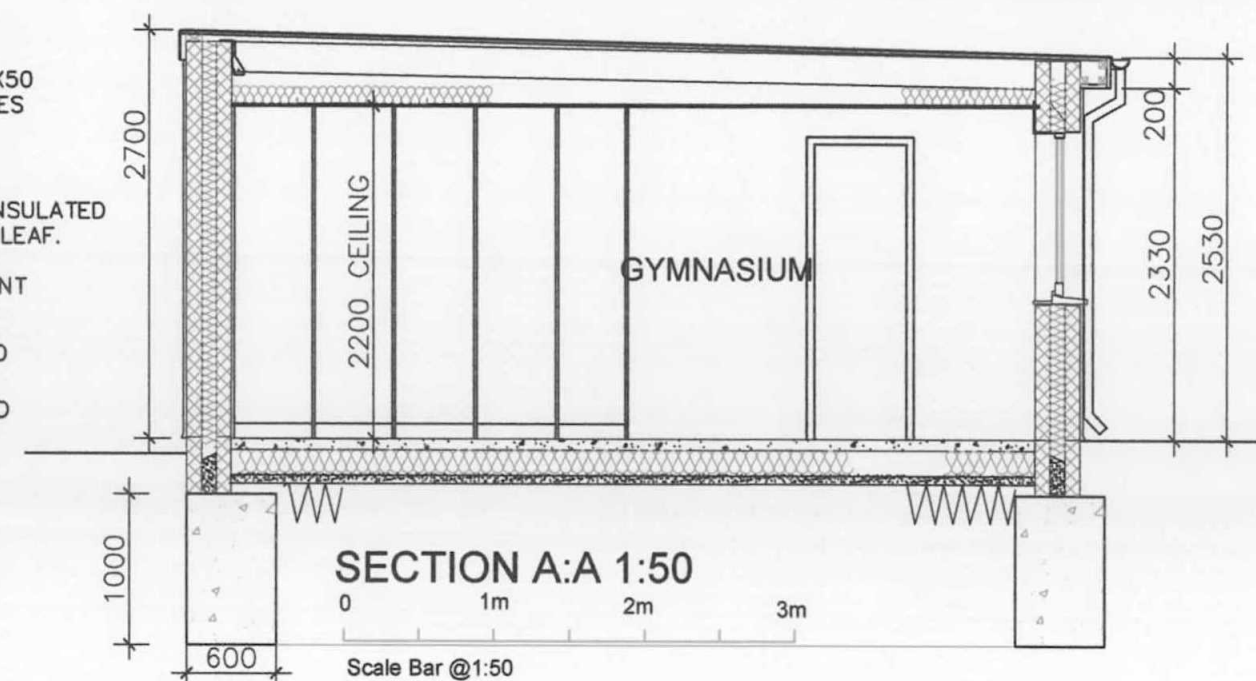

client

Mr. Baljinder Singh Dhesi
Mrs. Navdisha Kaur Dhesi
22 Portland Road
Hayes
Middlesex
UB4 8LG

notes

The contractor is responsible for checking dimensions, tolerances and references. Verify any discrepancies with the Architect before proceeding with the works. Where an item is covered by drawings to different scales the larger scale drawing is to be worked to. Do not scale drawing. Figured dimensions to be worked to in all cases.

project

**RESTROSPECTIVE PLANNING APPLICATION FOR 'AS BUILT' OUTBUILDING
AT 22 PORTLAND ROAD, HAYES, MIDDLESEX, UB4 8LG**

revisions

drawn RP
scale 1:50@A3
date 28-05-2016
revision no

drawing no

RP501PLANNING