


GENERAL NOTES:

- DO NOT SCALE - WORK ONLY TO SHOWN DIMENSIONS.
- ALL DIMENSIONS ARE IN MILLMETRES. ALL LEVELS AND CO-ORDINATES ARE IN METRES.
- ALL DIMENSIONS ARE TO BE CHECKED ON SITE.
- THIS DRAWING IS TO BE READ IN CONJUNCTION WITH ALL RELEVANT DRAWINGS AND SPECIFICATIONS.
- * = OBSCURE GLASS

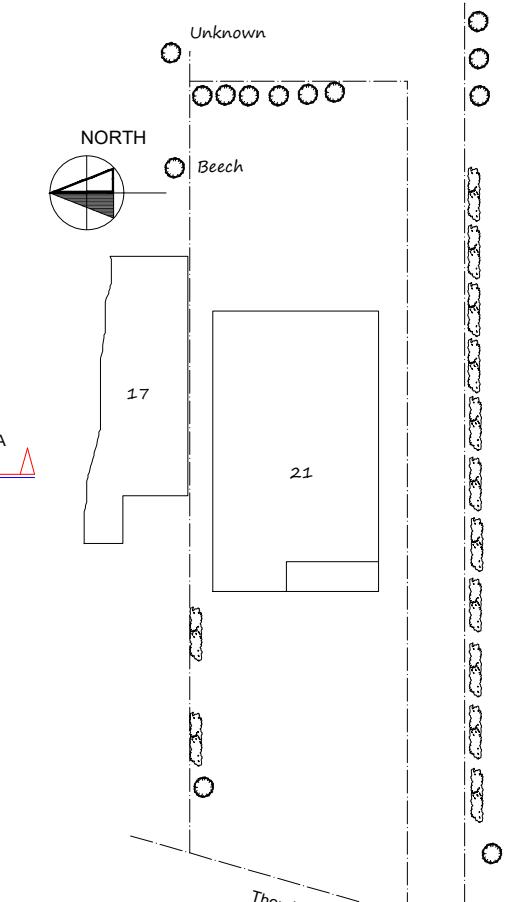

B	27.06.2022	FOR PLANNING
A	15.04.2022	FOR INFORMATION
REV: DATE: DESCRIPTION:		
DRAWING STATUS:		
INFORMATION		
CLIENT NAME : Mr Steve Evans & Mrs Sue Pierpoint		
LOCATION : 21 THORNHILL ROAD ICKENHAM		
LOCATION		
DRAWING TITLE: Existing 'As Builts'		
DRAWN BY: M.D.H.		CHECKED BY: S.E.
DATE: 15.04.2022		SCALE: 1:100,200,500@A3
JOB NO: 126	DRAWING NO: 002	REV: B