



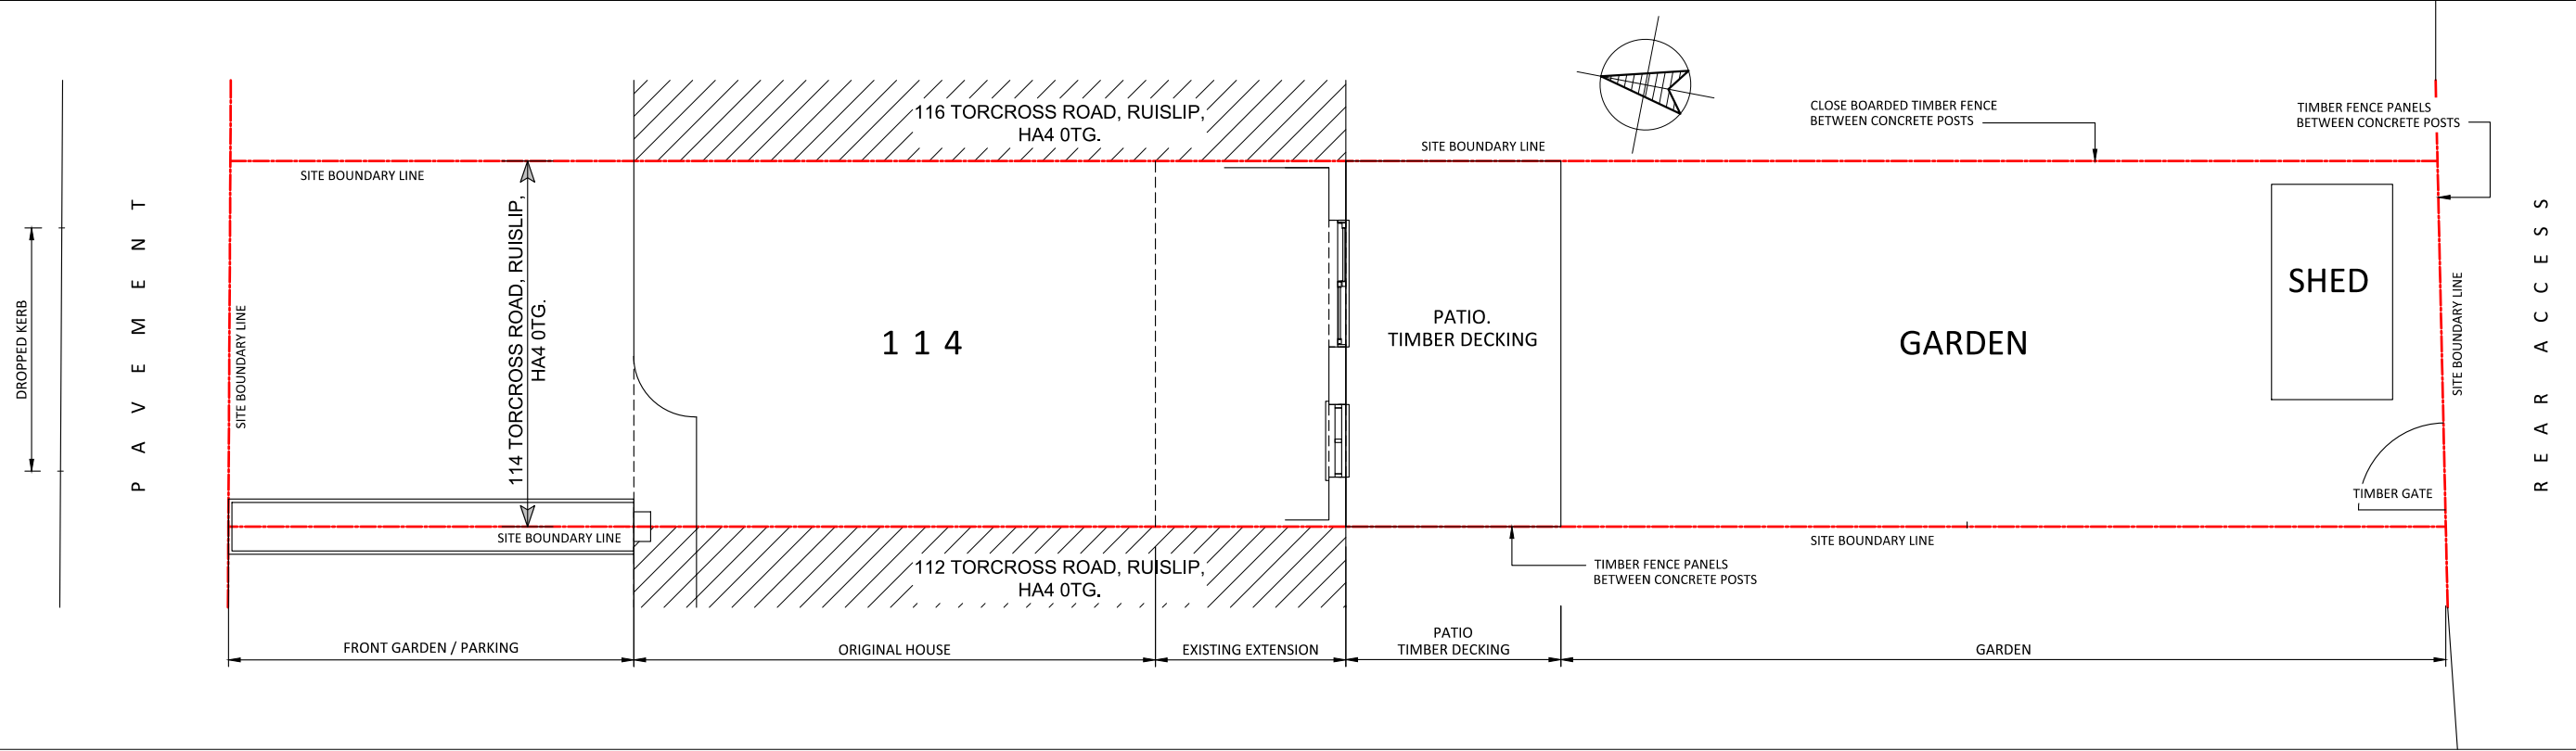

EXISTING SITE LAYOUT.
SCALE 1:100 @ A3.

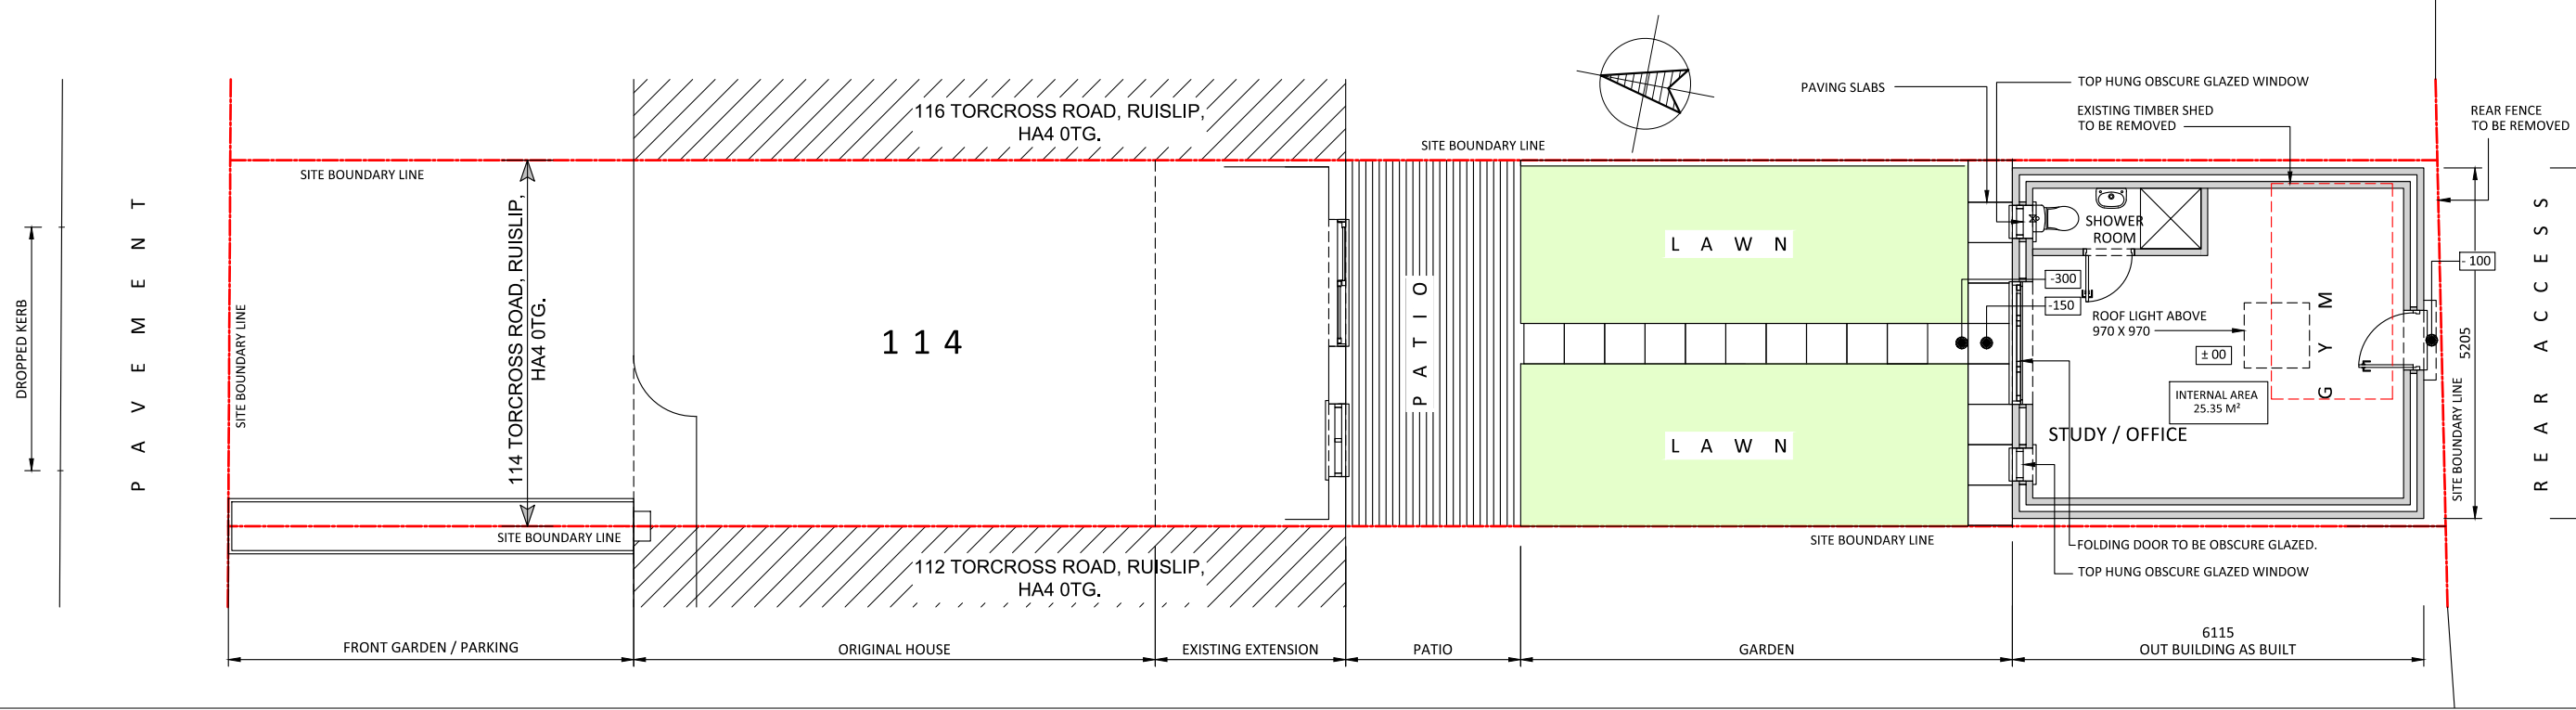


AS BUILT SITE LAYOUT.
SCALE 1:100 @ A3.

1. This Drawing has been drawn to scale, as shown, for the purpose of obtaining local authority approval only.
2. Client / owner to employ principal designer and principal contractor to manage the project.
3. Do not scale this drawing. Verify all dimensions & setting out point on site.




REVISIONS:


Drawing Title: EXISTING & AS BUILT SITE LAYOUTS.
Property Address: 114 TORCROSS ROAD, RUISLIP, HA4 0TG.
Date: JUNE 2026
Scale @ A3: 1:100
Drawing Number: SC 26100 / TR / PP10

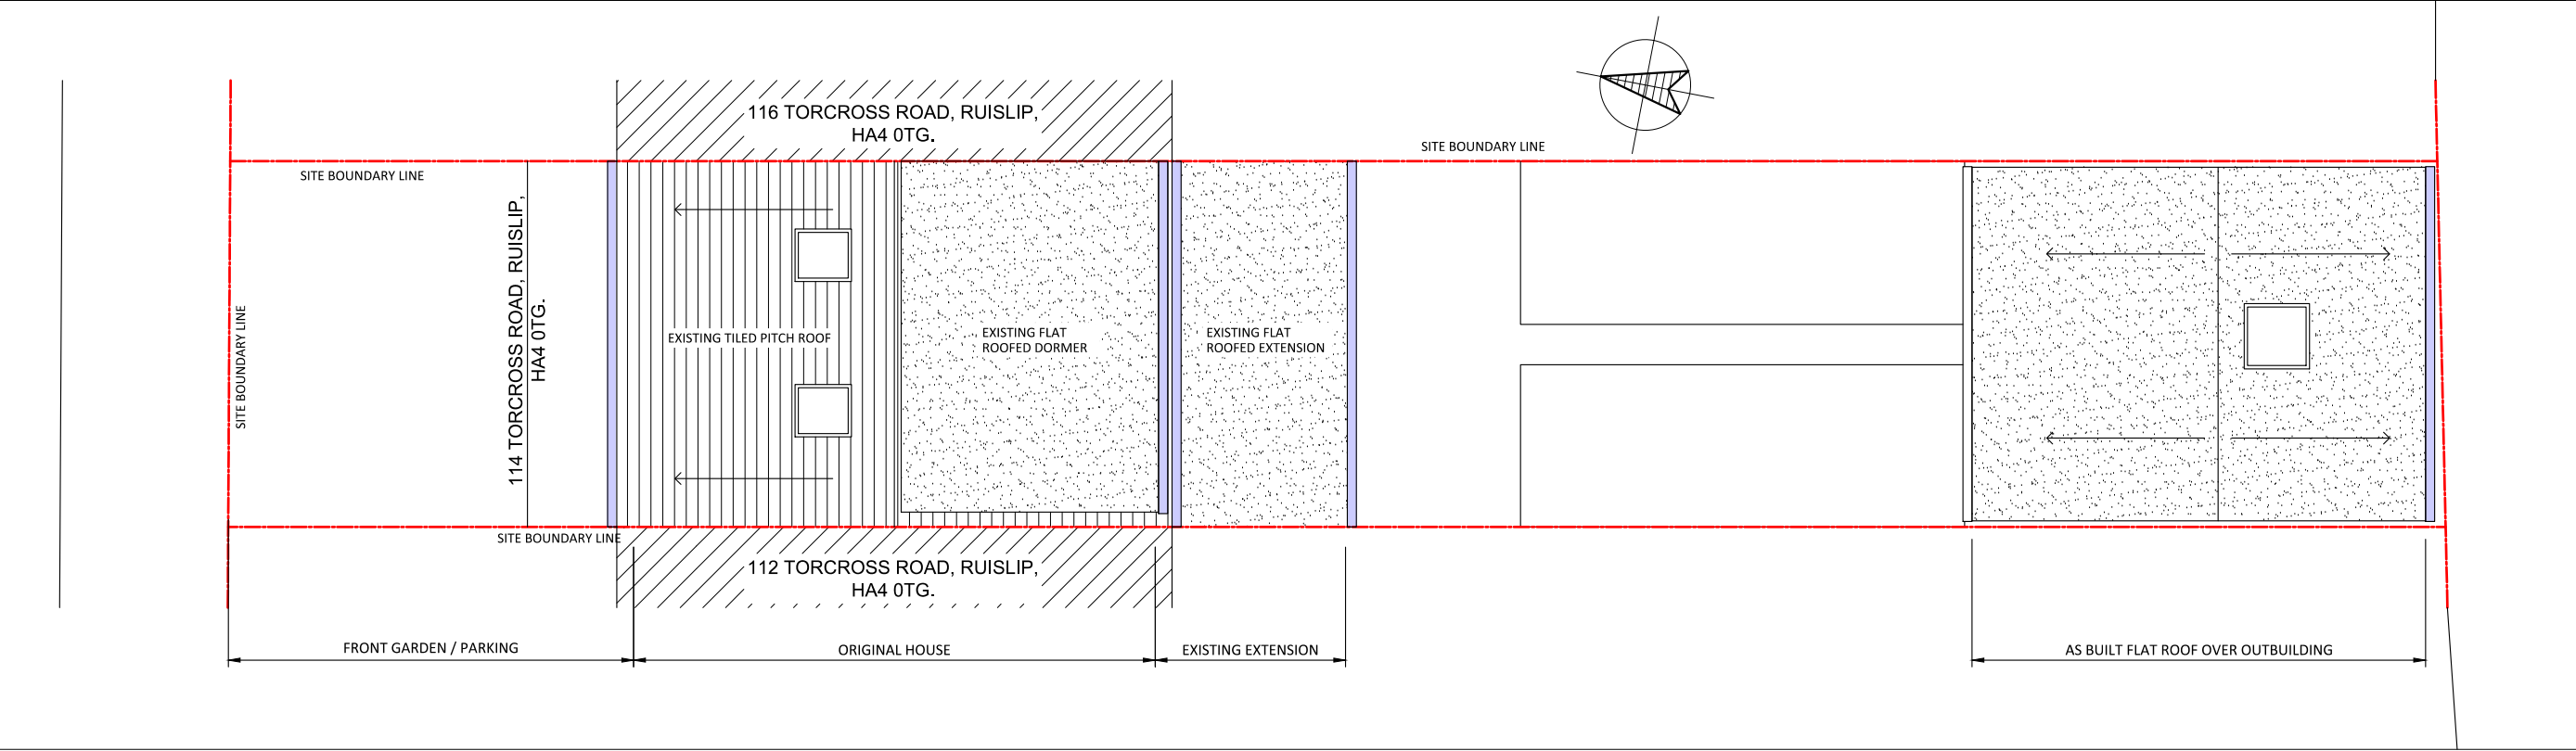


SITE LAYOUT (SHOWING EXISTING & AS BUILD FLAT ROOF OVER OUTBUILDING)
SCALE 1:100 @ A3.

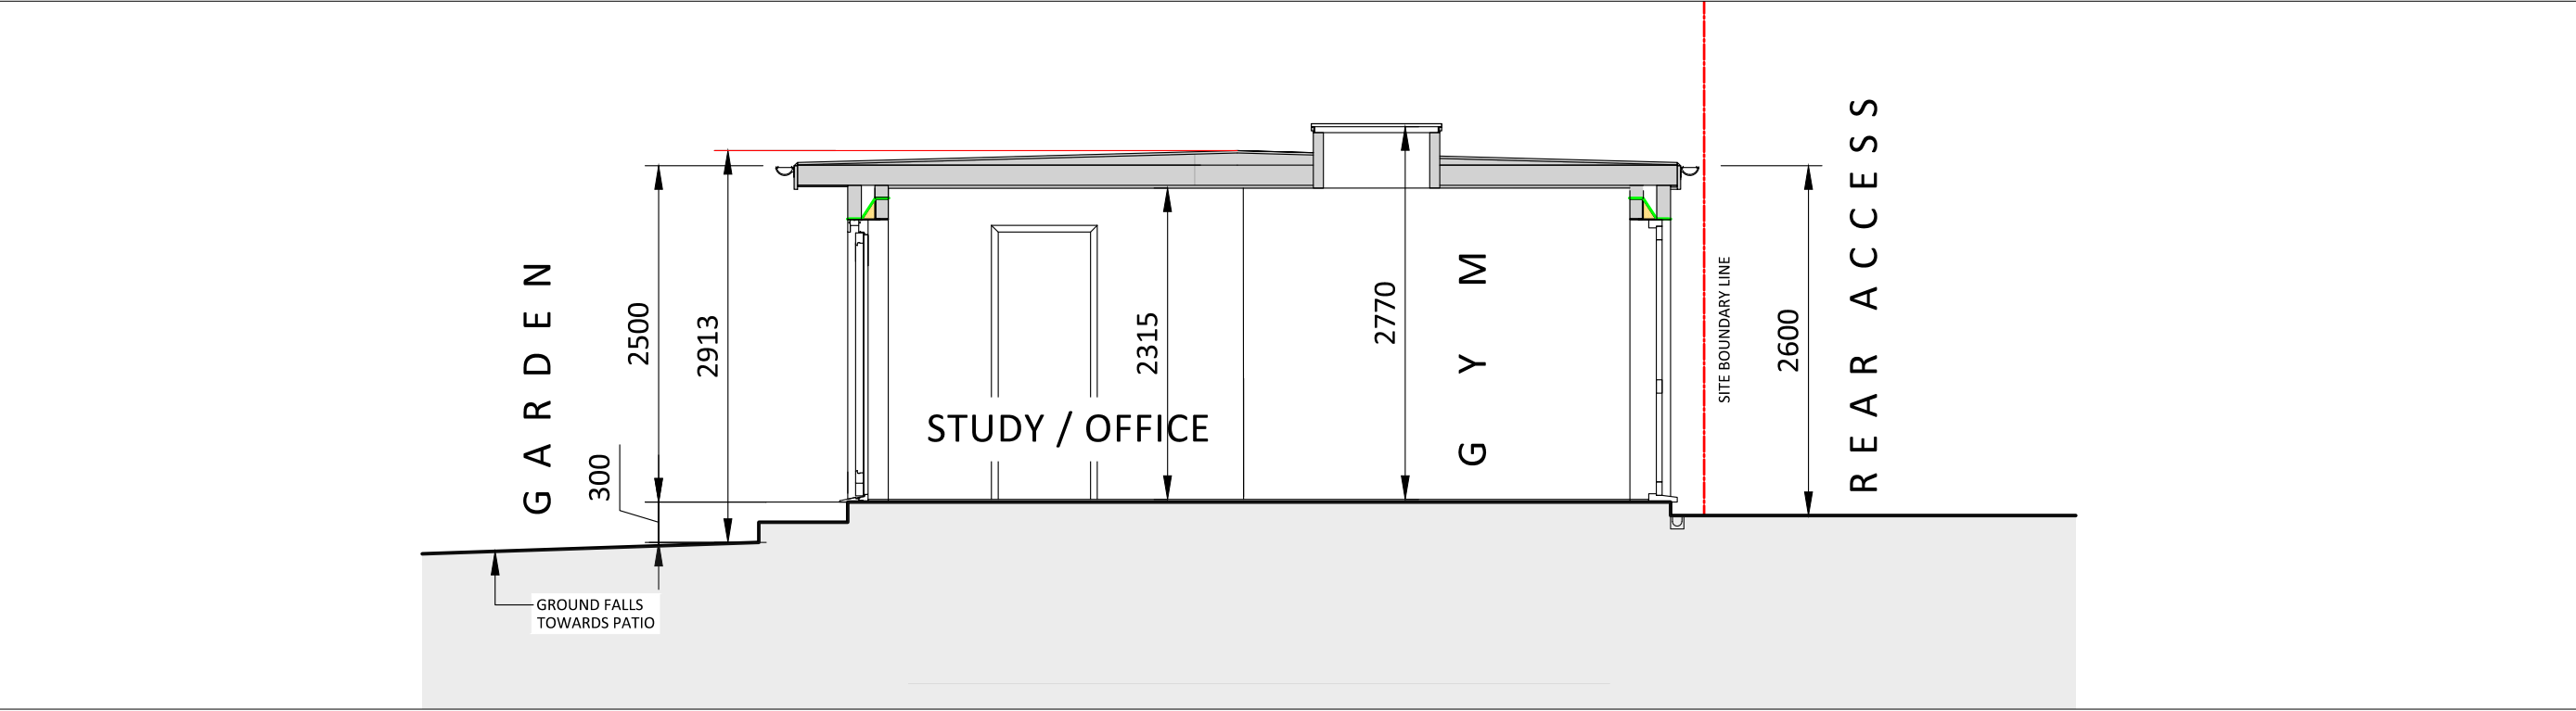

AS BUILT SECTION. 1:50 @ A3
SCALE 1:50 @ A3.

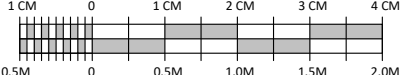


1. This Drawing has been drawn to scale, as shown, for the purpose of obtaining local authority approval only.
2. Client / owner to employ principal designer and principal contractor to manage the project.
3. Do not scale this drawing. Verify all dimensions & setting out point on site.

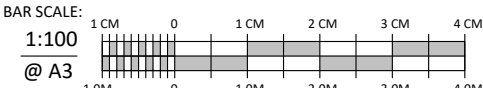


REVISIONS:

Drawing Title: EXISTING ROOF AS BUILT ROOF & SECTION.
Property Address: 114 TORCROSS ROAD, RUISLIP, HA4 0TG.
Date: JUNE 2026
Scale @ A3: 1:50 & 1:100
Drawing Number: SC 26100 / TR / PP11


AS BUILT ELEVATION (OUT BUILDING)
SCALE 1:100 @ A3.

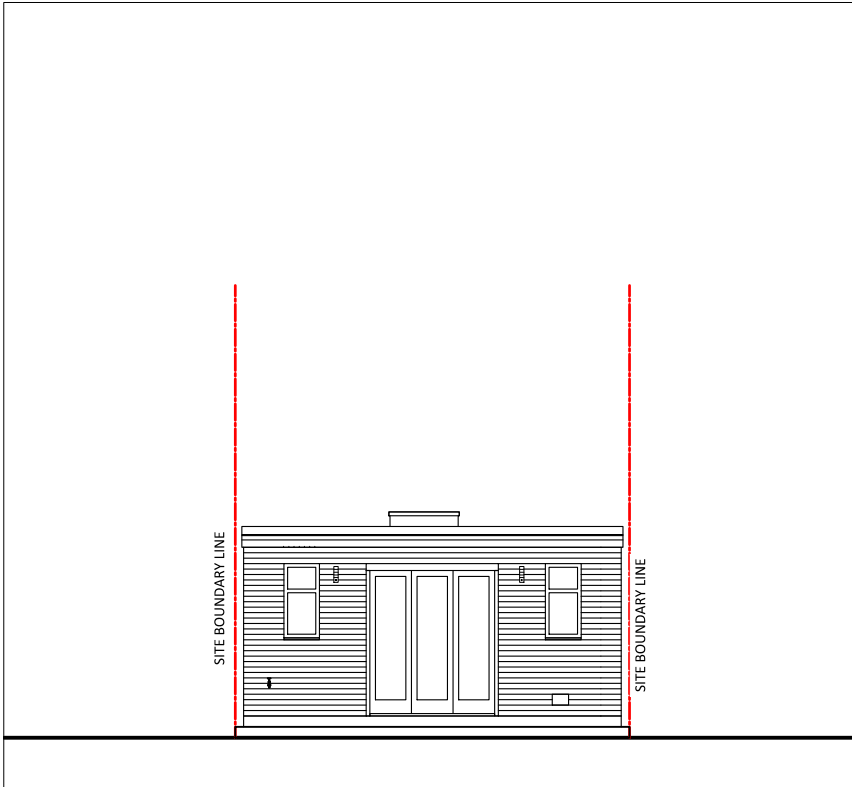


FRONT ELEVATION (OUT BUILDING)
SCALE 1:100 @ A3.

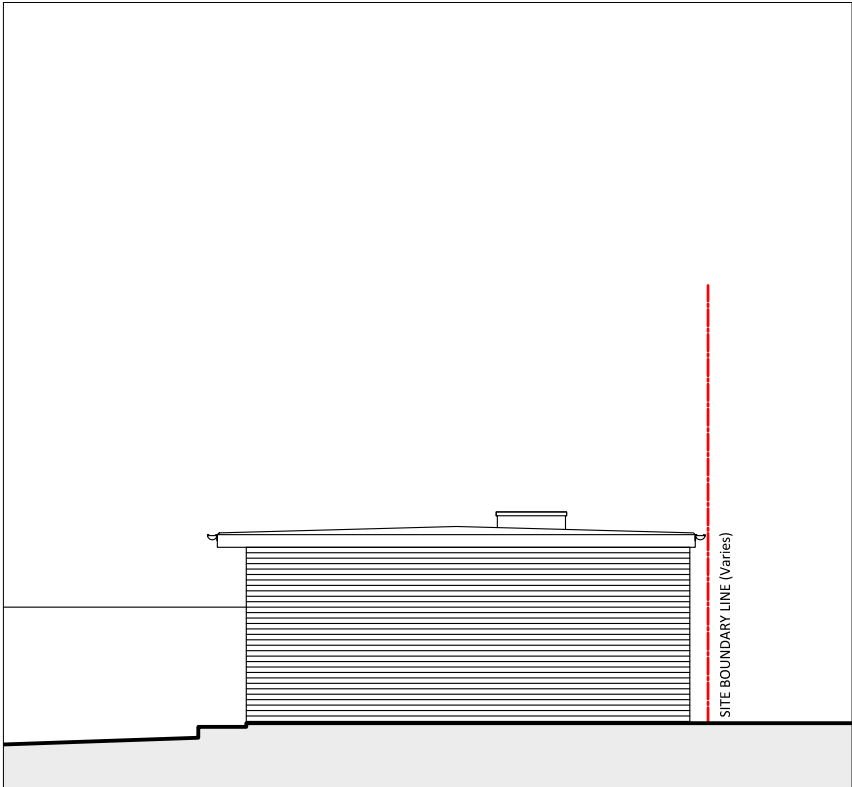

SIDE ELEVATION 1 (OUT BUILDING)
SCALE 1:100 @ A3.

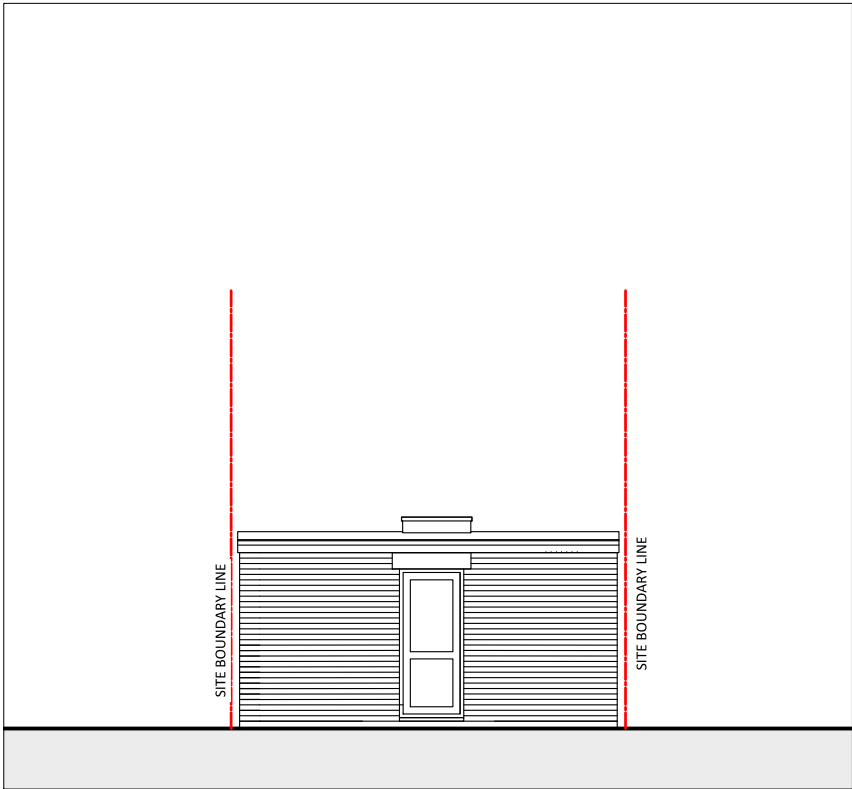


REAR ELEVATION (OUT BUILDING)
SCALE 1:100 @ A3.

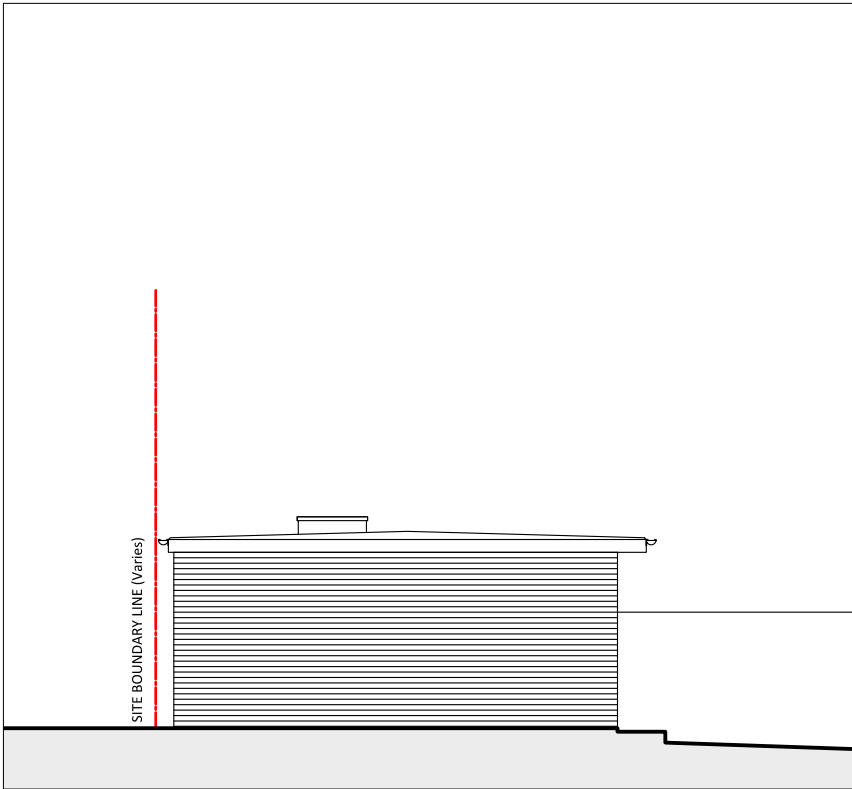

SIDE ELEVATION 2 (OUT BUILDING)
SCALE 1:100 @ A3.

1. This Drawing has been drawn to scale, as shown, for the purpose of obtaining local authority approval only.
2. Client / owner to employ principal designer and principal contractor to manage the project.
3. Do not scale this drawing. Verify all dimensions & setting out point on site.

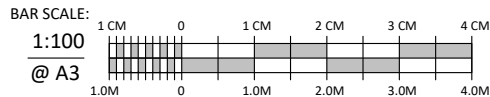

REVISIONS:

Drawing Title: AS BUILD FRONT, SIDES & REAR ELEVATIONS.
Property Address: 114 TORCROSS ROAD, RUISLIP, HA4 0TG.
Date: JUNE 2026
Scale @ A3: 1:100
Drawing Number: SC 26100 / TR / PP12