



**BLUE ARCHITECTURE LIMITED**  
Consulting Architects, Engineers and Interiors.  
102 Dorchester Way, Hayes, Middlesex,  
UB4 0HY, London.

Contact:  
Email: rabinkhadka@hotmail.co.uk,  
Cell: 044 + 078 3293 8374  
Web site: www.bluearcdesign.co.uk

Notes:  
© 2023 Blue Architecture Limited.  
All rights reserved.  
All drawings are for the purpose of gaining  
Planning Permission approval only.  
All written dimensions to be taken in  
preferences to scaled dimensions.

Rev.	Description	By	Ckd	Date

Client:  
**Mr. Sanjib Sharma.**

**Project:**  
Retrospective planning approval for as build  
Front porch Extension.

**Location:**  
10 Thornhill Road, Ickenham,  
Middlesex, UB10 8SF .



**Status:**  
PLANNING

**Title:**  
Existing / Proposed floor Plans.

Drawn by: L.p Str. Efr. Checked by: R.k

Project no: BAL-1664 Sheet Size A3 Sheet no.

Date: 09/03/2023 Scale: 1:100

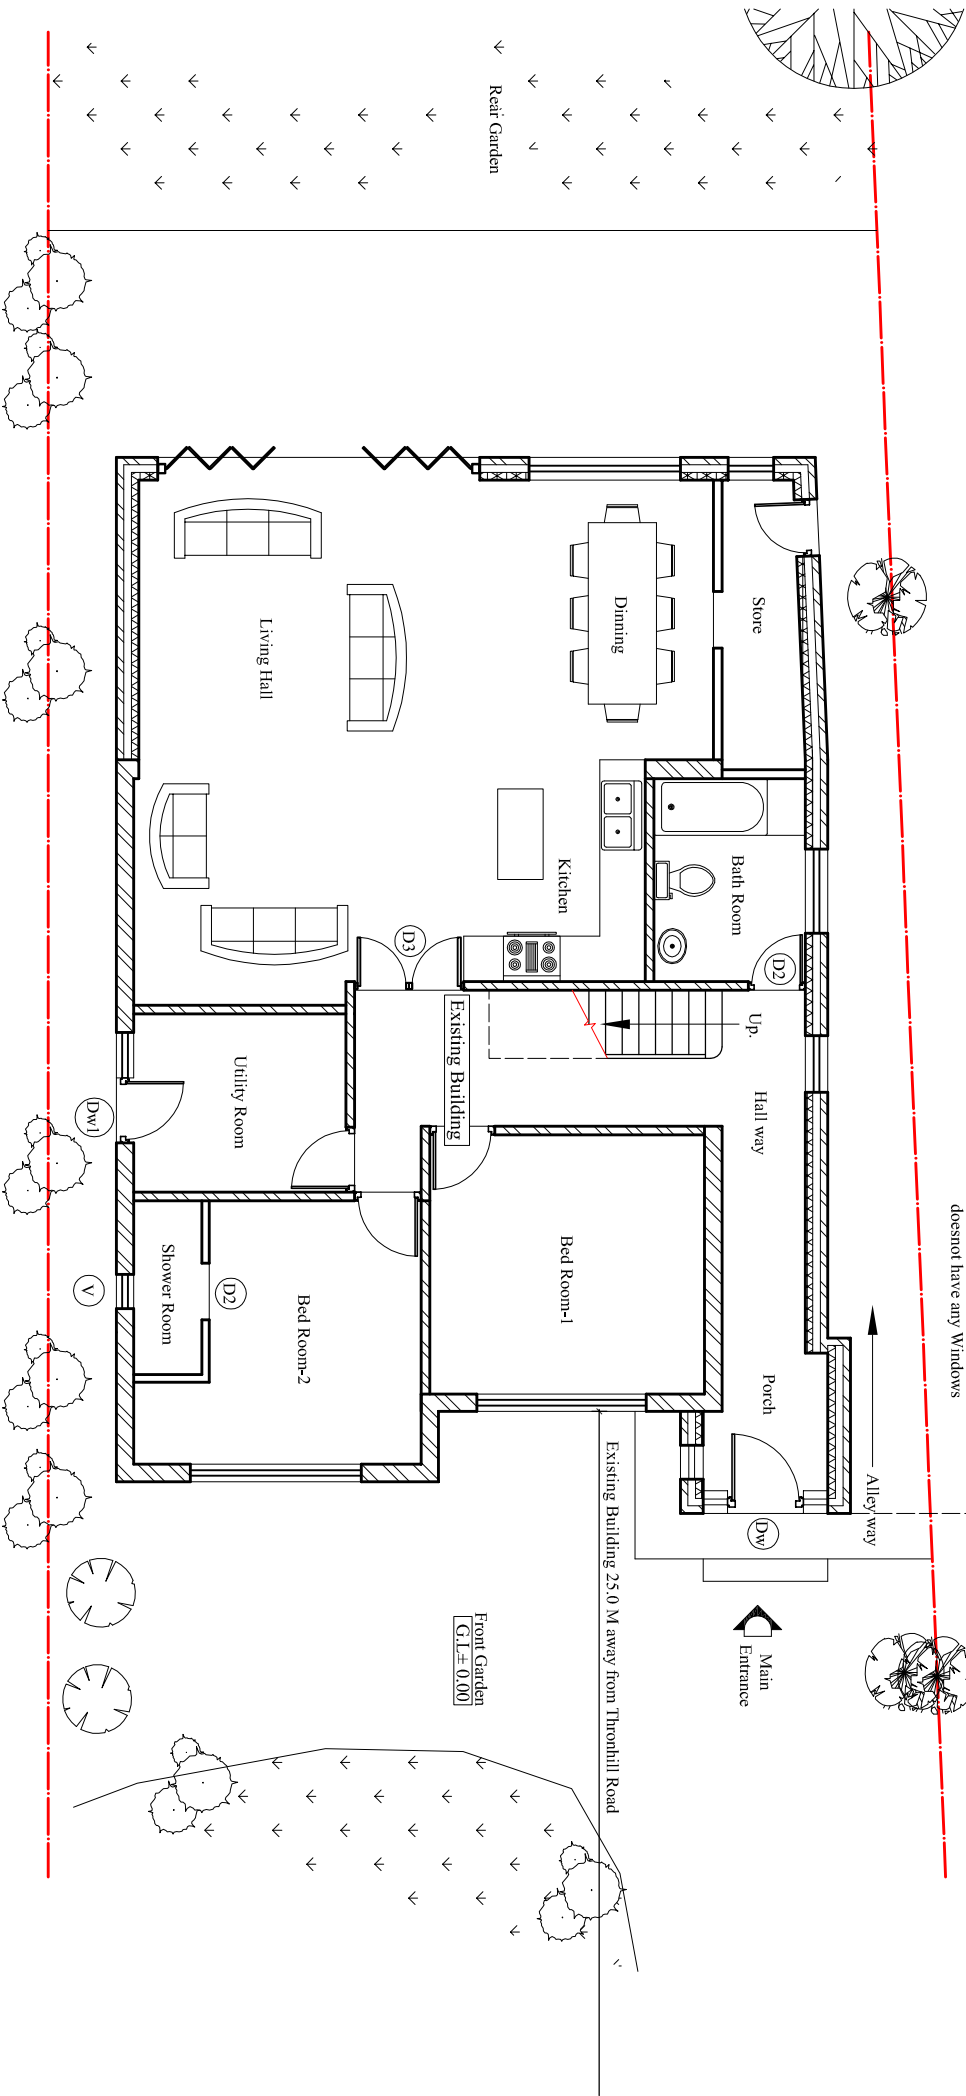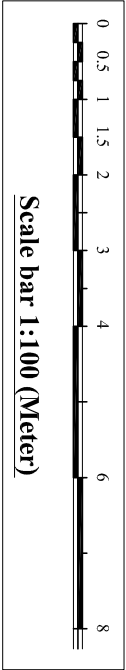

Existing Ground Floor Plan  
Scale:1:100